

Project Number: 1-14129.07

Mangawhai WWTP Balance Tank

17 September 2020

CONFIDENTIAL



Concept Design



Contact Details

Eros Foschieri

WSP
Mansfield Terrace Service Lane
125A Bank Street
PO Box 553
Whangarei 0140
+64 9 430 1700
021447553
eros.foschieri@wsp.com

Document Details:

Date: 17-09-2020
Reference: 1-14129.08
Status: Final

Prepared by
Andrew Springer, Thomas Lewis




Reviewed by
Eros Foschieri



Approved for release by
Eros Foschieri



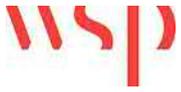


Document History and Status

Revision	Date	Author	Reviewed by	Approved by	Status
1	30-07-20	Andrew Springer	Eros Foschieri	Eros Foschieri	Draft 1
2	17-09-20	Andrew Springer	Eros Foschieri	Eros Foschieri	Final

Revision Details

Revision	Details
1	Released for client discussion
2	Amended costing after meeting with Thomas Lewis and Andrew Springer Amended programme following BC preparation

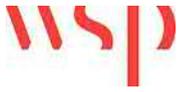

Contents

Disclaimers and Limitations.....	1
1 Background.....	2
2 Previous information.....	2
3 Site Visit.....	3
4 Design.....	3
4.1 Pump Station Upgrade	4
4.2 Inlet works.....	4
4.3 Balance Tank	5
4.4 Other Modifications	7
5 Construction Staging.....	7
6 Costing.....	9
7 Project Risks.....	10

List of Figures

Figure 1 - Proposed Works, Layout Plan.....	3
Figure 2 - Flow Diagram for proposed works.....	3
Figure 3 - Relocated Screen.....	4
Figure 4 - Balance Tank, isometric view (internal baffle not included in the final output)	7

List of Tables

Table 1 - Critical Structural Information	6
Table 2- Preliminary Project Programme	9
Table 3 - Rough Order of Cost.....	10

Disclaimers and Limitations

This report (**'Report'**) has been prepared by WSP exclusively for Kaipara District Council (**'Client'**) in relation to Mangawhai Waste Water Treatment Plant (WWTP) Concept Design (**'Purpose'**) and in accordance with the offer of service dated 17 June 2020. The findings in this Report are based on and are subject to the assumptions specified in the Report. WSP accepts no liability whatsoever for any reliance on or use of this Report, in whole or in part, for any use or purpose other than the Purpose or any use or reliance on the Report by any third party.

In preparing the Report, WSP has relied upon data, surveys, analyses, designs, plans and other information (**'Client Data'**) provided by or on behalf of the Client. Except as otherwise stated in the Report, WSP has not verified the accuracy or completeness of the Client Data. To the extent that the statements, opinions, facts, information, conclusions and/or recommendations in this Report are based in whole or part on the Client Data, those conclusions are contingent upon the accuracy and completeness of the Client Data. WSP will not be liable in relation to incorrect conclusions or findings in the Report should any Client Data be incorrect or have been concealed, withheld, misrepresented or otherwise not fully disclosed to WSP.

1 Background

The Mangawhai CWWTP was completed in 2010 to treat the wastewater from the community of Mangawhai and Mangawhai Heads. This has produced a high-quality effluent since construction and has resulted in the Harbour Waters achieving a healthy, clean condition. When the plant was first connected 1250 properties were connected to the system. Today that number is over 2000, with 3000 expected before 2030.

At the recent workshop regarding Mangawhai community wastewater scheme, it was identified that there are a number of catchment flooding issues that are occurring. These have been identified as Jack Boyd Drive PS (PS-K) and Outfall PS. At the former there are overflows of untreated wastewater, whereas at the latter, the emergency storage is being used in wet weather conditions, with the potential to spill to harbour. Confirmation is required on whether this is permitted under the resource consents.

The Mangawhai area is experiencing rapid growth, with a prediction of 3 x current population by 2043. This means that a number of wastewater assets, particularly to the North of the catchment, including Jack Boyd Drive PS, will require upgrade. The impact of growth is being modelled to determine a plan of upgrades, but a fully calibrated model is not expected until 2021.

The scale of these upgrades and necessary capacity are currently unknown and not in the anticipated budget. To reduce the impact and frequency of spills in the immediate term, it is proposed that the pumps at Outfall PS are updated to pass 100 l/s from their current 70 l/s. As the CWWTP is unable to treat more than 70 l/s, being restricted in the CASS decant system, and transfer to farm effluent pump main, it is proposed to take and store the excess flow for a period to the treatment works to reduce pressure on the network.

All future scenarios for the CWWTP require additional reactors for treatment. Therefore, it was considered at the workshop that a new balance tank shall have the same dimensions and be suitable for repurposing as a reactor in the future.

Controls will also be required to prevent overflowing of the balance tank that will, when full, limit flow from Outfall PS to a sustainable 70 l/s. This approach will enable more flow from Outfall PS to be passed at peak wet weather events, and potentially allow an increase in pass forward flow from Jack Boyd Drive PS to reduce flooding risk. After network modelling is complete and future flows understood, the full CWWTP upgrade can be implemented with a new resource consent for discharge that can manage all flows. This will then enable upgrades as needed to the wastewater network. However, this is anticipated to only be available in 2028. This proposed upgrade will provide an immediate fix to the catchment flooding by provision of future proofed assets.

This document outlines the proposed works including sketches, high level cost (for budgeting purpose) construction programme, and the reasons for the design selected to support the KDC business case.

2 Previous information

The following documentation has been provided by KDC and used as the basis for this report:

- General Drawing Arrangements
- Geotechnical Investigation (2013)

The documentation is provided in Appendix A

3 Site Visit

A site visit was performed by WSP Engineer Eros Foschieri on the 02 July 2020. The visit included only for a visual assessment of the site.

Photos of the site visit are included in Appendix B of this report.

4 Design

The proposed works are shown on the layout plan below and include for:

- Outfall Pump Station Upgrade
- Inlet Works
- Balance Tank
- Other modifications- odour, tank wash water



Figure 1 - Proposed Works, Layout Plan

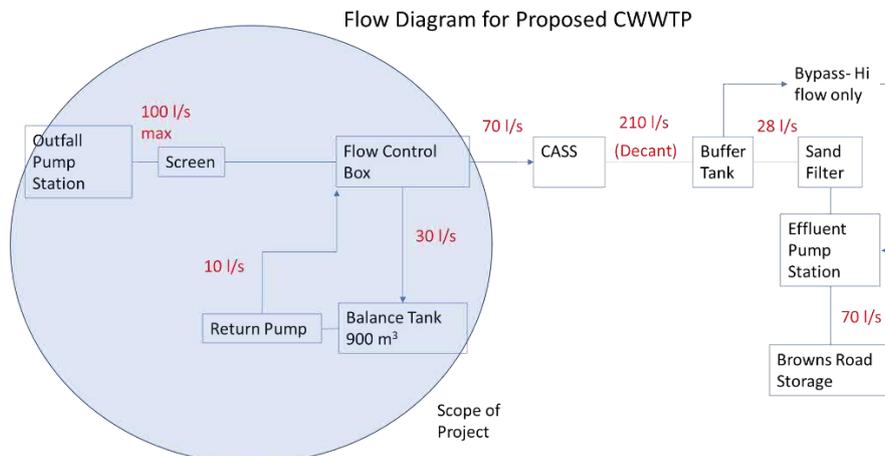


Figure 2 - Flow Diagram for proposed works

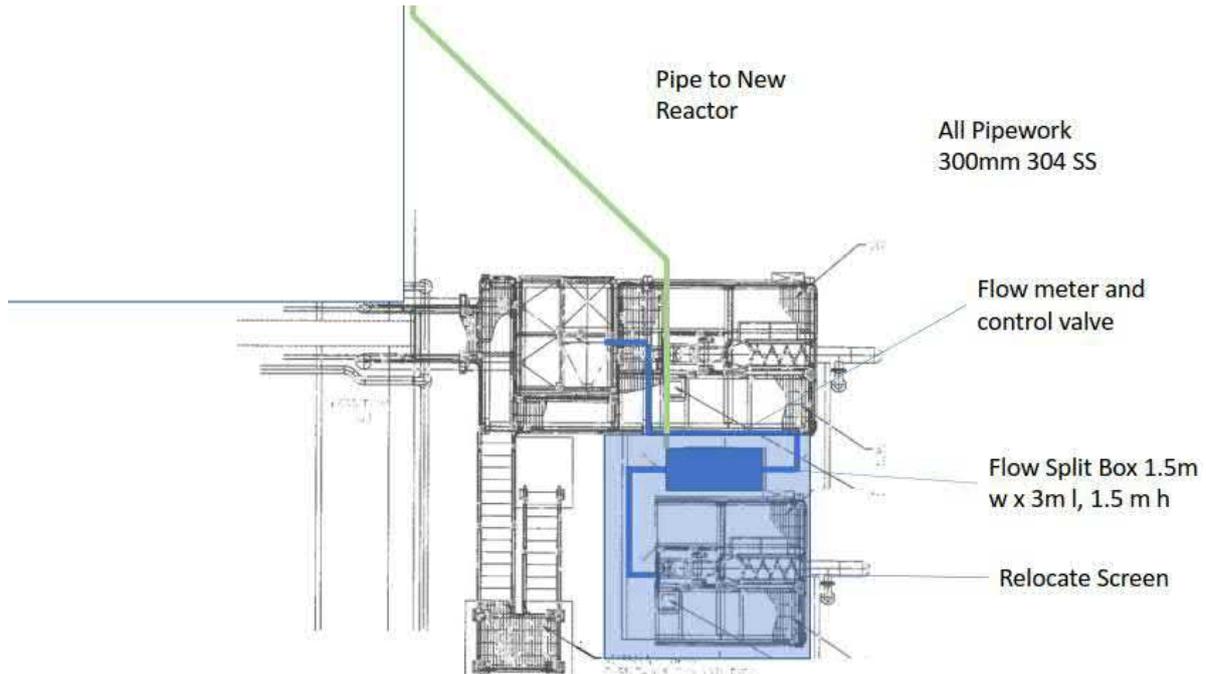


Figure 3 - Relocated Screen

4.1 Pump Station Upgrade

It is understood from Broadspectrum that larger pumps can be installed in the Outfall PS with only minor modifications to the controls. 2 New transfer pumps for 100 l/s will be required.

4.2 Inlet works

The inlet screen is suitable for 100 l/s. currently it also takes the return site water at about 10 l/s, which will mean that at peak flows the capacity of the screen may be exceeded and the manual bypass used for some a small proportion of the flow. This requires operator intervention after a storm event.

An alternative is to divert the return flow to the flow splitter box so lowering the flow at the screen. This has not been included in the cost estimate and it will be discussed with KDC at the detailed design stage.

The hydraulic calculation (summarised in Appendix C) confirmed that the current gradient is not sufficient to accommodate the proposed flow split. Additional head will be achieved by raising the screen by 600mm from its current elevation.

The raising of the screen is a complex activity if in the current location and would most likely require the inlet to be out of operation for over 12 hours. This is deemed to be impractical as even in dry weather, over 600 m³/d arrives at the treatment works.

It is therefore intended to extend the steel structure over the skip area. This will integrate to the existing structure, reducing total steel required, with new support legs over the skip. By being at a higher level, this enables screenings to drop into the skip below.

The storm splitter box will be located next to the screen at a lower level and consists of a stainless-steel box with weir. The overflow from the weir will gravitate to the new balance tank through a 300mm pipe.

The pass forward flow will be controlled after the splitter by a flow meter and actuated gate valve arrangement. A minimum straight pipe length is required of 3 m for this to operate. Flow will reconnect to the base of the current flow splitter.

Odour can be generated at the inlet works at the screen, flow splitter and overflow chamber. A new activated carbon odour filter will be installed near the inlet works to extract and cleanse the air to prevent customer nuisance. This will require periodic replacement of the carbon, every 1-2 years.

To relocate the screen, it is necessary to modify the inlet pipework and relocate the flow meter. As this pipe is flanged connections, it is relatively straightforward.

It is recognised that the changeover of the screen might be a complex process and will involve electrical disconnection, recabling, disconnection of incoming pipe, removing pipework from the structure, refitting new pipework, relocating the screen and recommissioning. The challenge for this activity is the time and capacity of storage at the outfall pumpstation. It has been assumed that in dry conditions 6 hours is available before flow must be turned, but if the activity will take longer, or storage is less, an alternative approach will be used. The alternative is to purchase a second screen, making the current screen redundant. The current screen is expected to have only 4 years of asset life remaining and may require replacement before the next upgrade in 2028. This alternative simplifies the changes required to be made, and consists of 2 pipe connections, with all other pipework being preinstalled.

4.3 Balance Tank

The proposed tank is a precast concrete tank of the same dimensions as a current reactor. This means that once the future configuration of the plant is decided and future flows predicted by the catchment modelling, this tank can either remain as a balance tank or be easily modified to be a treatment reactor.

The edge of the site has a drainage ditch which will require diversion or culvert for approximately 30m, which can be undertaken when the earthworks for the tank are made.

The geotechnical desktop review shows no significant hazards that will warrant extensive foundation works and construction may therefore be similar to the existing tank. Geotechnical investigations will be required to be confirm as part of the detailed design.

The tank shall have no internal baffles as these will lead to poor cleaning of the balance tank. It shall have a central floor channel draining to a sump at the far end. This enables incoming flows to assist in flushing solids from the inlet to the return pumps for removal. A hydrant will be provided on an access platform at the inlet to assist in operational cleaning after use.

The tank will usually be empty, but will fill in storm conditions. This will be automatically emptied by a duty/standby dry mounted submersible pump located at the end of the tank. This is similar to the RAS pumps on the existing tank. The return flow will be discharged to the storm split box, but only operate when the inlet flow meter reads low or no-low. By automatically emptying the tank, wastewater does not have the opportunity to go septic and generate odours. Periodic manual cleaning will also assist in the management of odours.

4.3.1 Geotechnical Consideration

The desktop geotechnical study is attached in Appendix D of this report and included for the following:

- *Desktop review of the geotechnical investigation report for the existing plant and its relevance*
- *Compliance with the latest building code;*
- *Provide assessments on of potential geohazard and constraints for the proposed development;*
- *Should it be needed, propose the required geotechnical investigation; and,*
- *Preparation of this Stage 1 Preliminary Geotechnical Appraisal Report.*

We consider that the site is generally suitable for the proposed development of another balance tank. However, the presence of soft silty clay deposits which were recorded by the historical CPT at shallow depth should be considered as part of the due diligence process.

Therefore, for the proposed future developments, at least another three CPTs are required to be placed to refusal with two of them within the footprint of the new proposed tanks structure with another one to the northwest of the existing intermediate storage tank.

These new CPT readings together with the historical boreholes from Tonkin & Taylor will be used to develop for a new geological model which runs from northeast to southwest direction. As we were unable to obtain these historical CPT data readings for our processing, the new CPT data will be used to assess the liquefaction potential for the new development.

4.3.2 Structural Consideration

The shape and dimension of the tank are the same as the existing CASS reactor, so this can be utilized in the future as a potential reactor. The initial reinforcement detail and the wall thicknesses have been calculated as part of this concept design. The calculations and assumptions are summarised in Appendix E. An isometric view of the tank is shown below.

The balance tank is rectangular (approximately 24m x 8m x 6m) with several internal baffle walls. The longer perimeter walls have thicknesses of 450 mm while the shorter perimeter walls have thicknesses of 350 mm. The internal walls and the base slab are 200 mm thick.

The longer perimeter walls were designed as free-standing cantilevers while the shorter perimeter walls were assumed to be two-way spanning.

Critical structural information is shown in the table below.

Table 1 - Critical Structural Information

Item	Value
Importance Level	3
Design Life	100 years
Soil Classification	C
Ground Bearing Capacity	300kPa (ULS)
Concrete Grade	40/50 MPa
Reinforcement Grade	500MPa

The shape and dimension of the tank are the same of the existing CASS reactor, so this can be utilized in the future as a potential reactor. The initial rebars detail and the thickness of the walls have been calculated as part of this concept design. The calculations and assumptions are summarised in Appendix E. An isometric view of the tank is shown below.

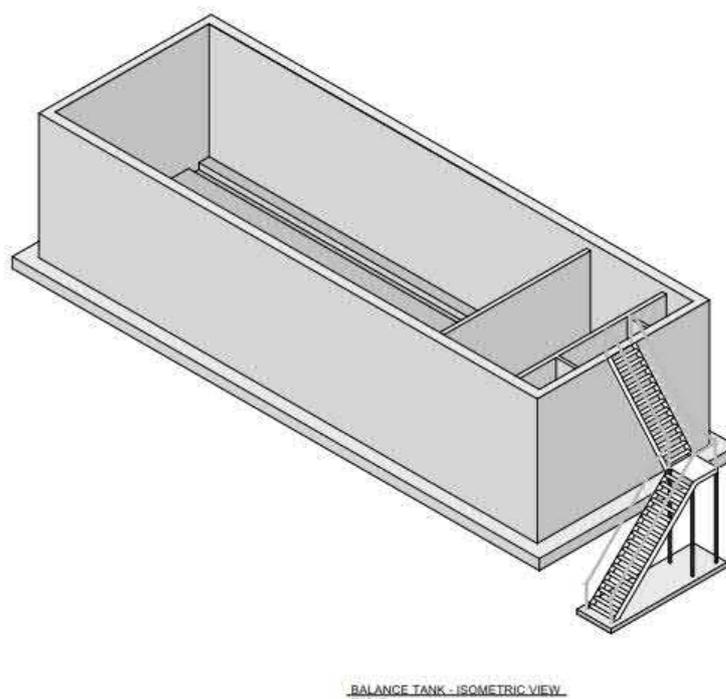


Figure 4 - Balance Tank, isometric view (internal baffle not included in the final output)

4.4 Other Modifications

As identified above the CWWTP does not have the capacity to treat more than 70 l/s. This means that when the balance tank is full, it is necessary to communicate to the Outfall pump station to slow the pumps down to only deliver 70 l/s. If this does not occur, the balance system will fill with water and more flow will pass to the treatment process, eventually resulting in overflow of downstream processes. A communication system will be developed to link these systems.

The skip for screening material is currently to one side of the inlet works structure. It is proposed, with the raising of the screen to put the skip under the screen. Some slab and drainage modifications may be required.

5 Construction Staging

The construction of this system needs to be planned to ensure that wastewater can enter the plant and continue being treated. It is anticipated that the storage at the outfall pump station may be used and this will at night enabling up to 6 hours in dry conditions with no flow to the treatment works when invasive work is undertaken. Most construction will require no interruption of the operation of the existing works.

- Stage 1.
 - Finalise contractor design elements, shop drawings
 - Procurement of panels, steel work, m&e equipment
 - Lodge consents required for construction.
 - Install new odour filter adjacent to inlet works. Use temporary connections.
 - Isolate and Remove odour bed as on site of new tank.
- Stage 2.
 - Prepare groundworks for new balance tank.

- Provide new drain and site fence. May be a temporary fence depending on construction techniques and area required.
- Temporary connection of odour plant to existing inlet.
- Stage 3.
 - Preparation of tank foundation
 - Install Tank base
- Stage 4
 - Construct balance tank walls and seal base edges
 - Install Stair access.
- Stage 5.
 - While testing water tightness of balance tank (approx. 2 weeks) install return pumps and pipework
- Stage 6
 - Install new inlet structure
 - Fabricate overflow weir box and pipework
 - Install pipework as far as possible including flow meter, valves and pipe to balance tank.
- Stage 7.- Screen relocation

This stage requires a coordinated inlet shut down and adequate personnel and equipment to make the required changes in a limited time window.

 - Stop flow.
 - Disconnect electrical connections
 - Unbolt screen at flanges and remove redundant pipework
 - Install screen and connect to preinstalled pipework.
 - Repower screen
 - Return flow to inlet works.
- Stage 8
 - Commission flow control
 - Commission feedback control to outfall pump station.
- Stage 9
 - Replace pumps at Outfall PS.
- Stage 10.
 - Wait for rain to confirm operation. It is recommended that site is attended on first storm event to confirm operation is correct.

A preliminary overall project programme is presented below. The following assumption have been made in the preparation of the programme:

- The tender period has a two-week shut down for the contractors over the Christmas period. Actual tender time available is therefore 5 weeks.
- Construction period includes for Earthworks, procurement and manufacture of precast concrete and steel sections, installation, testing and commissioning.
- No time delays due to weather are allowed in costs. 2 weeks of delays are included in the programme.

- Procurement of precast tanks is less than 8 weeks from start of contract
- Procurement of structural steel is 8 weeks from start of contract
- No contingency is allowed in the programme.

Table 2- Preliminary Project Programme

Key Milestones	Forecast Date	Responsibility
<i>KDC project approval</i>	<i>30 September</i>	<i>KDC</i>
<i>Detail Design Delivery</i>	<i>16 December</i>	<i>Consultant</i>
<i>Contract Document completion</i>	<i>16 December</i>	<i>Consultant</i>
<i>Detail Design Review</i>	<i>16 December</i>	<i>KDC</i>
<i>Tender issue</i>	<i>21 December</i>	<i>KDC</i>
<i>Contract Award</i>	<i>22 March 21</i>	<i>KDC</i>
<i>Construction Completion</i>	<i>23 August 21</i>	<i>Contractor</i>
<i>Commissioning Completion</i>	<i>13 Sept 21</i>	<i>Contractor</i>

6 Costing

A rough order of costs (ROC) has been prepared based on the concept presented in this report. As shown in Table 2 below. A detailed summary is also provided in Appendix F. The ROC is derived from a schedule of standard rates, typical NZ construction costs and supplier information. Assumptions for programme and project cost estimates include:

- No significant geotechnical issues and construction is similar to existing assets.
- The existing screen can be relocated without damage within the time frame available. A risk item included in the risk register
- Outfall pump station pump replacement is a similar pump to existing and no other pump or pipe modifications are required.
- Current on site MCC, PLC, telemetry and SCADA have sufficient capacity for the additional functions (2 additional 5 kW drives, 1 flow meter, level instrument, actuated drive and remote link control system)
- No power upgrade to site is required.
- Bank will be reduced to level ground to 10 m from the balance tank.
- 50m of site fencing will be provided
- Drain channel at the current fence line will be replaced with 400 mm concrete pipe, buried to the side of the new balance tank.
- Sufficient wash water is available on site for tank cleaning.
- Additional consents will be obtained by the contractor with no delays.
- Rates selected for walls at Structures estimate based on area
- Assumed 10% of cast concrete volume is Steel weight
- Odour plant Cost assumed from similar projects for green dome with integral fan. Supplier price not received
- Assumed \$15,000 of physical geotechnical investigation in design fees
- Assumed for shallow foundation, not piling
- Not allowed for a PS2 in design fees
- Access assumed via 1 staircase at the southern end - no allowance for rail on the perimeter of the tank
- No allowance in the fee for training of the operator after construction
- Assumed no retaining wall on the hill side will be required

Table 3 - Rough Order of Cost

Mangawhai WWTP		
Item	Description	Total
1	Preliminary and General	\$ 275,156.83
2	Earthworks and Clearing	\$ 82,470.00
3	Drainage	\$ 16,550.00
4	Structures	\$ 912,076.00
5	Landscaping & Entrances	\$ 15,750.00
6	Piping, Pumps and Filtration	\$ 144,338.13
7	Extraordinary Construction Costs	\$ 25,600.00
8	Electrical	\$ 154,000.00
9	Fees	\$ 195,075.28
	Total	\$ 1,821,016.23
	15% contingency	\$ 273,152.43
	Final Estimate	\$ 2,094,168.66

7 Project Risks

A number of key project risks have been identified at this early stage of the project and approach to minimise impact has been proposed as outlined in the risk register provided in Appendix G. Below we provided a list of the most significant risks:

- Geotechnical conditions.**
Ground conditions were identified in the previous geotechnical report as being inconsistent across the site. This could lead to the need for unbudgeted remediation or changes in design. Mitigation is provided by undertaking additional Geotechnical testing in the areas of construction to confirm local conditions.
- Bank stability.**
To build the new balance tank it is necessary to partially cut back the existing bank immediately outside of the site. Additional cost and time may be incurred if this bank is unstable and remediation is required. To mitigate this risk, the bank shall be assessed as part of the geotechnical studies
- Inlet screen.**
It is assumed that the existing inlet screen (11 years old) is in good condition and can be readily disconnected, moved and reconnected. Due to asset age it is expected to be serviceable for approximately 5 more years, and should be replaced when the next inlet upgrade is completed. The risk is that the screen is damaged during the transfer, or cannot be readily disconnected and reinstalled in the time window available for shutdown of the inlet flow. This will be looked at in detail in the design stage. These risks can be mitigated by the purchase of a new screen. This can be installed from new into the required location, with most of the pipework and commissioned while the existing screen is in use. This reduces risk of failure, damage, or delays. A new screen is estimated at \$60,000.
- Capital funding.**
It is understood that there is a budget of \$1.8m available for this financial year. The capital estimate, with no contingency is at this value, however, if risks are realised, the project budget may be exceeded. KDC are to consider how this may be managed. One consideration is that construction and commissioning are expected to pass into the 2021/2 financial year.
- Odour.**

To enable construction the existing odour system must be removed and a new odour unit installed. This will result in a period with no odour management on the inlet. The new unit will be connected to new pipework to the new location of screen and flow control box, with the current flow split. It is assumed at this time that the odour filter can be installed adjacent to the inlet works and if, required can be connected with temporary flexi hose. The preliminary programme shows that this change over may occur in April, so the risk of customer complaints is lower than in peak summer.


- **Tank cleaning.**

It is assumed that the balance tank will only be used occasionally, and that with the fall on the floor to a sump, manual cleaning of the tank using site washwater (effluent) can be undertaken. A platform is provided at the tank inlet for this purpose. Cleaning is necessary to prevent odour generation. However, if there is insufficient water volume and pressure for this activity additional improvements will be required. These may include increased water pressure booster, additional access and wash hoses, or in tank cleaning systems. The water pressure shall be assessed in design.

- **Catchment flooding.**

The intention of the balance tank is to enable at peak storm flows to pass more flow to the CWWTP and temporarily store the water until after the storm event. This will provide additional buffer capacity to the network compared to the current configuration. However, no modelling of the network has been undertaken yet (currently underway and estimated completion is within a year time) thus the size of the tank has been purely based on the capacity of this to be reused in the future as additional CASS tank (like for like of the existing tanks).

Should a greater flow be required to be passed forward in the short term, a second balance tank may be required

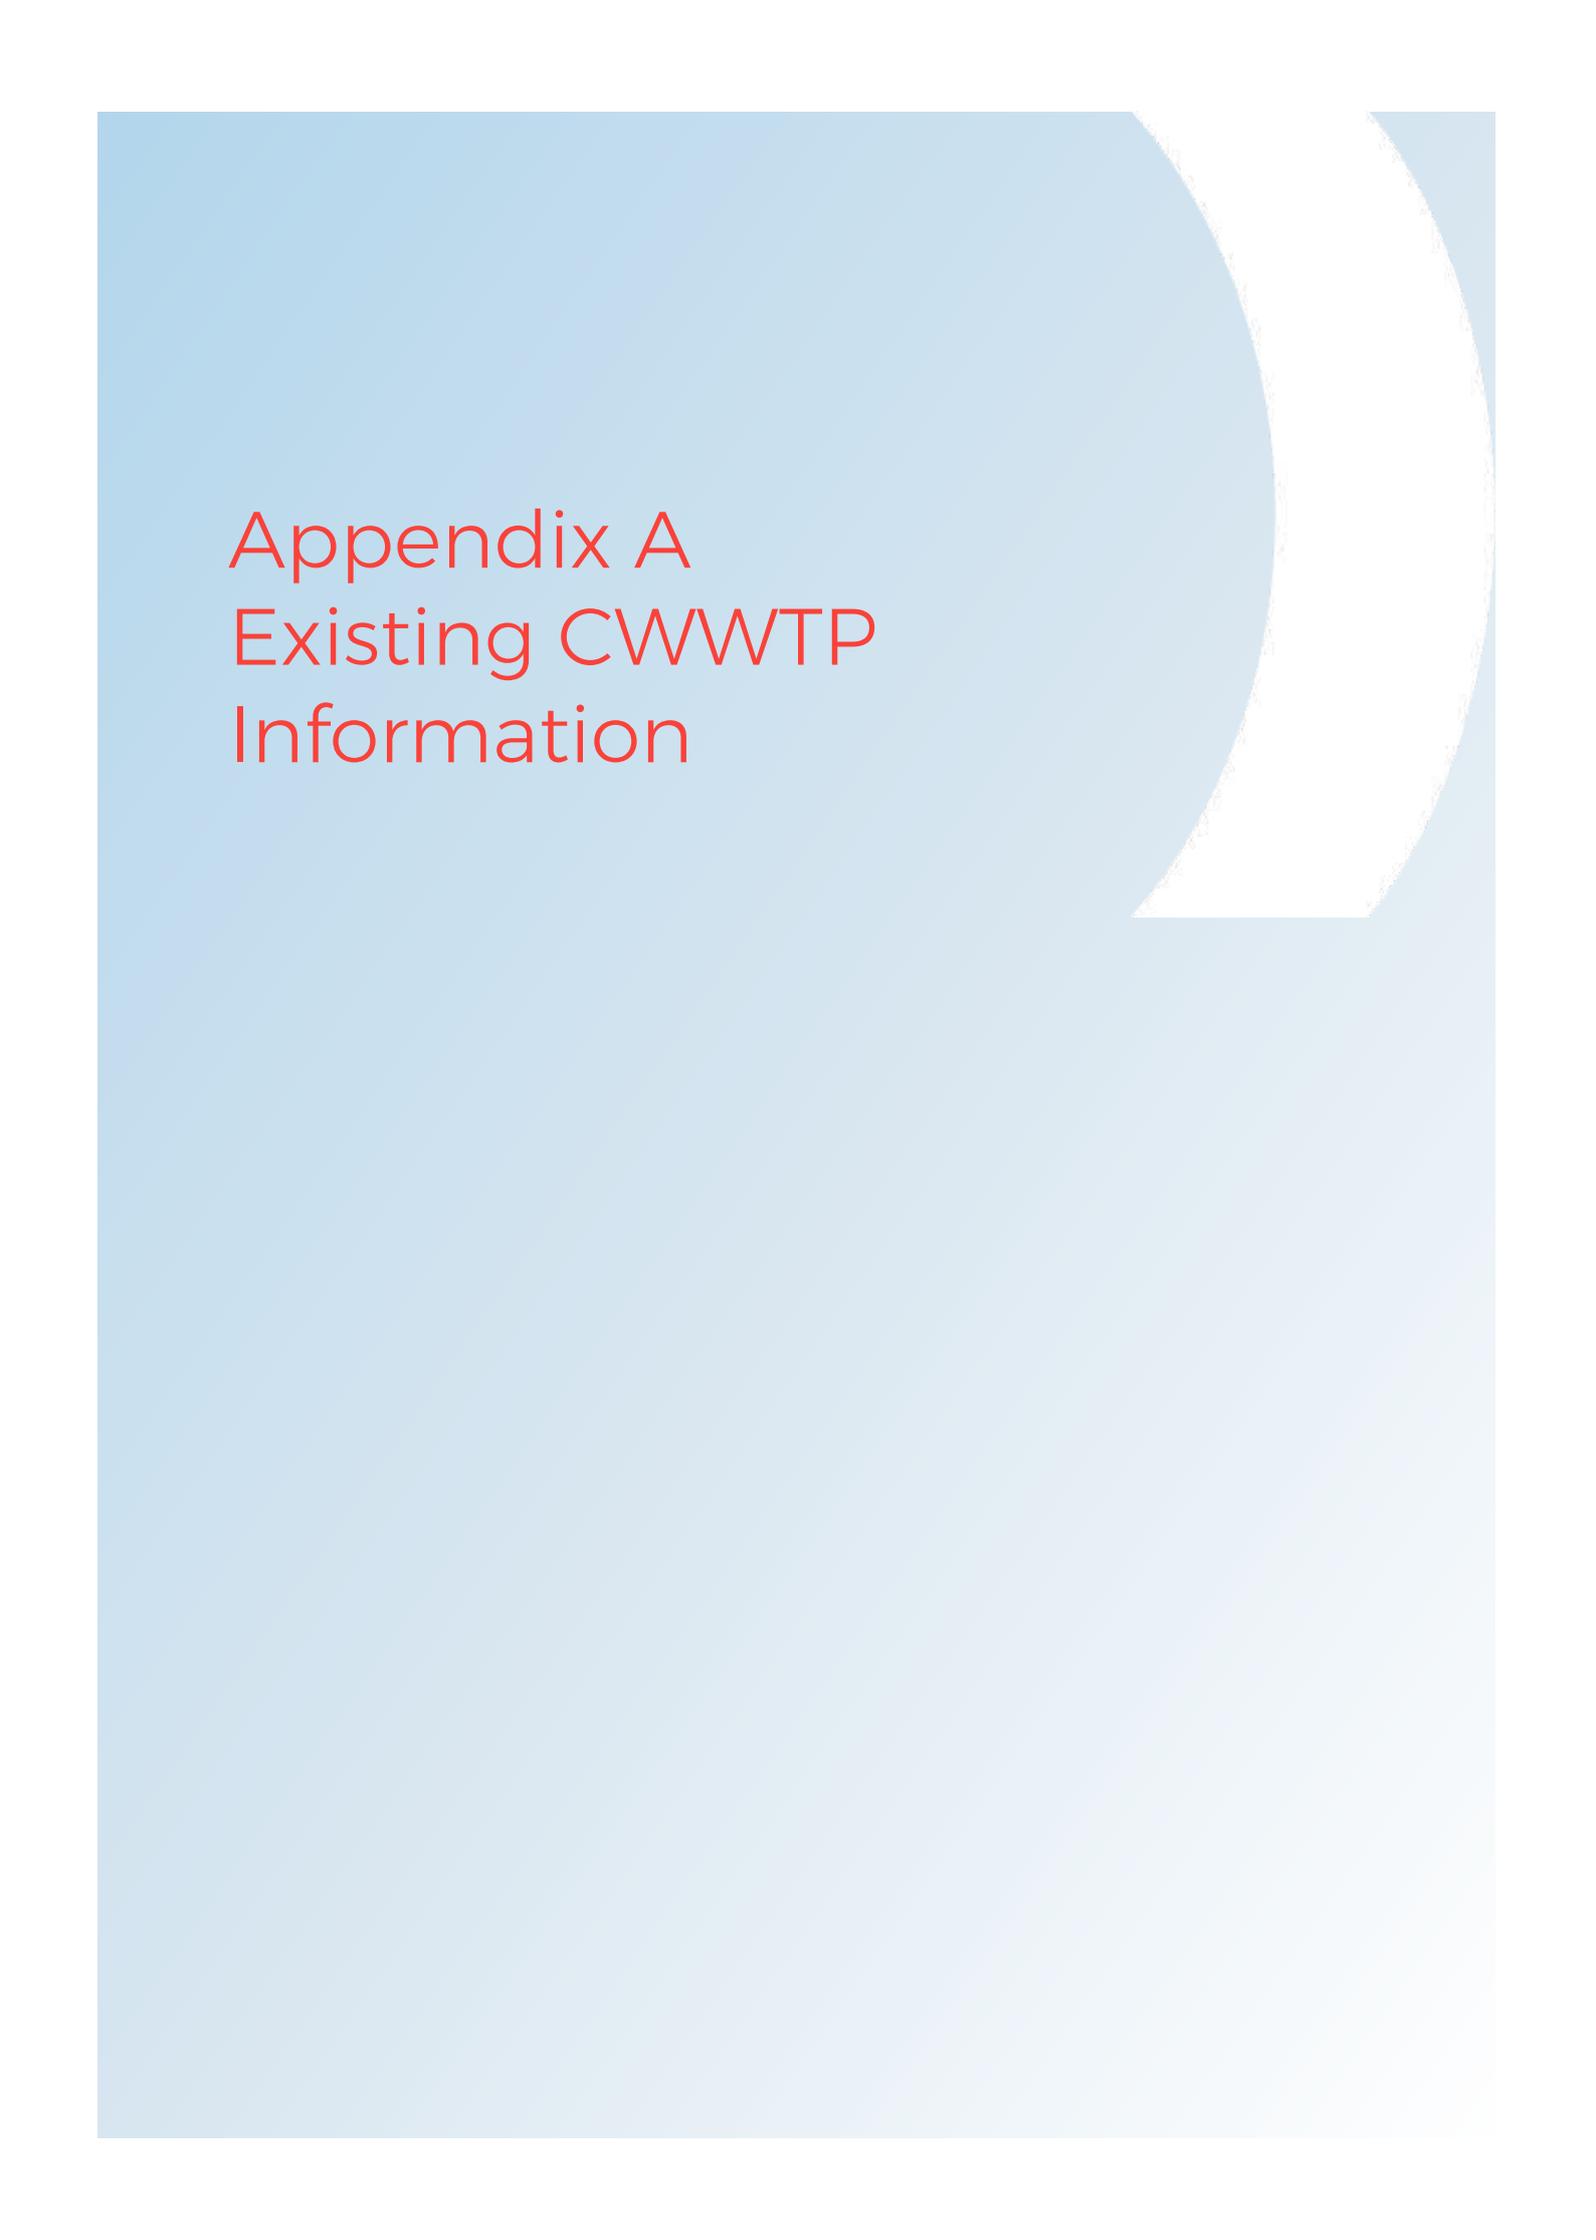

Appendix A Existing CWWTP Information

REPORT

EARTH TECH CONSTRUCTION PTY LTD

**Mangawai Waste Water
Treatment Plant
Geotechnical Investigation
Report**

Report prepared for:
EARTH TECH CONSTRUCTION PTY LTD

Report prepared by:
TONKIN & TAYLOR LTD

Distribution:
EARTH TECH CONSTRUCTION PTY LTD
TONKIN & TAYLOR LTD (FILE)

4 copies

1 copy

June 2006

Job no: 23428.001

Auckland, New Zealand
105 Carlton Gore Road, Newmarket
PO Box 5271, Wellesley Street
Tel: 64-9-355-6000
Fax: 64-9-307-0265
email: auck@tonkin.co.nz
website: www.tonkin.co.nz

Table of contents

1	Introduction	1
2	Site conditions	1
3	Geological conditions	1
4	Proposed development	1
5	Field Investigation	2
6	Subsurface conditions	2
	6.1 General	2
	6.2 Groundwater	3
7	Geotechnical issues and recommendations	3
	7.1 General	3
	7.2 Foundation Options	3
	7.3 Settlement	4
	7.4 Ground retention and temporary excavations	4
	7.5 Pavements	5
	7.6 Earthworks	5
	7.7 Liquefaction	6
	7.8 Site seismic category	6
8	Conclusions	7
9	Applicability	8
10	References	i
	Appendix A: Site plan & Geological Section	
	Appendix B: Borehole Logs	
	Appendix C: CPT Logs	

1 Introduction

Tonkin & Taylor Ltd (T&T) were engaged by Earth Tech Construction Pty Ltd to undertake a geotechnical investigation for a proposed waste water treatment plant. The treatment plant is proposed as part of a wider scheme to install a reticulated waste water system for the Mangawhai Heads and Mangawhai Village areas.

T&T have also undertaken a geotechnical investigation for the reticulation and pump station portion of the project and preliminary geotechnical reporting on several proposed disposal sites.

2 Site conditions

The site of the proposed treatment plant is located northeast of Thelma Road immediately southwest of the Mangawhai Heads Golf Club. Access to the site is obtained off Thelma Road. The location for the proposed treatment plant is shown on drawing 23428.001-01 in Appendix A of the report.

The site is currently covered in a variety of regenerating native and exotic vegetation including pine trees, punga and ferns. The site is typically gently sloping with some moderately sloping undulations. The site is wet in lower lying areas with surface water present over parts of the site.

3 Geological conditions

The published geology for the area, New Zealand Geological Survey - Whangarei (Scale 1:250,000, ref 1) indicates that the site is underlain by Quaternary aged fixed dune sands.

4 Proposed development

We understand the proposed treatment plant consists of 5 main structures. These include:

- 3 CASS concrete rectangular tanks which measure approximately 20 m by 7 m. The internal wall of each tank is shared to give an overall footprint of 20 m by 21 m. The tanks are 5 m in height and are set 1 m into the ground. These tanks are proposed to be located in the north east corner of the site where BH2 was drilled.
- A sludge thickening concrete tank measuring 13 m in diameter and 5 m high located immediately to the west of the CASS tanks and just south of the NW piezometer (PZ2). Foundation preparation for this tank may include minor cut to fill earthworks to level the immediate area.
- A belt press building situated south of the sludge thickening tank. We understand this building is to be founded on a concrete slab and is approximately 13 m by 6 m in size.
- A steel hoop tank supporting an internal bladder of 18 m diameter. We understand the tank is up to 6 m high and sits on a concrete ring footing. The tank is proposed to be located in the southwestern corner of the site.
- A main control building for the site contains offices, a switchroom and blower room. This building is to be of flexi-clad construction on a concrete slab with

dimensions of 20 m by 9m. We understand it is to be located 6 m south of the CASS tanks and the 20 m side is to run parallel to the 20 m side of the CASS tanks.

5 Field Investigation

The field investigation was undertaken from 15 - 17 May 2006. It comprised four boreholes (BH1-4) with Standard Penetration Tests (SPTs) undertaken at regular intervals. The boreholes extended to between 7 m and 10 m depth. Two standpipe piezometers were installed to monitor the long term water level across the site (PZ2 & PZ3). The piezometers were installed in BH2 and BH3 to 9 m depth, with the bottom 2 - 3 m screened and the upper 6 m sealed with bentonite.

Five Cone Penetrometer Tests (CPT1-5) were also undertaken across the site. These were put down to between 10 m and 15 m depth. The locations of the boreholes, CPT's & piezometers are shown on drawing 23428.001-01 in Appendix A of the report.

6 Subsurface conditions

6.1 General

The geotechnical investigations undertaken at the site encountered a variety of materials and have generally confirmed conditions described in the Geological Map (Ref 1). As expected, much of the area is underlain by quaternary sand deposits with the northern portion of the site (BH4) encountering old estuarine silts and sands.

The materials encountered in the recent investigations are generally described as follows:

Topsoil

This included organic and humic debris and sandy silt. The topsoil was generally dark brown, wet to saturated and varied in thickness from 0.1 m to a maximum thickness of 0.5 m (BH4).

Quaternary sands

Quaternary sands were encountered over much of the site and to considerable depth. The sands were often silty, orange brown with occasional sandy silt lenses. The sands were typically loose to medium dense with SPT values ranging from 5 to 21. The sands were typically loose near the surface becoming denser with depth. We expect the sands are old dune deposits. These sand deposits are widespread over the Mangawhai area.

Estuarine and lacustrine deposits

Estuarine deposits encountered in BH4 included loose fine to medium grained sands and firm high plasticity silts and clays. SPT 'N' values ranged from 2 to 9 to 5 m depth becoming very dense at 6 m depth (SPT 'N' > 50). These materials are likely to have been deposited from a water body behind the dunes. The materials consist of clays and silts, and are soft to very stiff and generally highly plastic. Some organic material was present in the materials recovered, indicating that plant material was also deposited with the fine grained material. The estuarine deposits were mostly encountered in BH4, with BH1-3 almost consisting entirely of sandy material.

Bedrock was not encountered during the investigation; however we expect that Waitemata Group siltstones and sandstones are likely to underlie the above soils at depth.

6.2 Groundwater

During the investigation, saturated materials were encountered at between 5.4 (BH2) and 6.8 m (BH3 and BH4). Two piezometers were installed during the geotechnical investigation, in BH2 and BH3 respectively (PZ2 & PZ3).

Groundwater levels have been monitored and recorded following the investigation and are detailed in the following table.

Table 1: Ground water levels

Date	Ground Water Level (m)	
	PZ2	PZ3
07 June 2006	4.1	6.2
15 June 2006	4.5	6.6

We do not expect these levels to vary significantly from those in the table which were recorded following a prolonged wet period in early winter when groundwater levels would be expected to be high.

7 Geotechnical issues and recommendations

7.1 General

Recommendations and opinions contained in this report are based upon data from boreholes and CPT's and surface exposures. Inferences about the nature and continuity of subsoil away from the subsurface investigation sites are made but cannot be guaranteed.

The following geotechnical issues have been addressed as part of the report:

- foundation options
- settlement
- retaining wall parameters
- earthworks
- pavement design
- seismic category

7.2 Foundation Options

The loose to medium dense sands and firm to stiff silts encountered on the site are expected to be suitable for founding the proposed structures on shallow foundations. The structures can be founded on either shallow pad/strip footings or on a shallow raft foundation system. All foundations should extend to a minimum of 0.5 m depth and be founded below any topsoil or organic soils.

An allowance should be made for sub-excavation of any unsuitable material encountered near the surface. This is expected to comprise decomposing organic material and topsoil which is expected to be encountered between approximately 0.2 and 0.5 m depth.

Following excavation of each platform the exposed surface should be proof-rolled using a vibrating plate or smooth drum roller. This proof-rolling should be observed by a competent Engineer and any soft spots should be subexcavated and backfilled with compacted sand.

For foundations on the proof rolled subgrade surface, a geotechnical ultimate bearing capacity of 300kPa may be used for foundation design. This corresponds to factored (Ultimate Limit State) and allowable bearing capacities of 150kPa and 100kPa respectively.

Some minor cut to fill earthworks may be required on the site. Recommendations for the compaction of fill materials are provided in section 7.6 of the report.

7.3 Settlement

We understand that the proposed structures are to impose the following maximum applied floor loads (unfactored cyclical working loads):

- Three combined CASS concrete rectangular tanks - applied loading of 50 kPa
- Sludge thickening tank (concrete) being 13 m diameter and 5 m high - applied load of 50 kPa
- Belt press building of dimensions 13 m x 6 m - applied loading of 30 kPa
- Steel hoop tank supporting an internal bladder of 18 m diameter - applied loading of 60 kPa
- Main building (including offices, switchroom, blower room etc) founded on a concrete slab of 20 m x 9 m dimension - applied loading of 30 kPa.

The soils that underlie the site are typically sandy with moderate permeability. In areas where silts were encountered intermediate sand lenses are common with horizontal drainage paths being typically less than 2 m apart. Accordingly we expect that settlements at the site will generally occur over a short period following the application of the first full loading. Based on the above loadings, which we understand will be cyclical for some structures, we have completed a settlement analysis of the largest tank (CASS) which is located in an area where soft estuarine silts and sands were encountered (BH4). The analysis indicates that settlements of approximately 50 mm are expected. Differential settlements of less than 1:300 are expected which we understand are within normally accepted construction tolerances for these types of structures. This should be confirmed by the tank suppliers.

7.4 Ground retention and temporary excavations

Excavations of up to 1 m depth are likely to be undertaken for a number of the structures. In addition some minor cuts are likely to be required when forming the access road into the treatment plant. Table 2 below provides applicable retention design parameters.

Table 2: Retaining wall design parameters

Soil Type	Unit weight (kN/m ³)	Effective friction angle (degrees)	Effective cohesion (kPa)	Ko
Firm to Stiff Silts	18	28	0	0.53
Loose Sands	18	30	0	0.5
Medium Dense Sands	18	32	0	0.47

The design of retaining walls will need to incorporate the following (if appropriate)

- surcharge effects
- water pressures
- compaction pressures.

Retaining walls should be detailed to include a perforated drain behind the wall and a 200 mm thick clay cap to prevent surface water infiltrating behind the wall.

In other areas temporary and permanent batters may be utilised. The water table is relatively low (> 4m depth) at the site so batters and walls are likely to be above the ground water table. The stability of excavations and batters in sand (above the water table) will depend on the moisture content and density of the sands. Moist dense sands are likely to provide short term stability and stand sub-vertically. However, loose dry sands are likely to lie back to a more stable repose angle. The condition of the sand will need to be considered as excavation proceeds to prevent the risk of collapse. We recommend that excavations (less than 3 m depth) be generally battered back at 1V:1.5H in the short term and 1V: 2.5H in the long-term.

7.5 Pavements

We understand that an access road will be constructed from Thelma Road entering the site from the southwest. The road will be 4 m wide and will cater for 15t trucks and domestic vehicles.

All topsoil and loose materials should be excavated prior to pavement construction and the exposed subgrade proofrolled with a vibrating smooth drum roller. This proof-rolling should be observed by a competent Engineer and any soft spots should be subexcavated and backfilled with compacted fill. We recommend that pavements founded in the natural silt and sandy soils on the site be designed assuming a subgrade CBR of 4.

7.6 Earthworks

Some minor cut to fill earthworks may be undertaken to level the building site and form the accessway. We recommend that fill materials be compacted to engineering standards in accordance with the specifications below. If additional fill is to be placed then the materials should be compacted in layers of less than 200 mm thickness and conditioned to the appropriate average water content. All organic material should be removed from the

fill prior to placement. Compaction of each layer of locally sourced fill should be sufficient to obtain the following standards:

Either:

- (a) For soils with more than 95% passing the 425 μ m sieve after compaction (**silts & clays**) the test criteria are
 - average vane strength over 10 consecutive readings shall not be less than 120 kPa with no individual reading less than 110 kPa
 - the air voids shall not exceed 7%.

Or:

- (b) Soils with less than 95% passing the 425 μ m sieve (**sands & gravels**) after compaction the test criteria are:
 - (i) In-situ CBR > 6 (or Clegg CIV > 10)

The in-situ CBR shall be measured by using NZS 4402, Test 6.1.3 and in accordance with
 - (ii) The air voids shall be measured by nuclear densometer and shall not exceed 7%.

A minimum of one in-situ density test (to determine air voids content) and a minimum of 10 shear vane/scala/clegg readings should be undertaken per 1,000 m³ (or 1 m lift) of fill with a minimum of 1 per 100 m² of fill per 200 mm lift.

Appropriate test methods for in-situ density (air voids measurement) are outlined below:

In-situ Density: NZS 4402:1986 test 5.1.1 or
 ASTM D2922 (Nuclear Densometer)

7.7 Liquefaction

The soils encountered at the site typically comprise fine grained silty sands and sandy silts. These soils have grain sizes close to the lower end of the particle size distribution envelope that can potentially liquefy during a seismic event. The ground water table is expected to be low (> 4 m depth) and the seismic accelerations for the Mangawhai area are also low. Based on the above and our review of the borehole and CPT data we consider the risk of liquefaction occurring on the site to be low.

7.8 Site seismic category

Seismic accelerations to be resisted by a structure are dependent upon the stiffness of the underlying soil / rock. Soft soils have the potential to amplify ground accelerations, requiring structures to be designed to resist a higher seismic coefficient. In terms of NZS1170 Section 5:2004 (ref 2), the site subsoil category should be taken as Class C (shallow soil sites).

8 Conclusions

Based on the information from the site investigation, and our experience with similar materials, we summarise our conclusions and recommendations for the proposed development as follows:

- The site is underlain by up to 0.5 m of organic topsoil overlying loose to medium dense sands and firm to stiff estuarine silts.
- Groundwater levels were recorded at depths typically greater than 4 m depth below existing ground level
- We recommend that structures be founded on shallow pad/strip footings or shallow rafts founded in the natural soils below any fill or topsoil. Shallow foundations can be designed assuming a geotechnical ultimate bearing capacity of 300 kPa which equates to an ultimate limit state (ULS) and allowable capacities of 150 & 100 kPa respectively.
- Once the site is stripped of topsoil and excavated to the design levels, we recommend that the site be proof rolled to consolidate any loose layers and identify and areas that need excavating out and replacing.
- Based on the loadings provided, and subject to proof rolling, we expect total settlement to be less than 50 mm with differential settlement greater than 1:300. The majority of settlement is likely to occur during the construction period or following the first full loading cycle.
- Retention design parameters and recommendations for excavations are provided in section 7.4 of the report.
- Pavements can be designed using a subgrade CBR of 4 as per section 7.5 of the report.
- Some minor earthworks may be undertaken on the site. Specifications for fill placement are provided in section 7.6 of the report.
- In terms of NZS1170 Section 5:2004 (ref 2), the site subsoil category should be taken as Class C (shallow soil sites).

9 Applicability

This report has been prepared for the benefit of Earth Tech Construction Pty Ltd with respect to the particular brief given to us and it may not be relied upon in other contexts or for any other purpose without our prior review and agreement.

TONKIN & TAYLOR LTD

Environmental and Construction Consultants

Report prepared by:

Authorised for Tonkin & Taylor by:



Scott Wilkinson/John Leeves



Chris Freer
Project Coordinator

sjww


P:\23428\23428.001\sjww220506rep.doc



10 **References**

1. New Zealand Geological Survey (1961). *Geology of Whangarei*. Department of Scientific & Industrial Research.
2. NZS 1170.5:2004. Code of Practice. *Structural Design Actions - Part 5 Earthquake Actions*. DR 1170.4/PPCD 8. Standards Australia / Standards New Zealand. DRAFT No 8.

Appendix A: Site plan & Geological Section

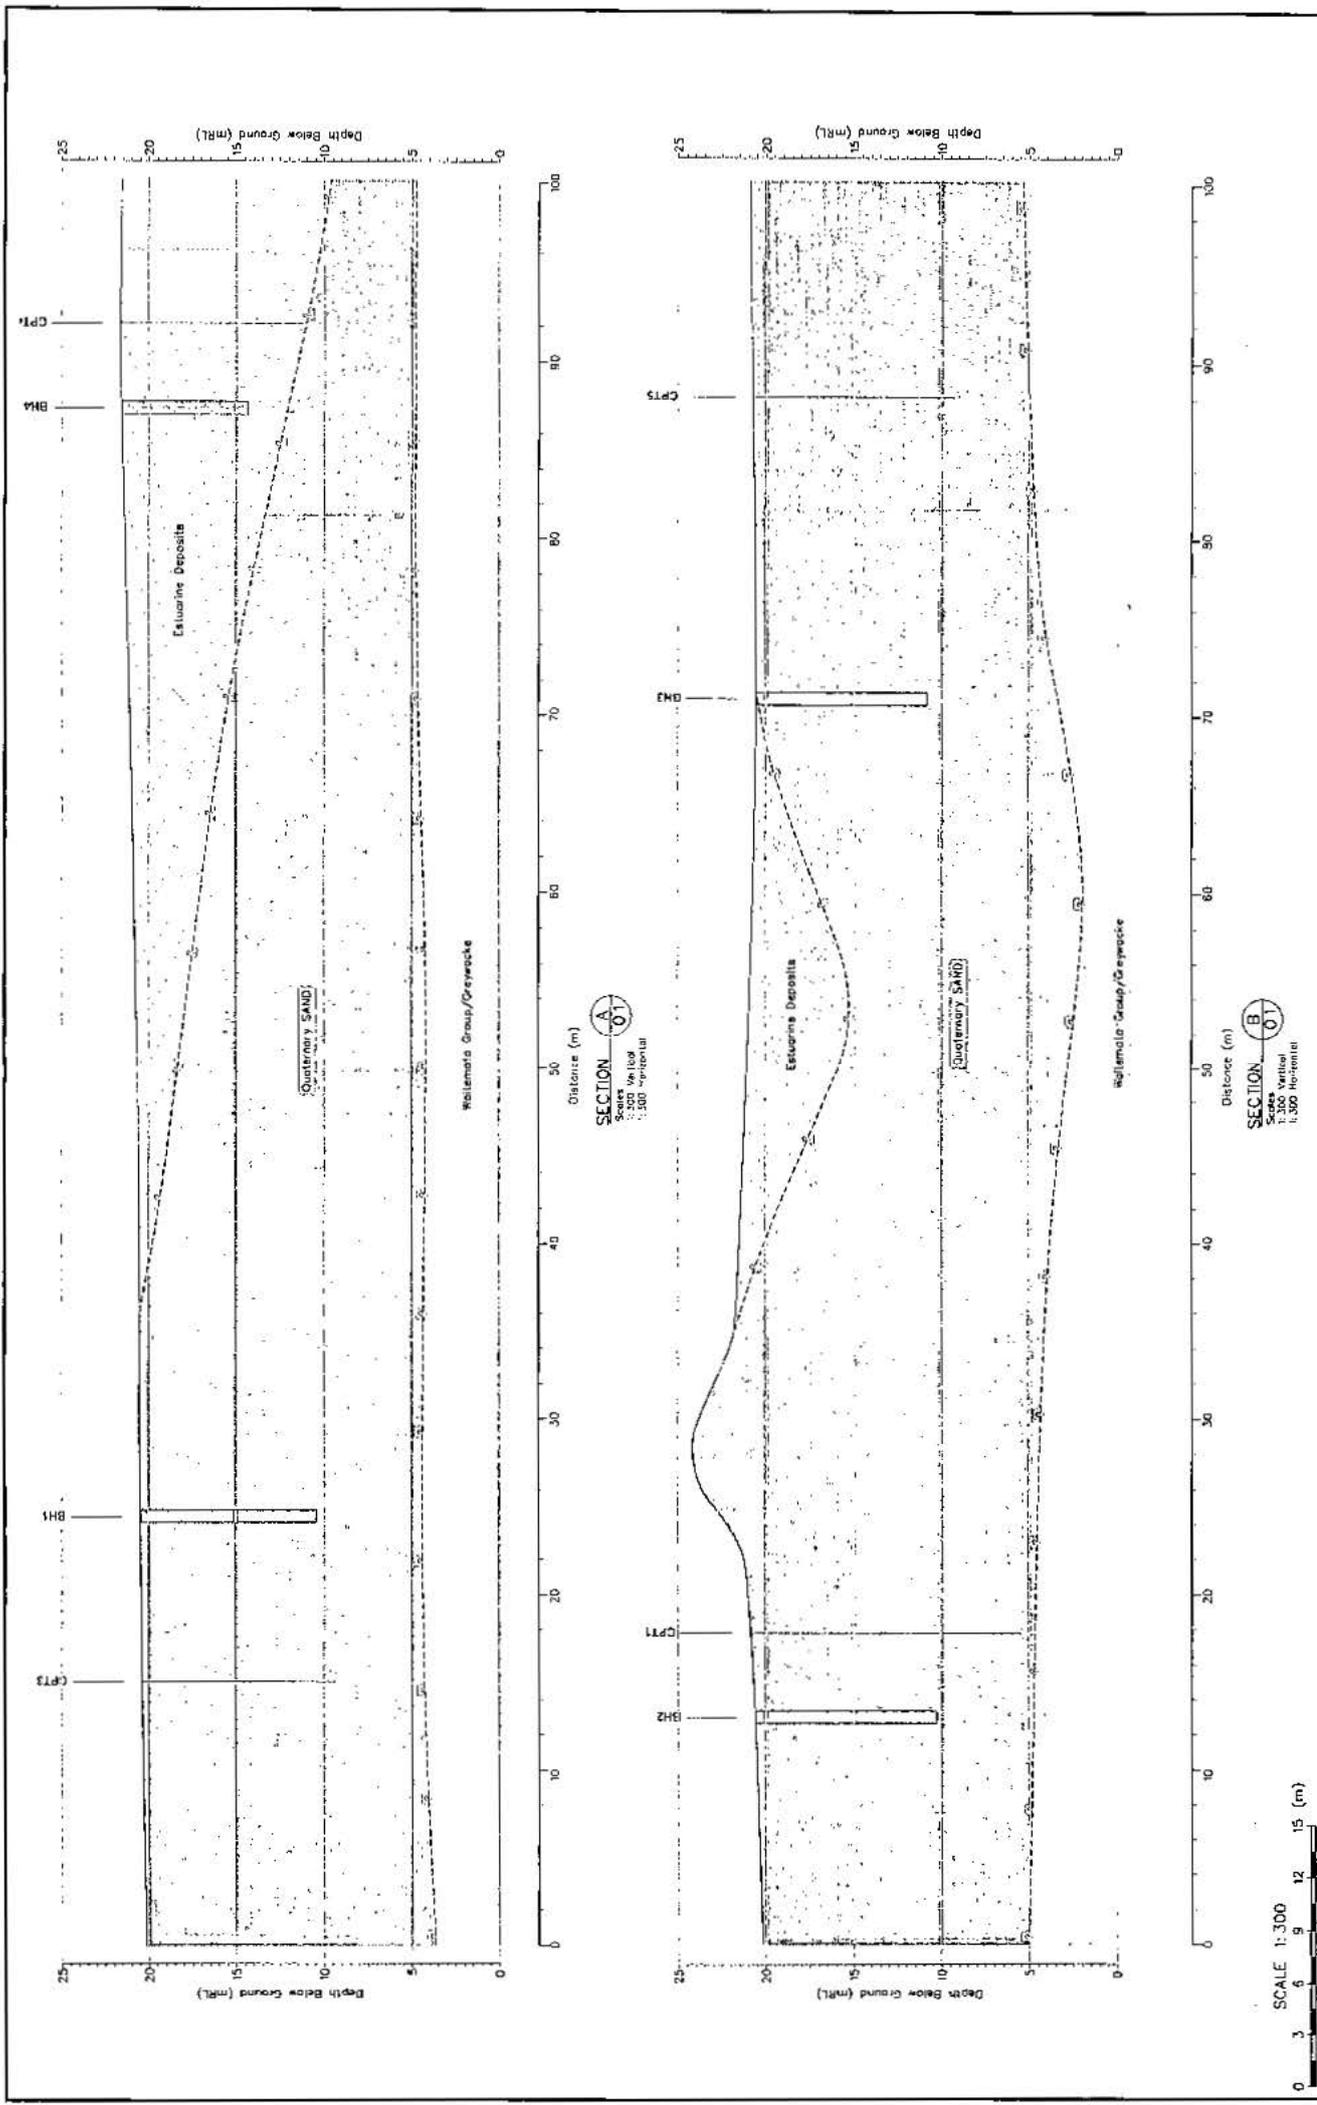

SCALE 1:300
 0 3 6 9 12 15 (m)

SECTION A
 Scale: 1:300 Vertical, 1:300 Horizontal

SECTION B
 Scale: 1:300 Vertical, 1:300 Horizontal

NOTES:
 1. All dimensions are in metres unless noted otherwise.
 2. Inferred Geological Contact

SECTONAL LEGEND:
 [Symbol] Estuarine Deposits
 [Symbol] Quaternary SAND

NOT FOR CONSTRUCTION
 This drawing is to be used only for reference purposes.



SCALE: 1:300
DATE: 23/04/2013
PROJECT NO.: 23428.001-02

Appendix B: Borehole Logs



TONKIN & TAYLOR LTD

BOREHOLE LOG

BOREHOLE No: BHI
Hole Location: GPS mark 39
SHEET... 1 ... OF ... 1 ...

PROJECT: Mangawhai Sewer Plant - Geo		LOCATION: Mangawhai		JOB No: 23428.001	
CO-ORDINATES mN mE		DRILL TYPE: GEOPROBE		HOLE STARTED: 15/5/06	
R.L. m		DRILL METHOD: Percussion		HOLE FINISHED: 15/5/06	
DATUM		DRILL FLUID: N/A		DRILLED BY: LDE LOGGED BY: SJWW CHECKED: JRL	

GEOLOGICAL				ENGINEERING DESCRIPTION															
GEOLOGICAL UNIT, GENERIC NAME, ORIGIN, MINERAL COMPOSITION.	FLUID LOSS	WATER	CORE RECOVERY	METHOD	CASING	TESTS	SAMPLES	R.L. (m)	DEPTH (m)	GRAPHIC LOG	CLASSIFICATION SYMBOL	MOISTURE / WEATHERING CONDITION	STRENGTH/STIFFNESS CLASSIFICATION	SHEAR STRENGTH (kPa)	COMPRESSIVE STRENGTH (kPa)	DEFECT SPACING (mm)	SOIL DESCRIPTION		
																	Substance		Rock type, particle size, colour, mineral components
TOPSOIL																		SILT, some fine sand, moderately to highly plastic, stiff to very stiff, some roots in top 200mm, grey brown.	
QUARTERNARY SANDS			450	SPT	AUGER	2 3 2 N=5			1	X	MH		VSt				NO RECOVERY.		
			1050	AUGER					2	X	MH		L				SILT, some fine sand, some clay, very stiff, highly plastic, wet, light grey (very), mottled light orange brown.		
			450	SPT	AUGER	2 5 4 N=9			3	.	SM						SAND (fine), loosely packed, moist to wet, occasional black carbonaceous specks throughout, light orange brown.		
			1050	AUGER					4	.									
			450	SPT	AUGER	3 4 5 N=9			5	.									
			1050	AUGER					6	.									
			450	SPT	AUGER	2 4 6 N=10			7	.								- becomes very light brown, white and black specks, saturated.	
			1050	AUGER					8	x				MD				- black carbonaceous material for 50mm (1mm thick layers). - becomes orange brown, some silt and tightly packed. - becomes loosely packed, minor silt.	
			150	SPT	AUGER	3 4 8 N=12			9	x								- becomes tightly packed, light brown with black carbonaceous specks and streaks, silty. - minor silt, loosely packed.	
			450	SPT	AUGER	3 5 9 N=14			10	x								END OF BOREHOLE AT 10.0m	

BOX 1

BOX 2

BOX 3



TONKIN & TAYLOR LTD

BOREHOLE LOG

BOREHOLE No: BH2
 Hole Location: GPS mark 40
 SHEET OF

PROJECT: Mangawhai Sewer Plant - Geo		LOCATION: Mangawhai		JOB No: 23428.001															
CO-ORDINATES mN mE		DRILL TYPE: GEOPROBE		HOLE STARTED: 15/5/06															
R.L. m		DRILL METHOD: Percussion		HOLE FINISHED: 15/5/06															
DATUM		DRILL FLUID: N/A		DRILLED BY: LDE															
				LOGGED BY: SJWV CHECKED: JRI															
GEOLOGICAL			ENGINEERING DESCRIPTION																
GEOLOGICAL UNIT, GENERIC NAME, ORIGIN, MINERAL COMPOSITION	FLUID LOSS	WATER	CORE RECOVERY	METHOD	CASING	TESTS	SAMPLES	R.L. (m)	DEPTH (m)	GRAPHIC LOG	CLASSIFICATION SYMBOL	MOISTURE CONDITION	WEATHERING	STRENGTH CLASSIFICATION	SHEAR STRENGTH (kPa)	COMPRESSIVE STRENGTH (kPa)	DEFECT SPACING (mm)	SOIL DESCRIPTION Soil type, major components, plasticity or particle size, colour. ROCK DESCRIPTION Substance, Block type, particle size, colour, minor components. Defects: Type, extension, thickness, roughness, filling.	
QUARTERINARY SANDS				AUGER		4 4 5 N=9			1	X	MH			V+				SILT, some fine sand, highly plastic, wet, brown. - becomes light brown orange, very stiff, twigs. SAND (fine to medium), some silt, loosely packed, wet, light brown orange brown. NO RECOVERY.	
			450	SPT					2	X	SM			L					
			1050	AUGER			3 5 5 N=10		3	X									
			450	SPT					4	X									
	BOX 1		1050	AUGER			4 4 5 N=10		5	X				MD					- becomes orange brown.
			450	SPT					6	X									
			1050	AUGER			5 6 8 N=14		7	X									- black carbonaceous material. - becomes saturated.
			450	SPT					8	X									
	BOX 2		1050	AUGER			3 5 8 N=13		9	X		MH			St				SILT, some sand (fine), moderately plastic, firm to stiff, light grey. NO RECOVERY, recovered as silty mud as water filled in the bottom of the hole before run.
			450	SPT					10	X					St				
BOX 3																			SILT, clayey, soft to firm, grey brown, sticky as much water came out with sample, (water filling hole). END OF BOREHOLE AT 8.0m - rods jammed. - piezometer installed to 9.0m. - screened.



TONKIN & TAYLOR LTD

BOREHOLE LOG

BOREHOLE No: BH3
 Hole Location: GPS mark 41
 SHEET... 1 ... OF ... 1 ...

PROJECT: Mangawhai Sewer Plant - Geo	LOCATION: Mangawhai	JOB No: 23428.001
CO-ORDINATES mN mE	DRILL TYPE: GEOPROBE	HOLE STARTED: 16/5/06
R.L. m	DRILL METHOD: Percussion	HOLE FINISHED: 16/5/06
DATUM	DRILL FLUID: N/A	DRILLED BY: LDE
		LOGGED BY: SJ/WV CHECKED: JRL

GEOLOGICAL	ENGINEERING DESCRIPTION																		
GEOLOGICAL UNIT, GENERIC NAME, ORIGIN, MINERAL COMPOSITION.	FLUID LOSS	WATER	CORE RECOVERY	METHOD	CASINGS	TESTS	SAMPLES	R.L. (m)	DEPTH (m)	GRAPHIC LOG	CLASSIFICATION SYMBOL	MOISTURE CONDITION	VEGETATION	STRENGTH CLASSIFICATION	SHEAR STRENGTH (kPa)	COMPRESSION STRENGTH (MPa)	DEFECT SPACING (mm)	SOIL DESCRIPTION Soil type, minor components, plasticity or particle size, colour.	ROCK DESCRIPTION Substance: Rock type, particle size, colour, minor components. Defects: Type, inclination, thickness, roughness, gling.
TOPSOIL									0	x	OL							SILT, some sand (fine), organic, roots, dark brown.	
QUATERNARY SANDS				AUGER					0.5	x	SM							SAND (fine), very silty, non plastic, moist to wet, highly packed, grey brown.	
				SPT					1	x	MH							SILT, slightly sandy, highly plastic, stiff to very stiff, wet, light brown mottled orange.	
BOX 1				AUGER					2	x								- firm for 100mm.	
				SPT					2	x								SAND (fine to medium), loosely packed, wet, occasional black specks, (carbonaceous material / or weathering), light orange brown.	
				AUGER					3	x									
				SPT					3	x									
BOX 2				AUGER					4	x									
				SPT					4	x									
				AUGER					5	x									
				SPT					5	x									
BOX 3				AUGER					6	x									
				SPT					6	x									
				AUGER					7	x								- becomes saturated.	
				SPT					7	x									
				AUGER					8	x	MII						- 50mm layer silty, very light grey / brown.		
				SPT					8	x							SILT, sandy (fine), saturated, soft to firm in some parts, SAND is dominant fraction (loosely packed), light brown.		
				AUGER					9	x	SM						SAND, fine to medium, wet, only just tightly packed, orange brown mottled black.		
				SPT					9	x									
				AUGER					10	x									
				SPT					10	x									
				AUGER					10	x									
				SPT					10	x									
				SPT															




TONKIN & TAYLOR LTD

BOREHOLE LOG

BOREHOLE No: BH4
Hole Location: GPS mark 42
SHEET **OF**

PROJECT: Mangawhai Sewer Plant - Geo				LOCATION: Mangawhai				JOB No: 23428.001											
CO-ORDINATES				DRILL TYPE: GEOPROBE				HOLE STARTED: 16/5/06											
R.L. m				DRILL METHOD: Percussion				HOLE FINISHED: 16/5/06											
DATUM				DRILL FLUID: N/A				DRILLED BY: LDE											
				LOGGED BY: SJWW				CHECKED: JRI											
GEOLOGICAL				ENGINEERING DESCRIPTION															
GEOLOGICAL UNIT, GENERIC NAME, ORIGIN, MINERAL COMPOSITION				FLUID LOSS	WATER	CORE RECOVERY	METHOD	CASING	TESTS	SAMPLES	DEPTH (m)	GRAPHIC LOG	CLASSIFICATION SYMBOL	MOISTURE / WEATHERING CONDITION	STRENGTH/DENSITY CLASSIFICATION	SHEAR STRENGTH (kPa)	COMPRESSIVE STRENGTH (kPa)	DEFECT SPACING (mm)	SOIL DESCRIPTION
																			Soil type, minor components, plasticity or particle size, colour.
																			Rock description
																			Substance: Rock type, particle size, colour, minor components.
																			Defects: Type, inclination, thickness, roughness, fling.
TOPSOIL										0		OL							SILT, sandy, organic, roots, wet, dark brown.
ESTUARINE DEPOSITS										1		MH							SILT, some sand, moderately plastic, wet, firm, light brown mottled orange.
												1		SM					
BOX 1						450	AUGER			2		MH		St					SAND (fine to medium), some silt, loosely packed, light orange brown.
						1050	AUGER					2							
BOX 2						450	SPT			3		SM							- becomes clayey, minor sand, very highly plastic, firm to stiff.
						1050	AUGER					3		SM		L			
BOX 3						450	SPT			4		MH							SAND (fine), crumbly, tightly packed, hard, moist, limonite, orange brown (dark orange).
						1050	AUGER					4		MH					
BOX 2						450	SPT			5		MH							SILT, minor fine sand, wet, stiff, highly plastic, orange brown.
						1050	AUGER					5		SM		MD			
BOX 3						925	SPT			6									SILT, clayey, minor fine to coarse rounded sand, (sand green grey and white), very highly plastic, stiff to very stiff, light grey.
						1050	AUGER					6							
BOX 2						925	SPT			7									SAND (fine), silty with some medium to coarse SAND tightly packed.
						1050	AUGER					7							
BOX 3						925	SPT			8									- 6.0 to 6.5m orange brown to brown stained layers up to 10mm thick.
						1050	AUGER					8							
BOX 3						925	SPT			9									END OF BOREHOLE 4 AT 7.0m
						1050	AUGER					9							
BOX 3						925	SPT			10									
						1050	AUGER					10							



Appendix C: CPT Logs

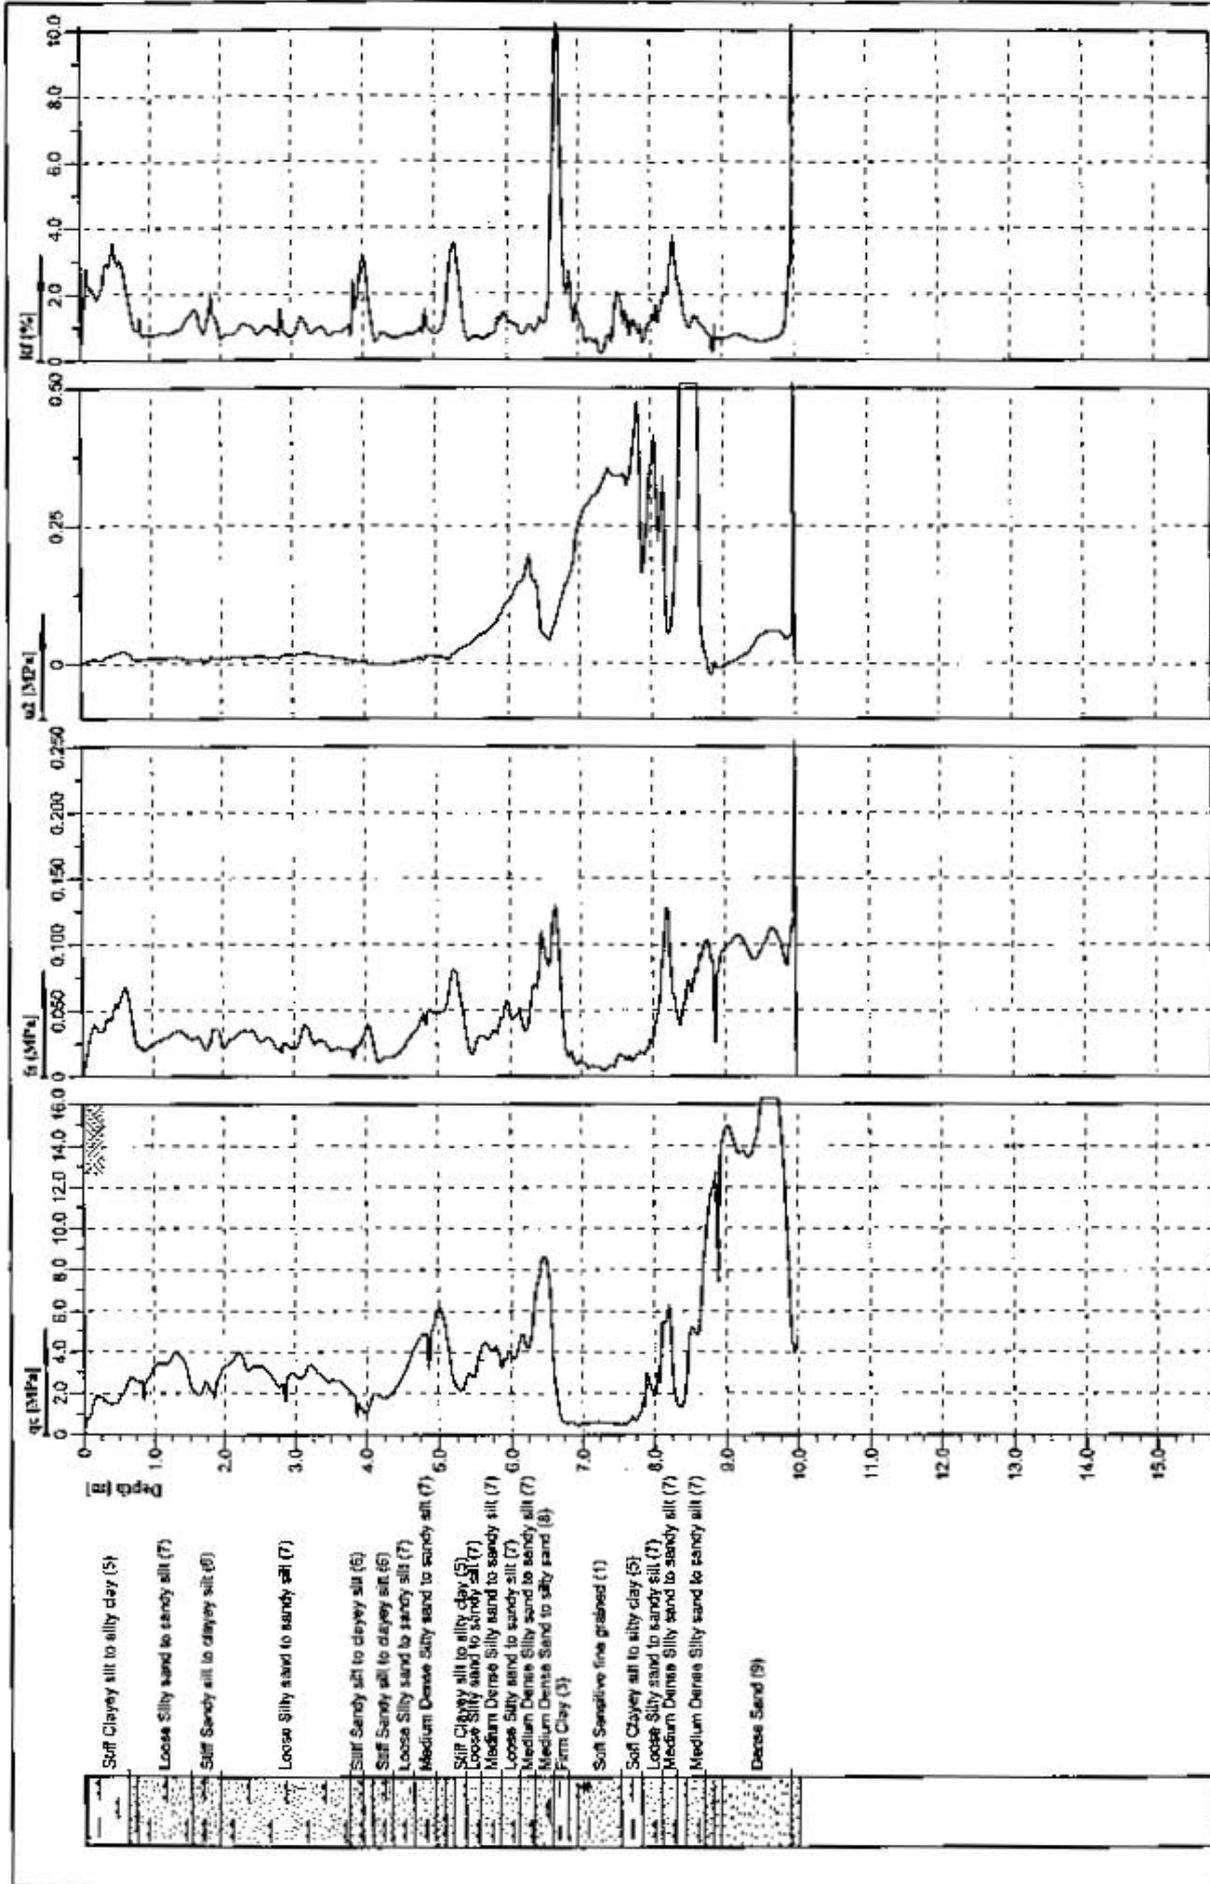

Location:	MANGAWHAI HEADS	Position:	X: 0.00 m, Y: 0.00 m.	Ground level:	0.00	Test no.:	CPT1
Project ID:	01131	Client:	TONKIN & TAYLOR LTD	Date:	17/05/2008	Scale:	1 : 100
Project:	MANGAWHAI HEADS SEWER PLANT - 23428.001	Page:	1/1	Fig:		File:	cp110.001



Code No: 0
 To: 1000 (m) 10
 Sheet size (mm) 150

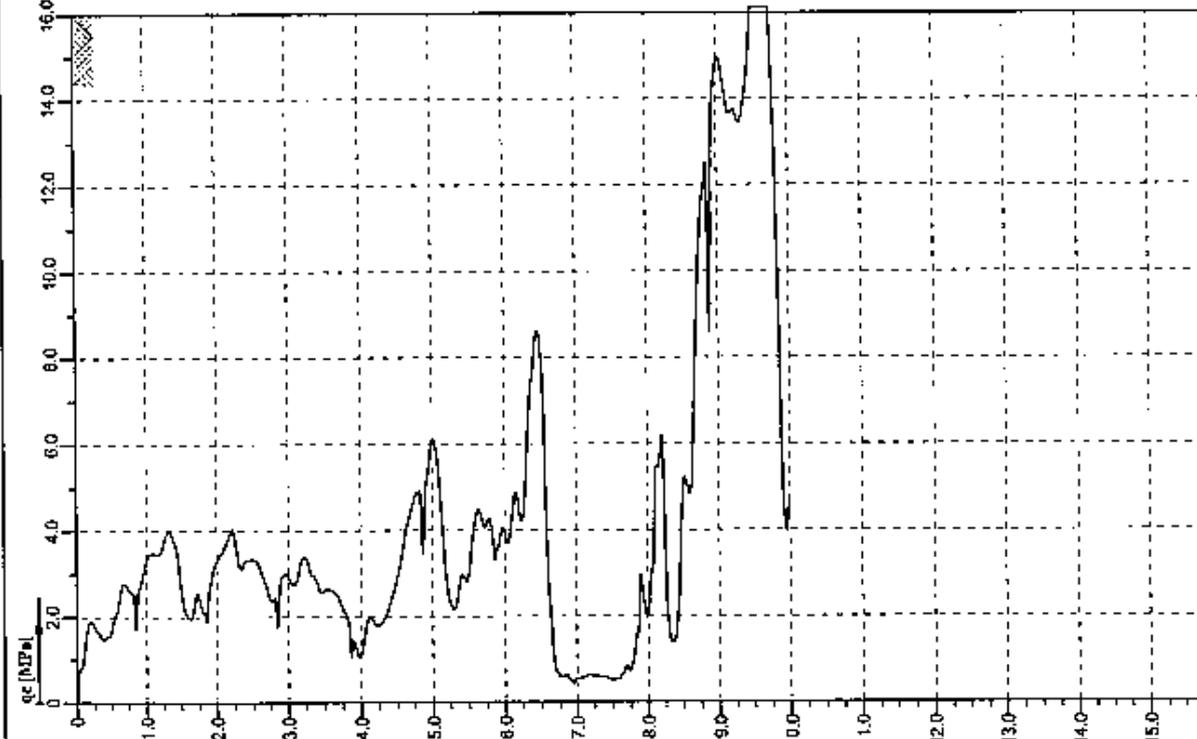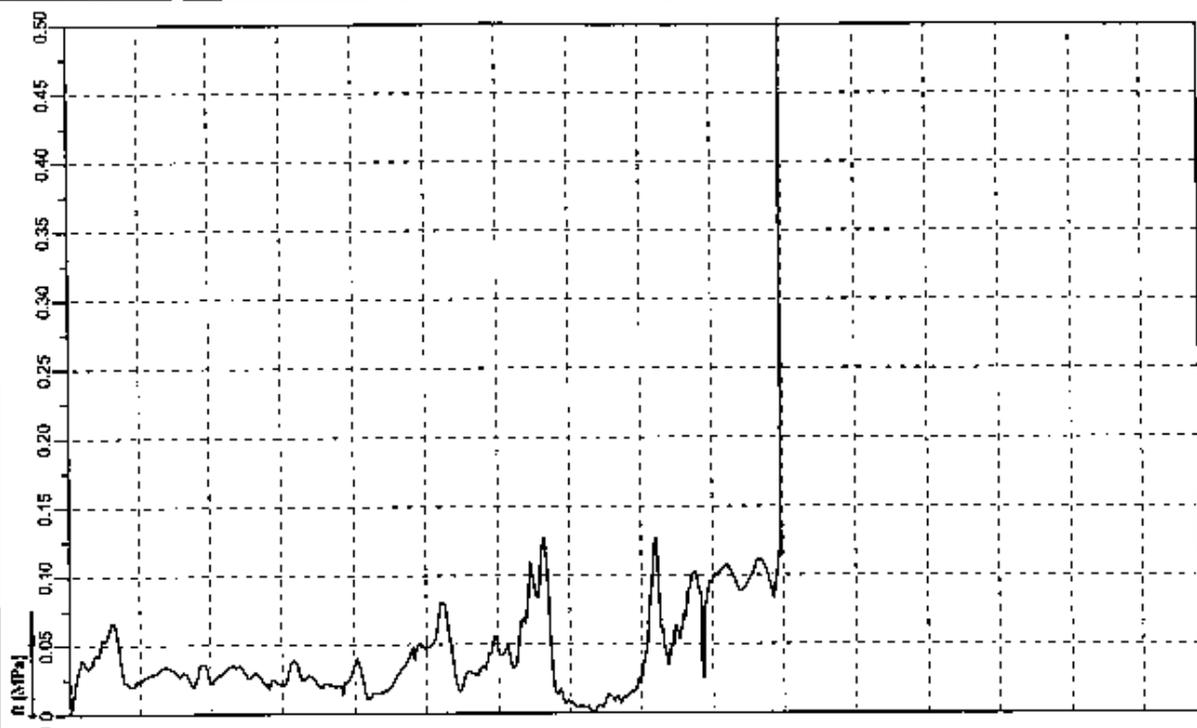


Ground level: Test no:	0.00	CPT11
Date:	17/05/2006	Scale: 1 : 100
Page:	1/1	Fig:
File:	cpt10_001	
Position:	X: 0.00 m, Y: 0.00 m	
Client:	TONKIN & TAYLOR LTD	
Location:	MANGAWHAI HEADS	
Project ID:	D1131	
Project:	MANGAWHAI HEADS SEWER PLANT - 23428.001	




 Core No: 0

 Tip area (cm²): 10

 Sample area (cm²): 150



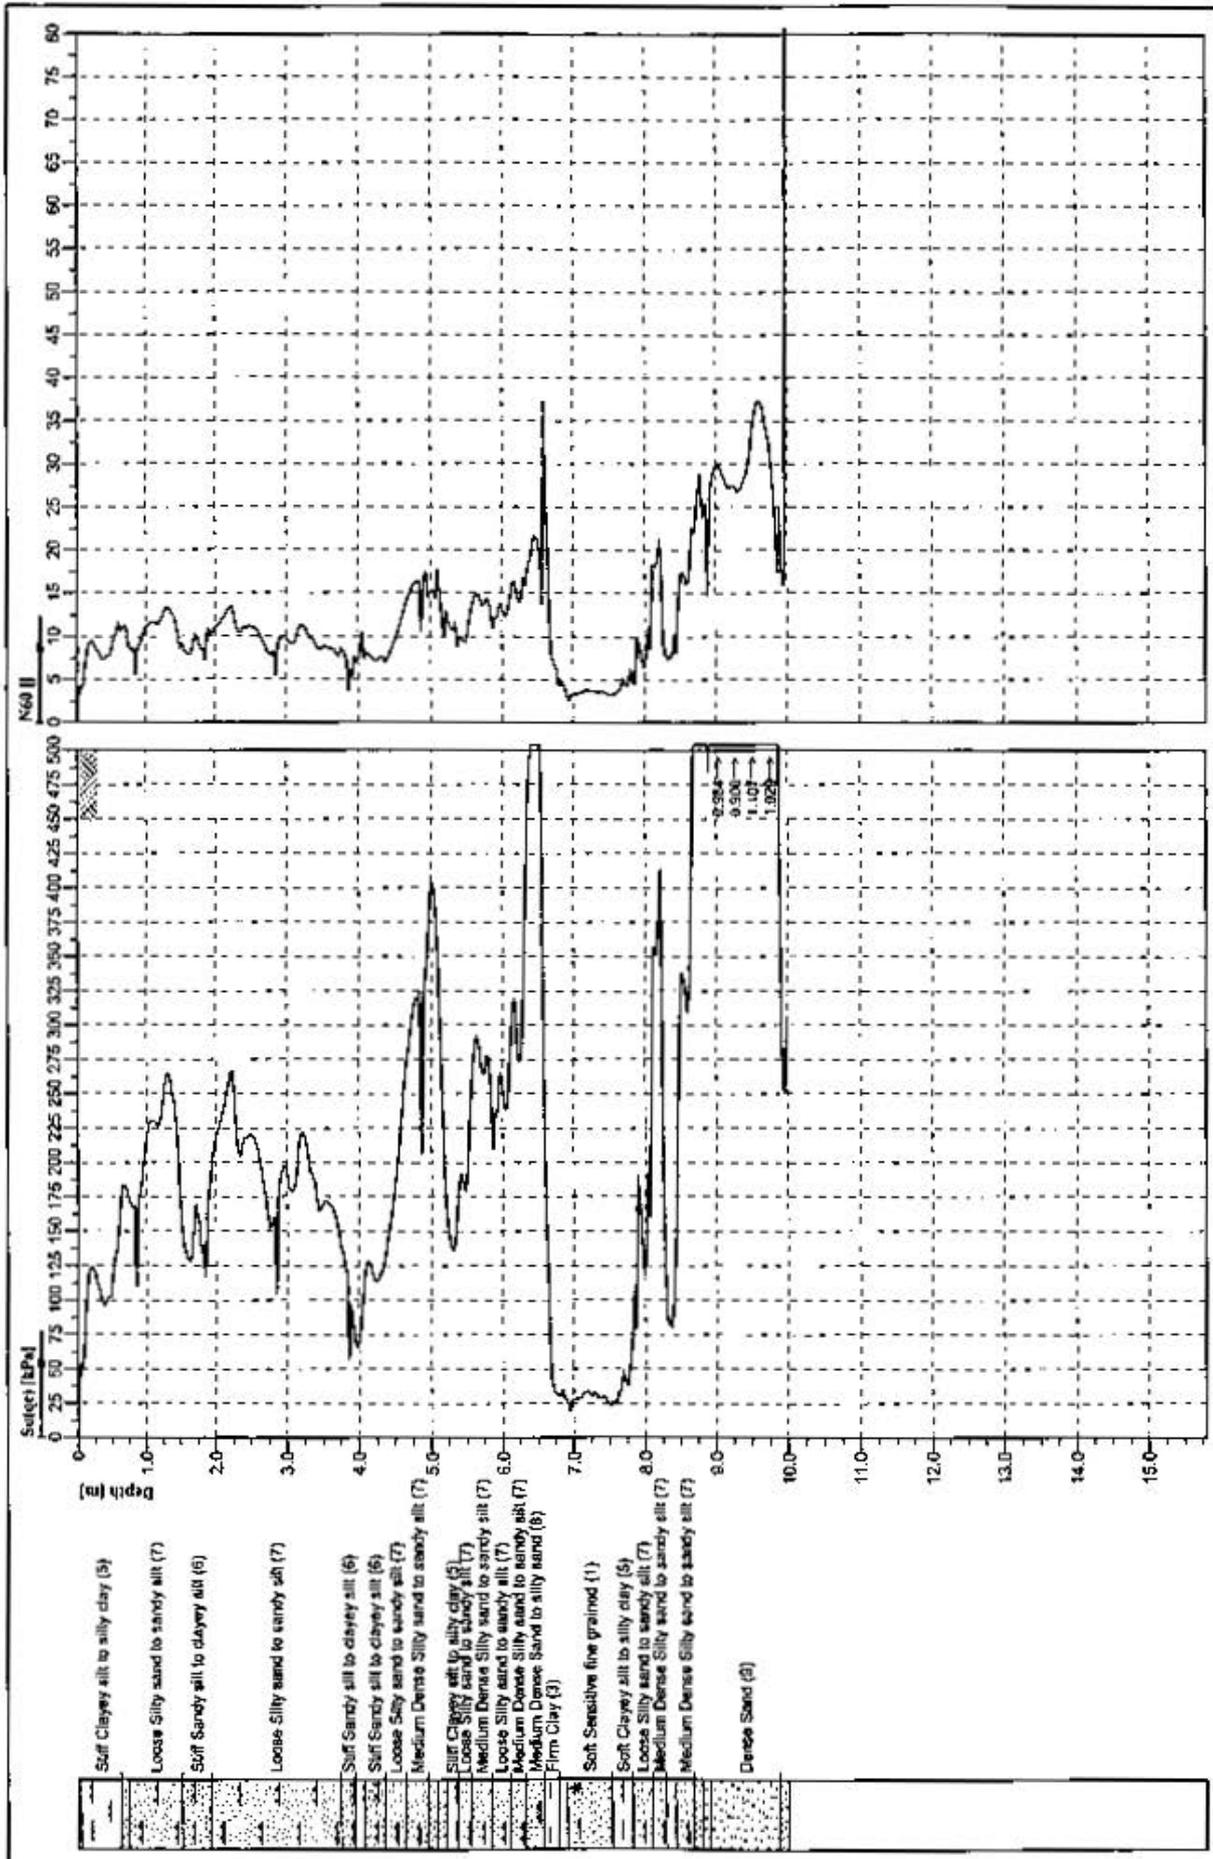


Location:	MANGAWHAI HEADS	Position:	X: 0.00 m, Y: 0.00 m
Project ID:	D1131	Client:	TONKIN & TAYLOR LTD
Project:	MANGAWHAI HEADS SEWER PLANT - 23428.001	Ground level:	Test no: CPT1
		Date:	17/05/2006
		Scale:	1 : 100
		Page:	1/1
		Fig:	
		File:	cp110_001



Scale No: 0
 To read (mm) 10
 Sheet area (mm²): 180




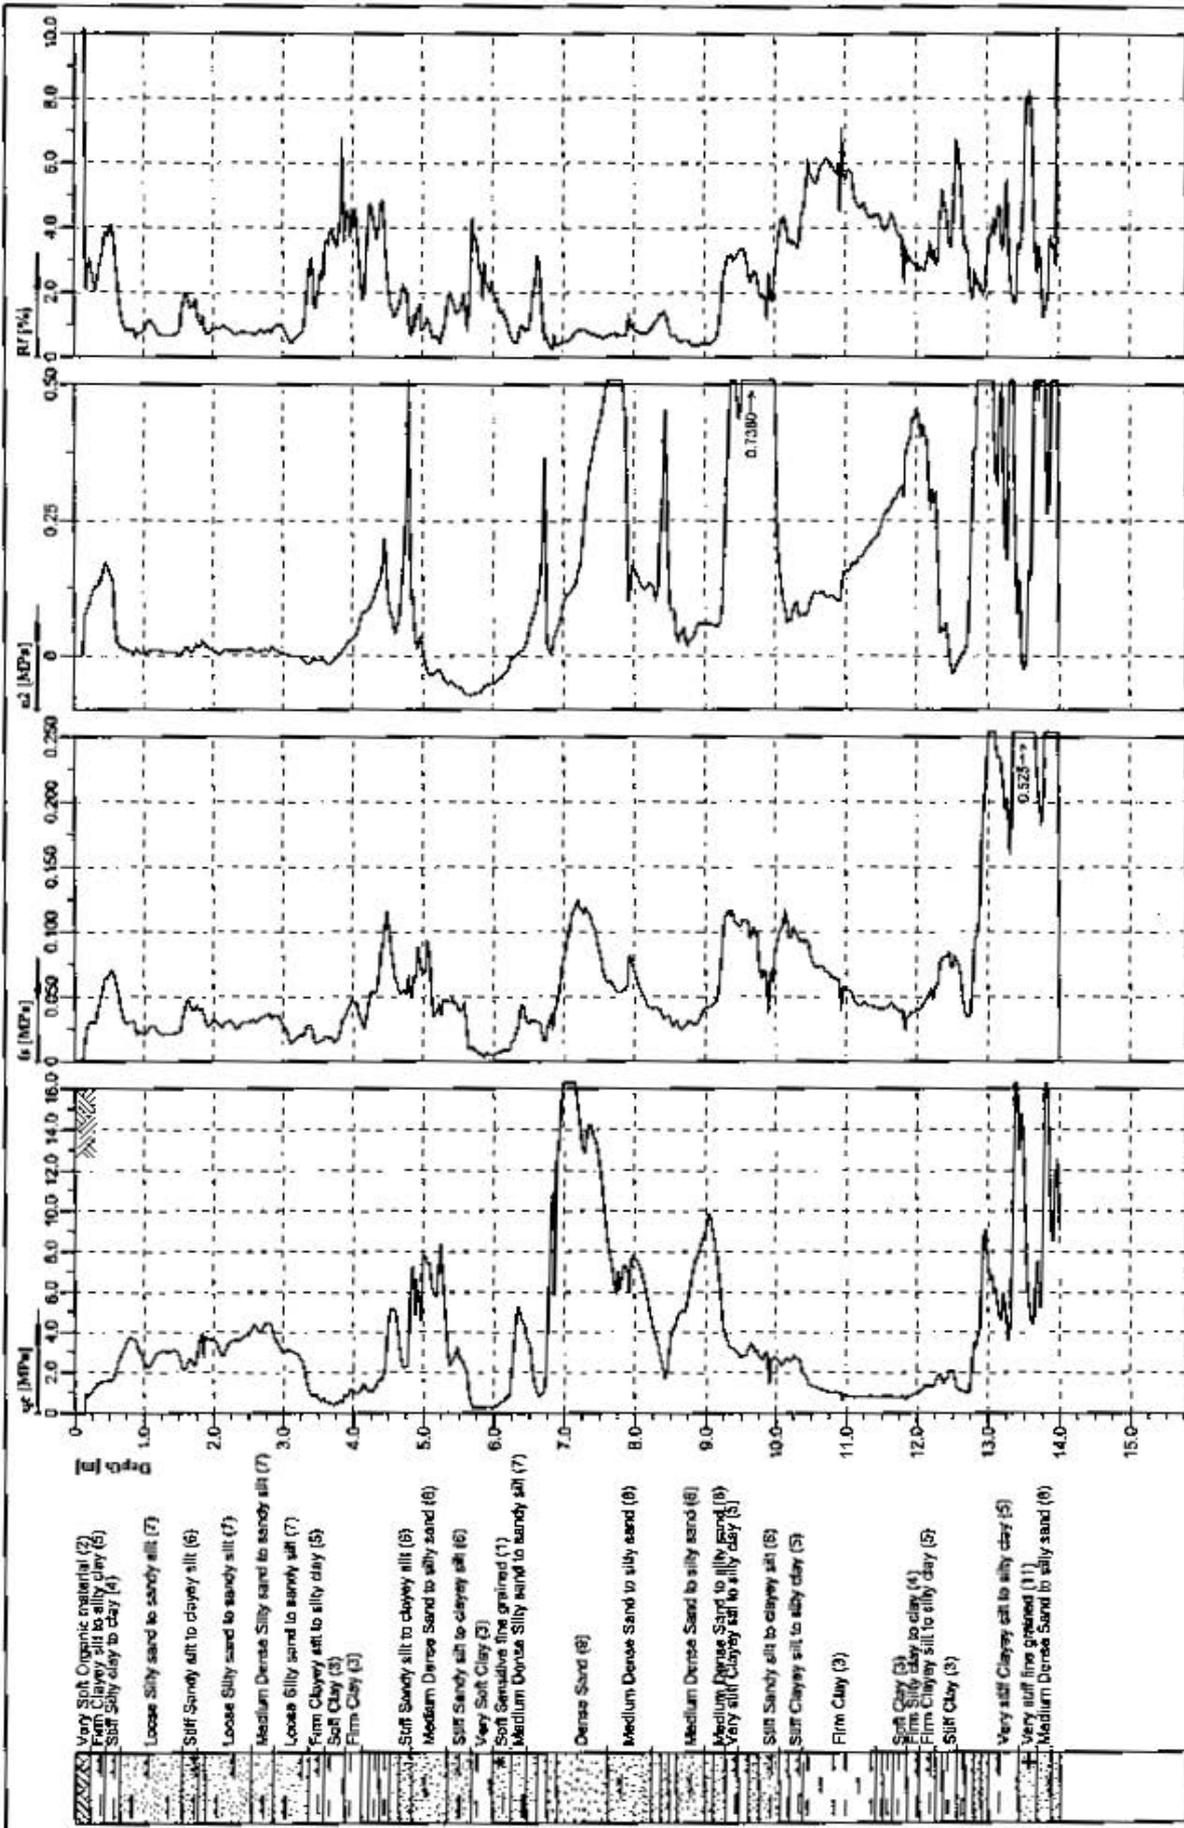

Location:	MANGAWHAI HEADS	Position:	X: 0.00 m, Y: 0.00 m
Project ID:	D1131	Client:	TONKIN & TAYLOR LTD
Project:	MANGAWHAI HEADS SEWER PLANT - 23428.001	Test no.:	CPT2
		Ground level:	0.00
		Date:	17/05/2006
		Scale:	1 : 100
		Page:	1/1
		Fig.:	
		File:	cpt2.001



Course No. 0
 Sheet size (mm): A30

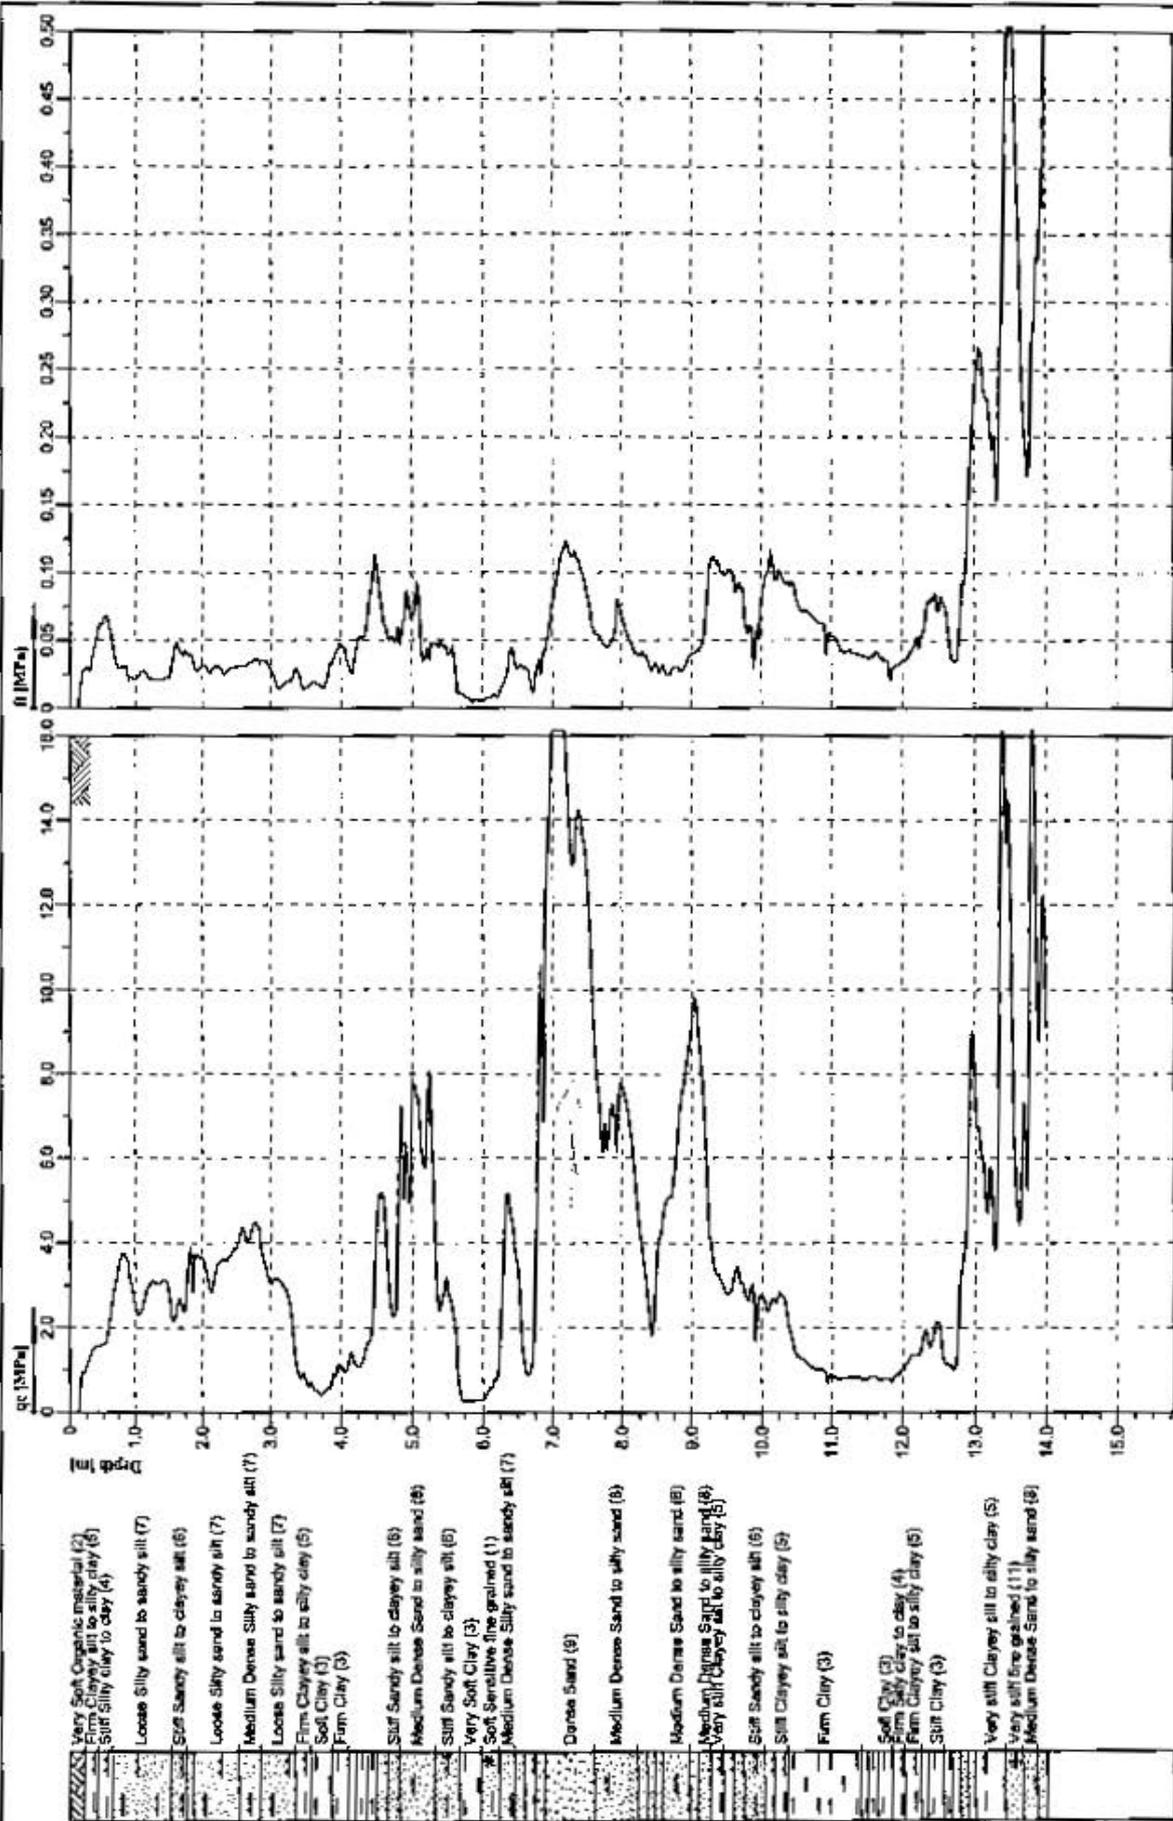


Location:	MANGAWHAI HEADS	Position:	X: 0.00 m, Y: 0.00 m	Ground level:	0.00	Test no.:	CPT2
Project ID:	D1131	Client:	TONKIN & TAYLOR LTD	Date:	17/05/2006	Scale:	1 : 100
Project:	MANGAWHAI HEADS SEWER PLANT - 23/28.001	Page:	1/1	Fig:		File:	cpt2.001



Core No: 0
 To area (m²): 10
 Sleeve area (m²): 150




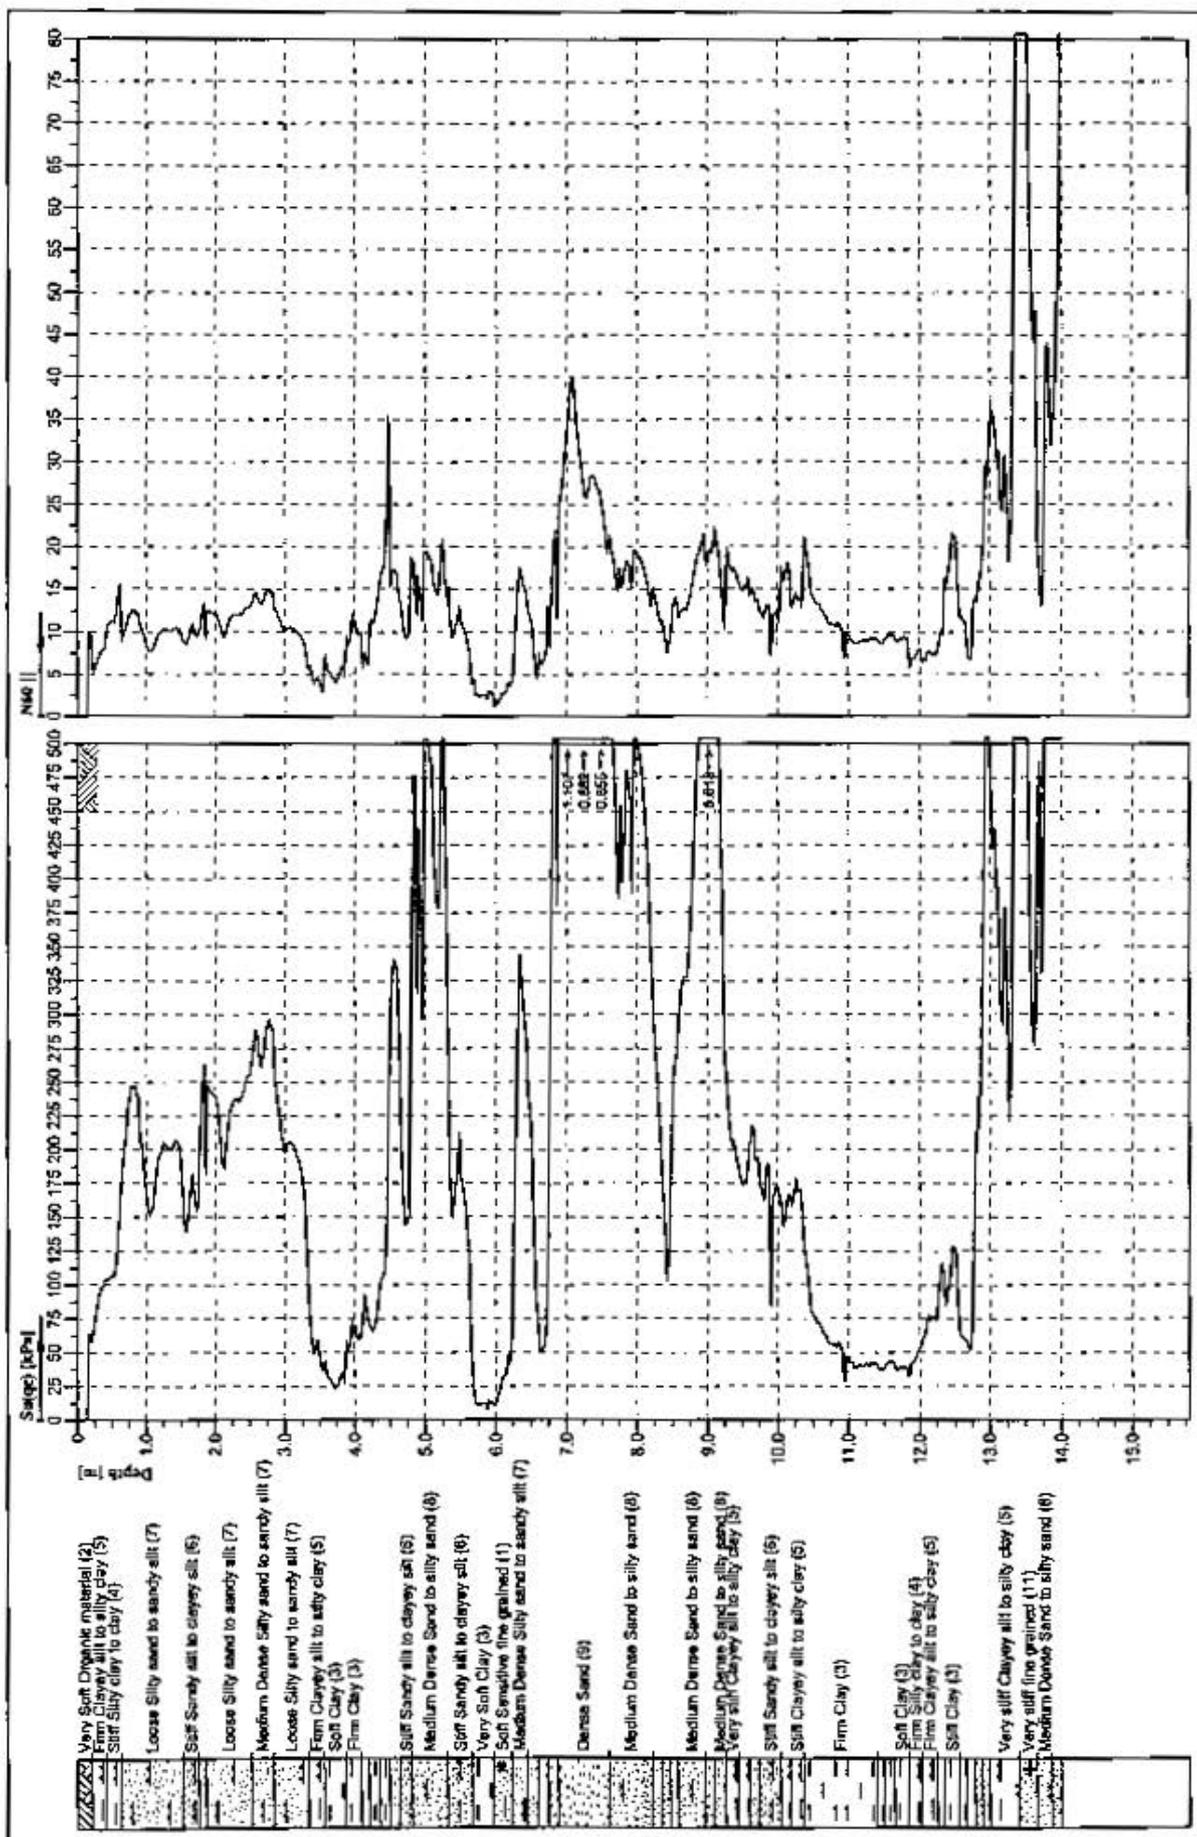

Location:	Position:	Ground level:	Test no.:
MANGAWHAI HEADS	MANGAWHAI HEADS	0.00	CPT2
Project ID:	Client:	Date:	Scale:
D1131	TONKIN & TAYLOR LTD	17/05/2006	1 : 100
Project:		Page:	Fig:
MANGAWHAI HEADS SEWER PLANT - 23428.001		1/1	
		File:	cpt2.001




Scale No: 0
 To scale (m): 10
 Sheet size (mm): 106

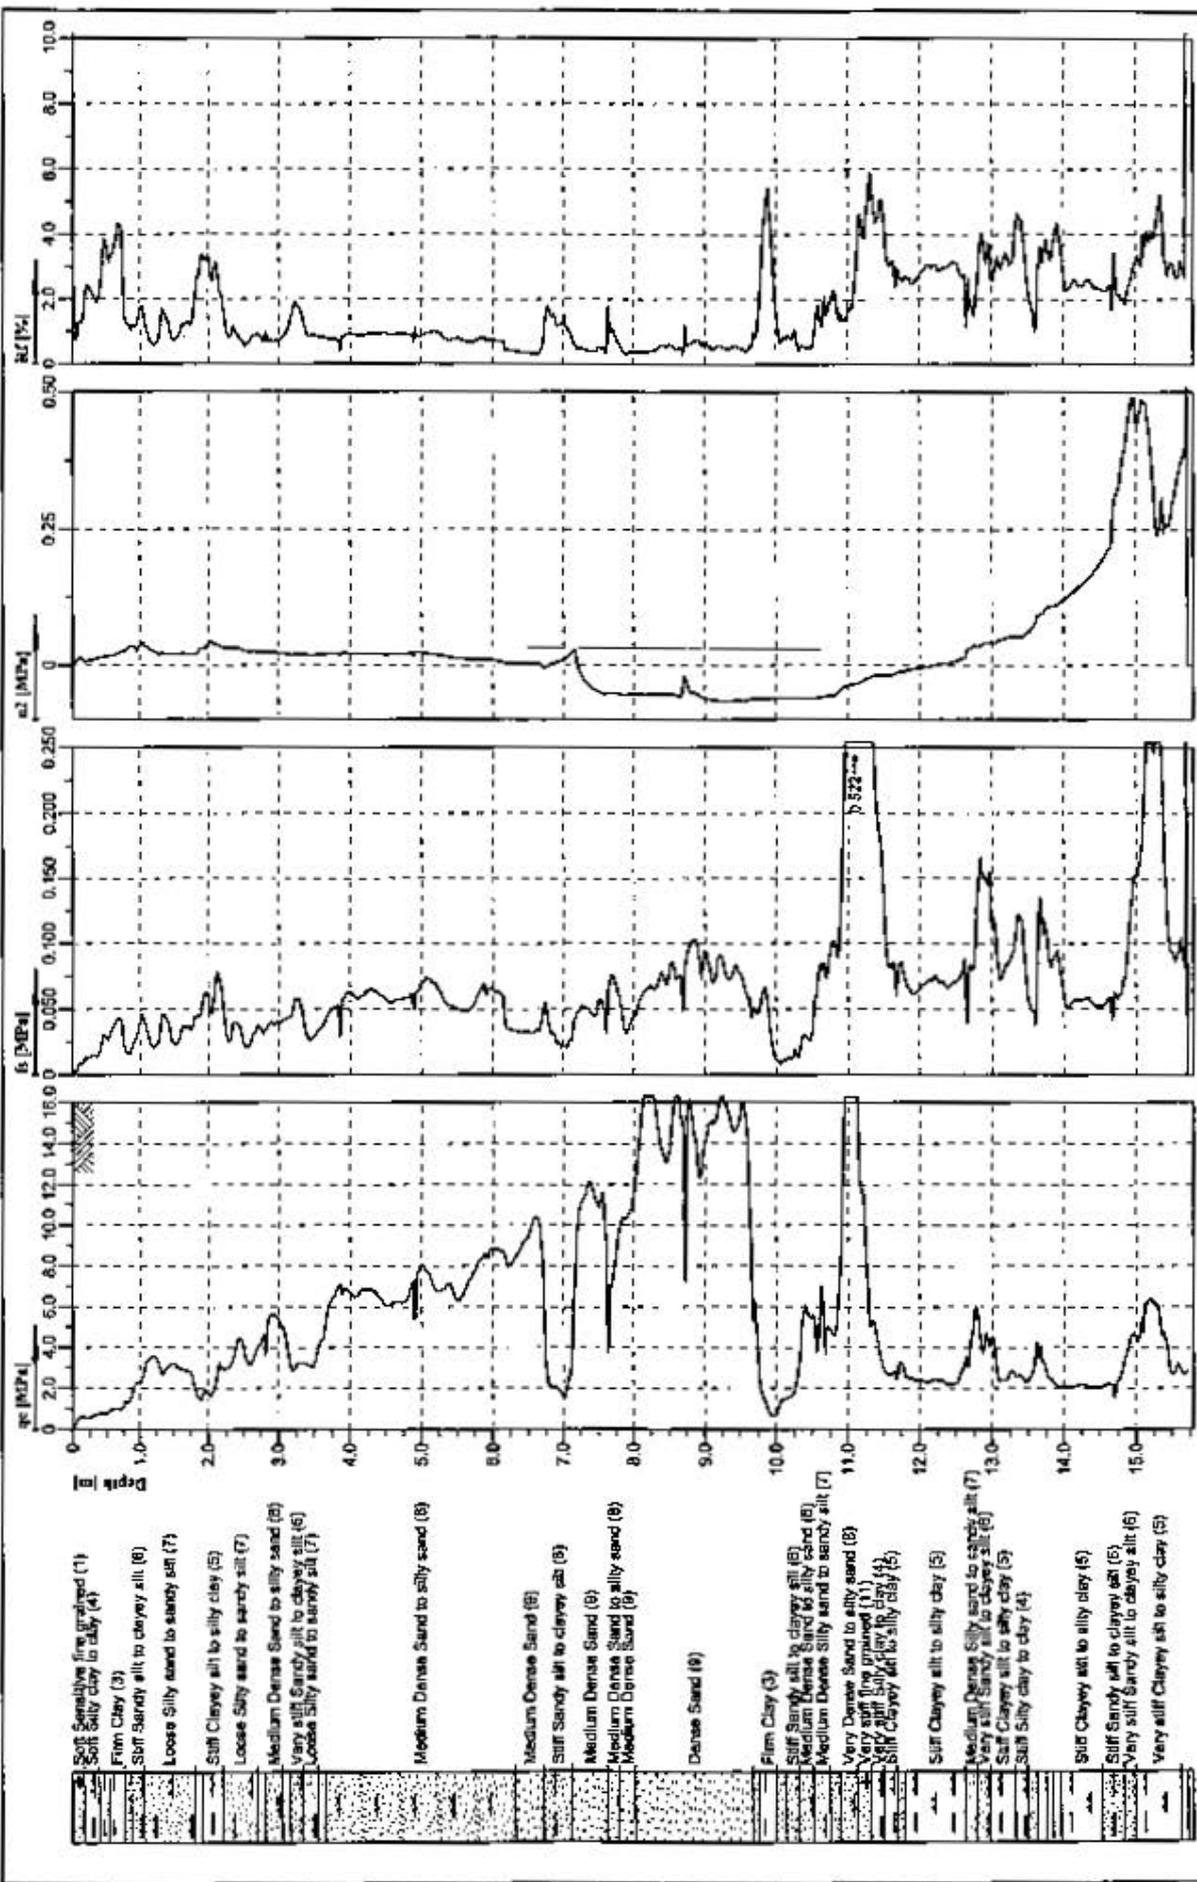

Location: MANGAWHAI HEADS	Position: X: 0.00 m, Y: 0.00 m	Test no: CPT3
Project ID: D1131	Client: TONKIN & TAYLOR LTD	Date: 17/05/2006
Project: MANGAWHAI HEADS SEWER PLANT - 23428.001	Page: 1/1	Scale: 1 : 100
		File: cpt3.001





Cone no: 0
 Tip area [cm²]: 10
 Sleeve area [cm²]: 150

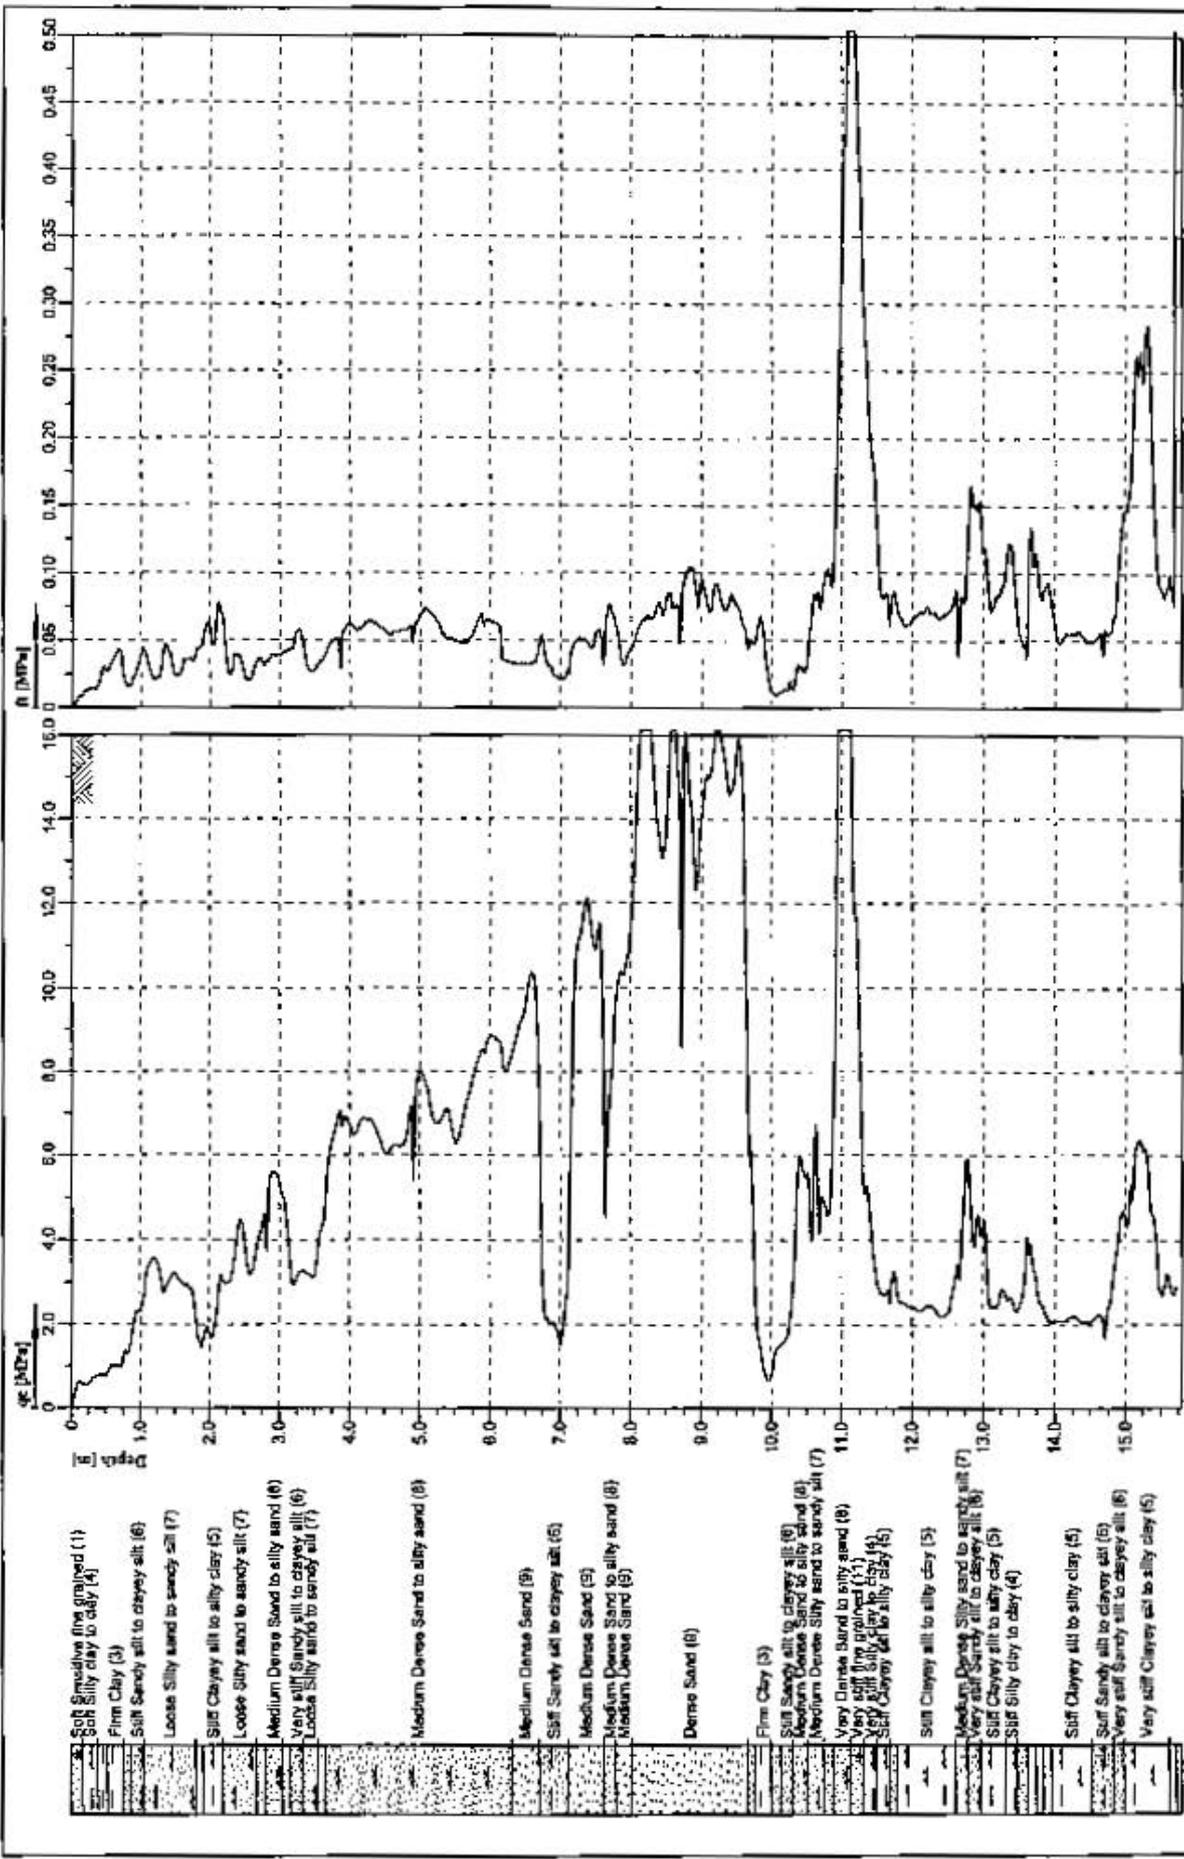

Ground level:	0.00	Test no:	CPT3
Date:	17/05/2005	Scale:	1 : 100
Page:	1/1	File:	cpt3.001
Position:	X: 0.00 m, Y: 0.00 m		
Client:	TONKIN & TAYLOR LTD		
Project ID:	D1131		
Project:	MANGAWHAI HEADS SEWER PLANT - 23428.001		

DE
Engineering & Construction Ltd.



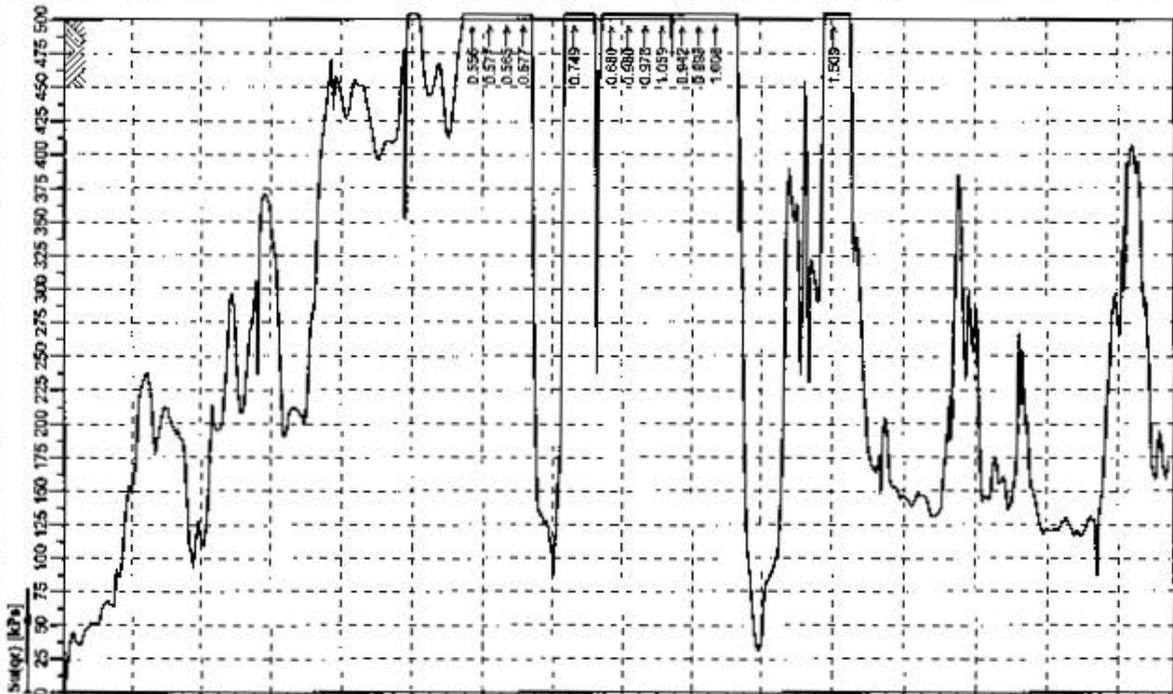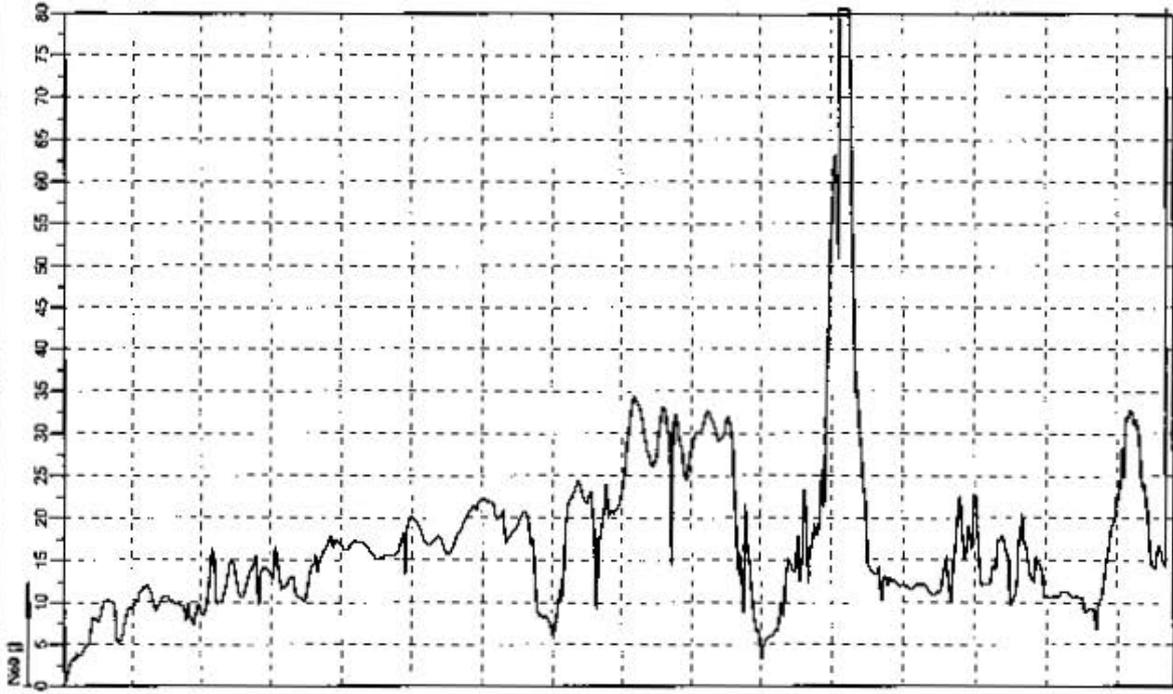

Location:	MANGAWHAI HEADS	Position:	X: 0.00 m, Y: 0.00 m
Project ID:	D1131	Client:	TONKIN & TAYLOR LTD
Project:	MANGAWHAI HEADS SEWER PLANT - 23428.001	Test no:	CPT3
		Date:	17/05/2005
		Scale:	1 : 100
		Page:	1/1
		File:	opt3.001

Scale No: 0
 To read (mm): 10
 Sheet size (mm): 180



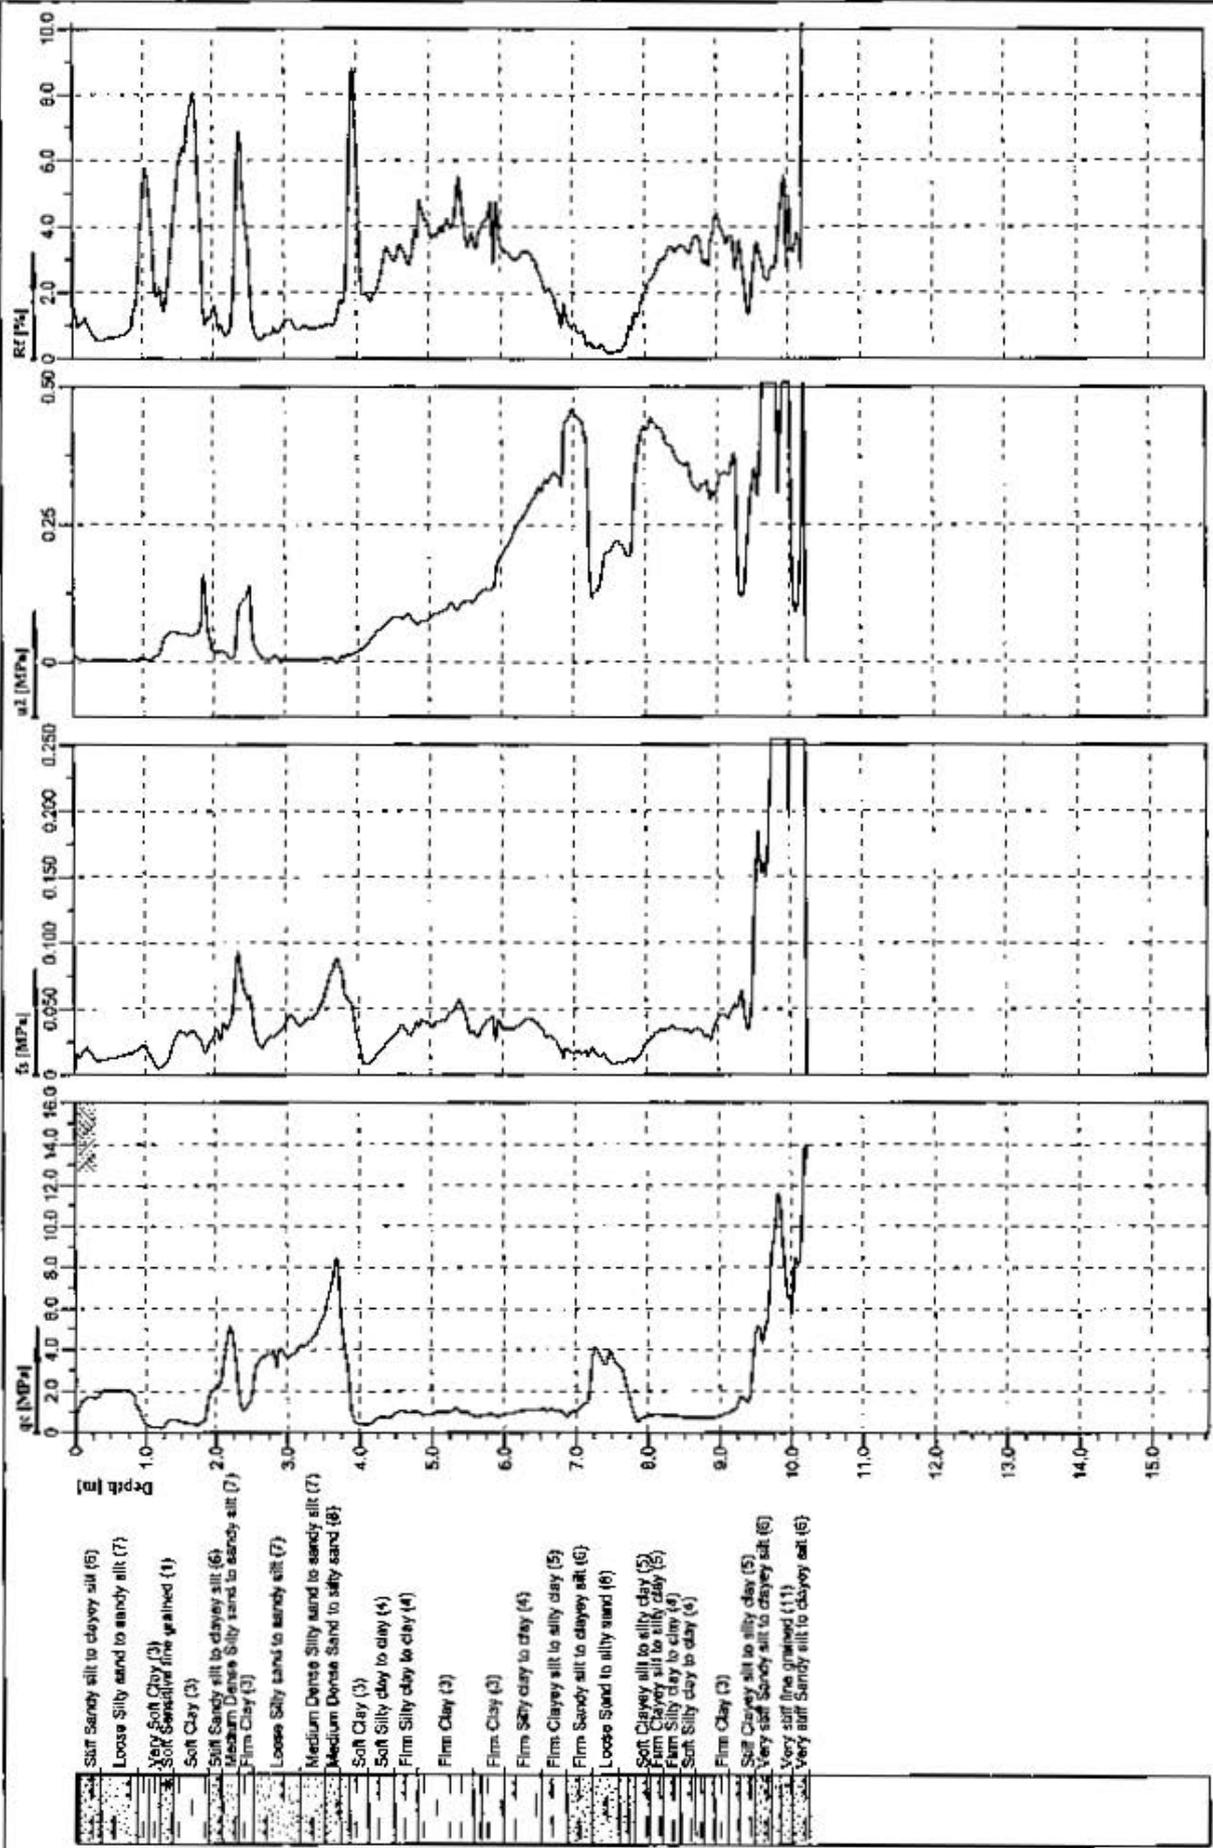


- Stiff Sandy silt to clayey silt (6)
- Loose Silty sand to sandy silt (7)
- Very Soft Clay (3)
- Soft Silty fine grained (1)
- Soft Clay (3)
- Soft Sandy silt to clayey silt (6)
- Medium Dense Silty sand to sandy silt (7)
- Firm Clay (3)
- Loose Silty sand to sandy silt (7)
- Medium Dense Silty sand to sandy silt (7)
- Medium Dense Sand to silty sand (6)
- Soft Clay (3)
- Soft Silty clay to clay (4)
- Firm Silty clay to clay (4)
- Firm Clay (3)
- Firm Clay (3)
- Firm Silty clay to clay (4)
- Firm Clayey silt to silty clay (5)
- Firm Sandy silt to clayey silt (6)
- Loose Sand to silty sand (6)
- Soft Clayey silt to silty clay (5)
- Firm Clayey silt to silty clay (5)
- Firm Silty clay to clay (4)
- Soft Silty clay to clay (4)
- Firm Clay (3)
- Soft Clayey silt to silty clay (5)
- Very soft Silty sand to clayey silt (6)
- Very stiff fine grained (1)
- Very stiff Sandy silt to clayey silt (6)

Location:	MANGAWHAI HEADS	Position:	X: 0.00 m, Y: 0.00 m	Test no.:	CPT4
Project ID:	D1131	Client:	TONKIN & TAYLOR LTD	Date:	17/05/2008
Project:	MANGAWHAI HEADS SEWER PLANT - 23428.001	Page:	1/1	Scale:	1 : 100
		File:	cpt15.001		




Cone No: 0
Tip area [cm2]: 40
Sleeve area [cm2]: 150



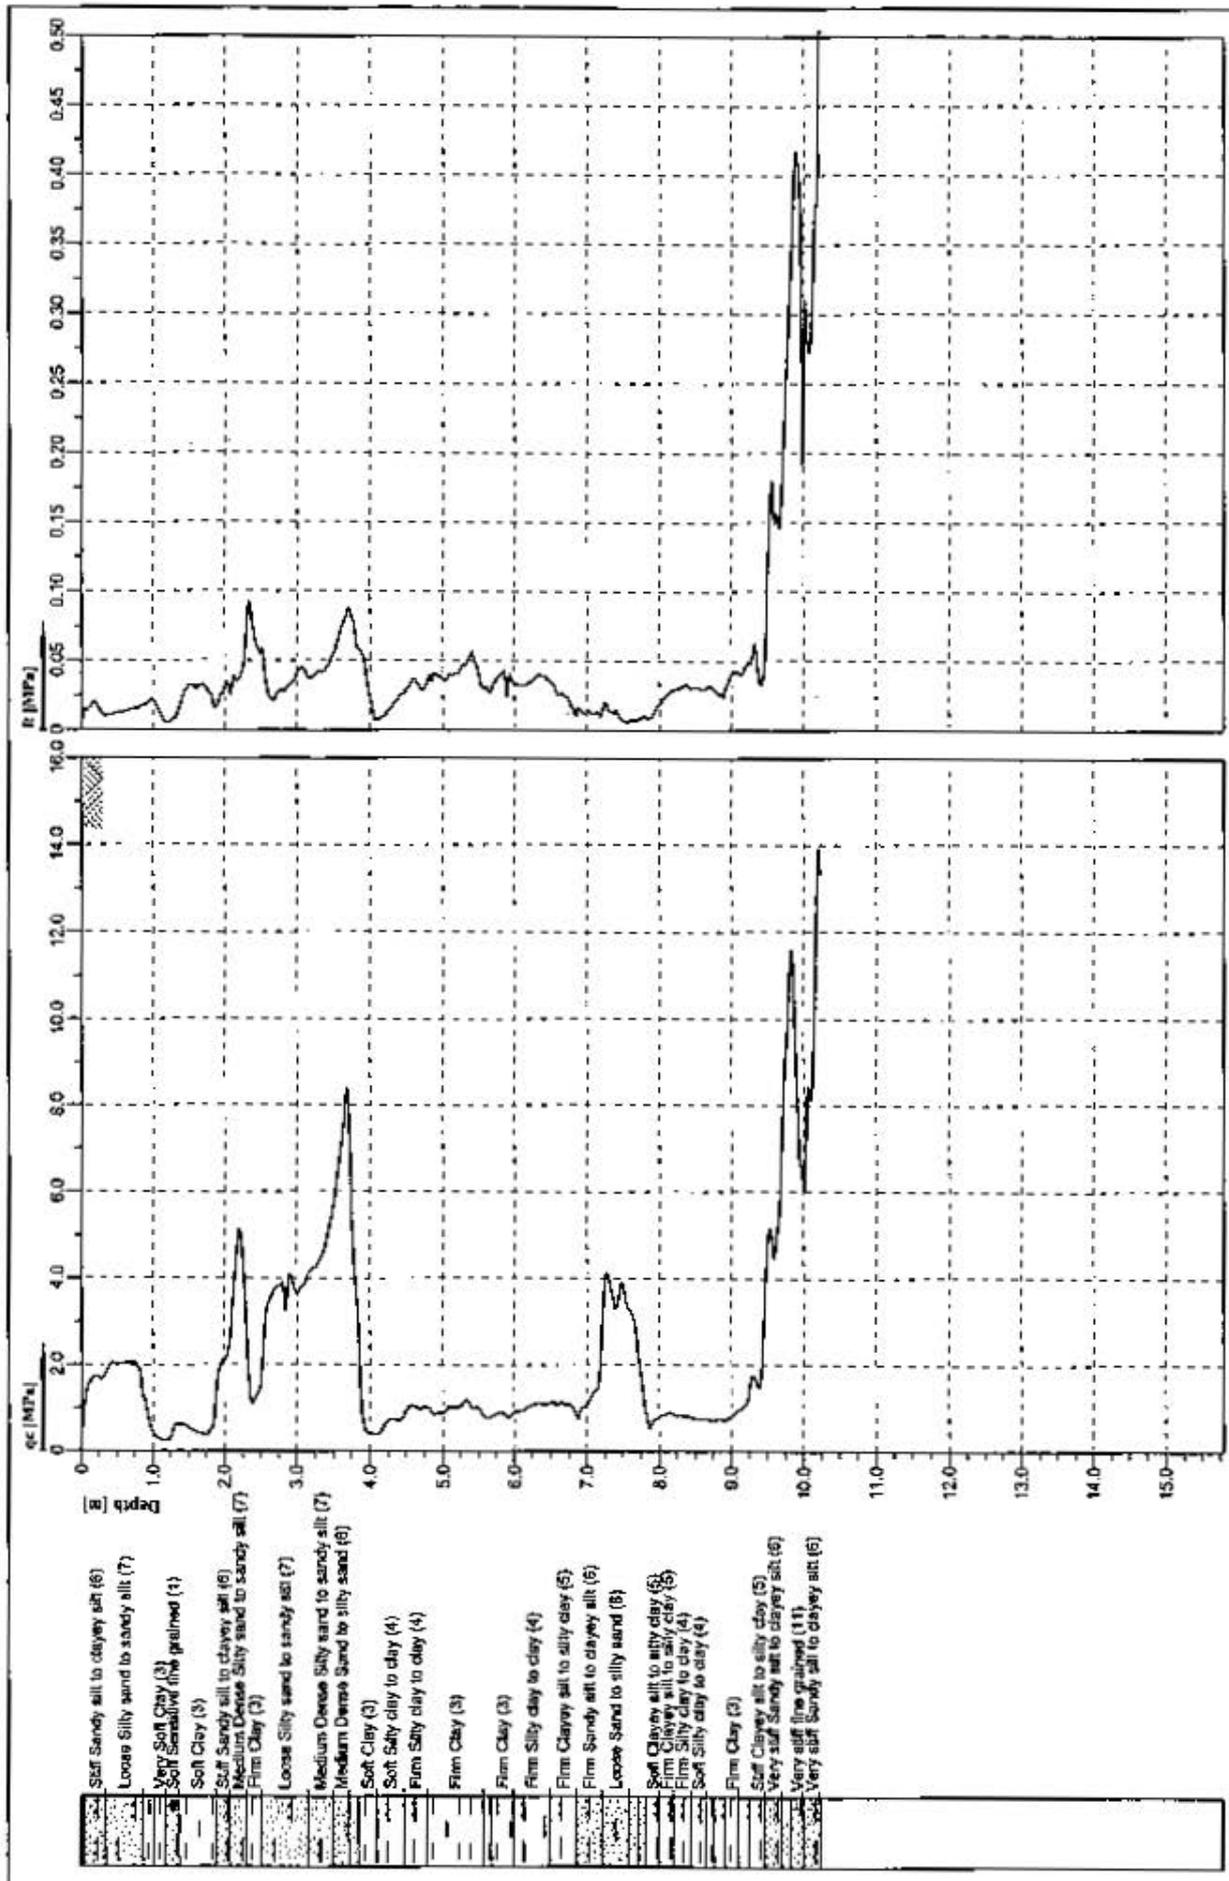

Location:	MANGAWHAI HEADS	Position:	X: 0.00 m, Y: 0.00 m	Test no.:	CPT14
Project ID:	Q1131	Client:	TONKIN & TAYLOR LTD	Date:	17/05/2008
Project:	MANGAWHAI HEADS SEWER PLANT - 23428.001	Page:	1/1	Scale:	1 : 100
		File:	cpt15.001	Fig:	



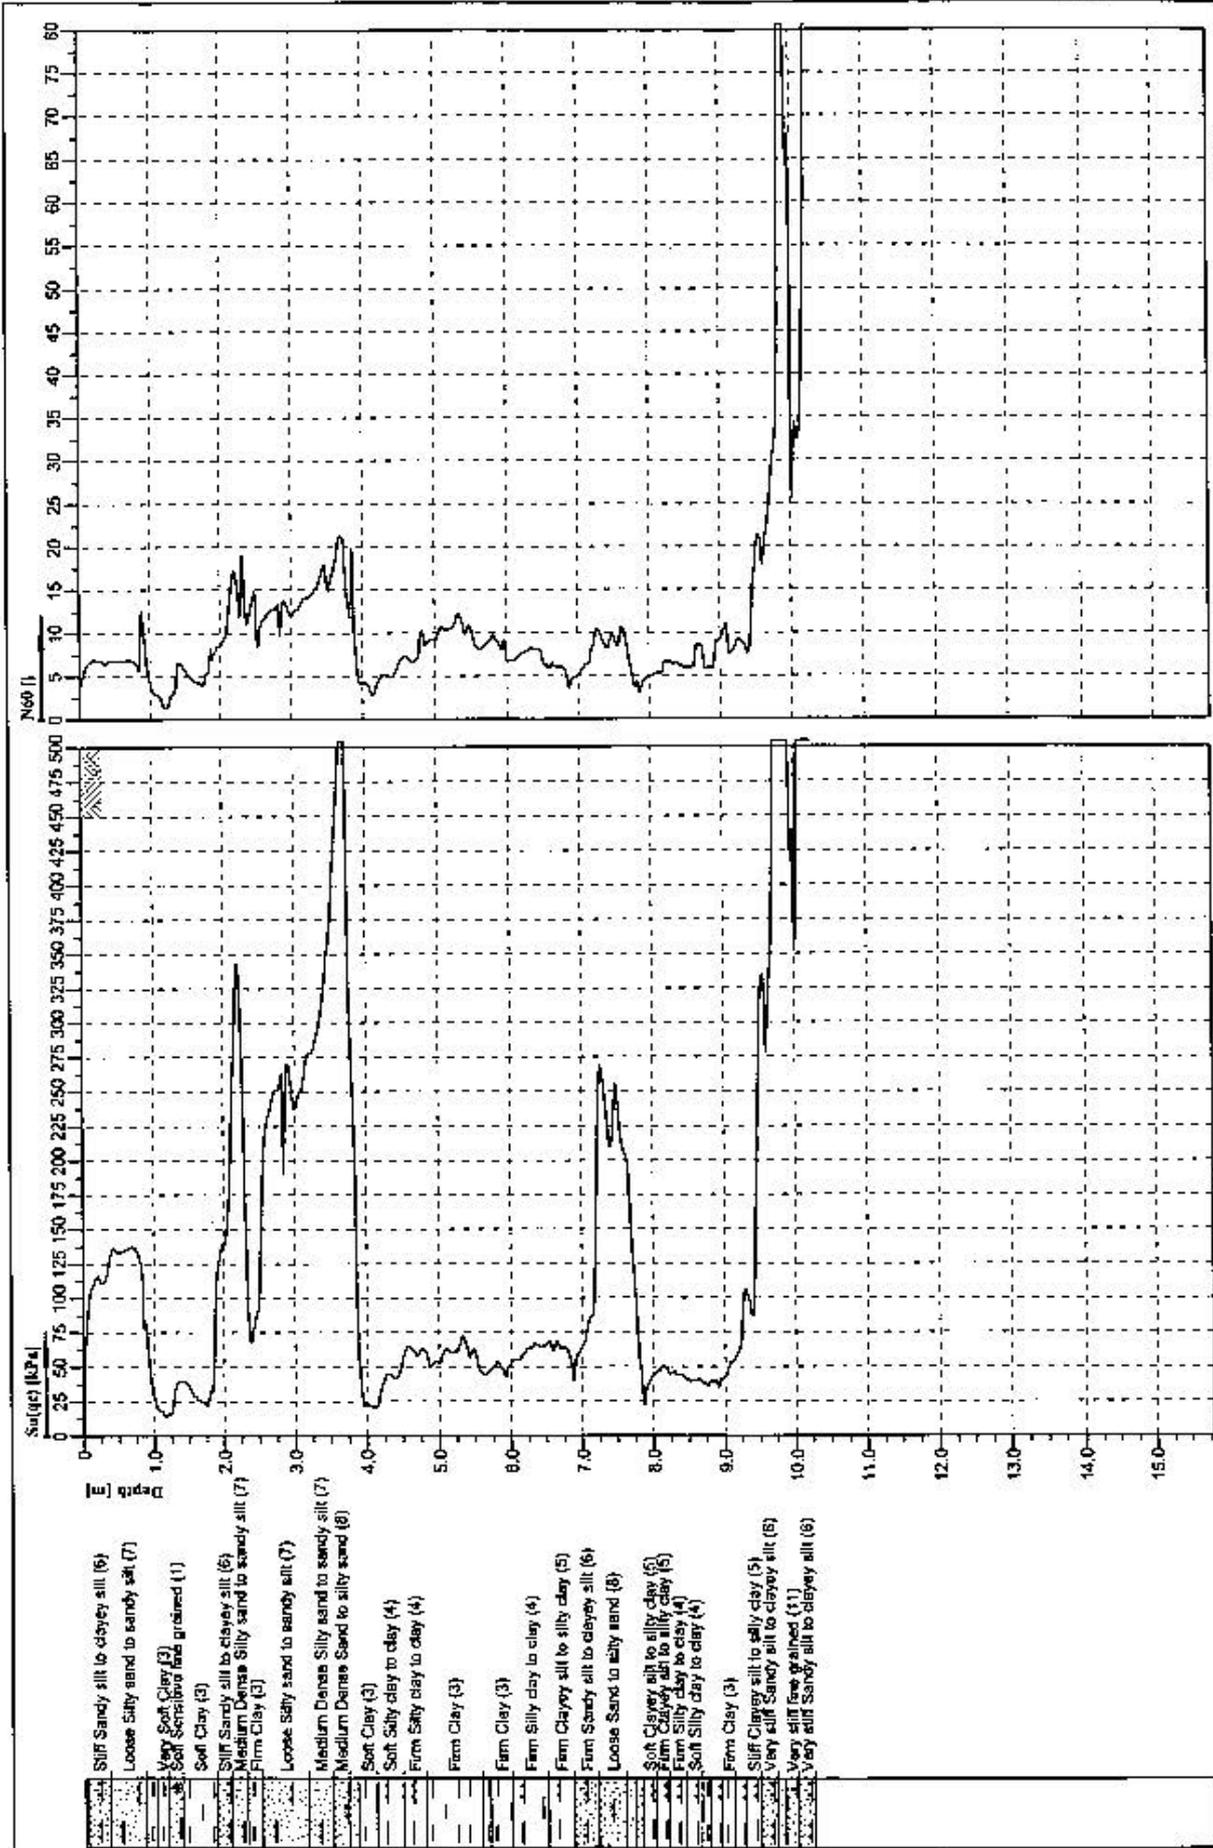


- Sluff Sandy silt to clayey silt (6)
- Loose Silty sand to sandy silt (7)
- Very Soft Clay (3)
- Soft Sensation fine grained (1)
- Soft Clay (3)
- Sluff Sandy silt to clayey silt (6)
- Medium Dense Silty sand to sandy silt (7)
- Firm Clay (3)
- Loose Silty sand to sandy silt (7)
- Medium Dense Silty sand to sandy silt (7)
- Medium Dense Sand to silty sand (8)
- Soft Clay (3)
- Soft Silty clay to clay (4)
- Firm Silty clay to clay (4)
- Firm Clay (3)
- Firm Clay (3)
- Firm Silty clay to clay (4)
- Firm Clayey silt to silty clay (5)
- Firm Sandy silt to clayey silt (6)
- Loose Sand to silty sand (8)
- Soft Clayey silt to silty clay (5)
- Firm Clayey silt to silty clay (5)
- Firm Silty clay to clay (4)
- Soft Silty clay to clay (4)
- Firm Clay (3)
- Sluff Clayey silt to silty clay (5)
- Very silty Sandy silt to clayey silt (6)
- Very silty fine grained (1)
- Very silty Sandy silt to clayey silt (6)

Location:	MANGAWHAI HEADS	Position:	X: 0.00 m, Y: 0.00 m
Project ID:	D1131	Client:	TONKIN & TAYLOR LTD
Project:	MANGAWHAI HEADS SEWER PLANT - 23428.001	Ground level:	Test no: CPT4
		Draw:	1705/2006
		Scale:	1 : 100
		Page:	1/1
		Fig:	
		File:	cpt15.001



Cone No: 0
 Tip area (m²): 10
 Sleeve area (m²): 150

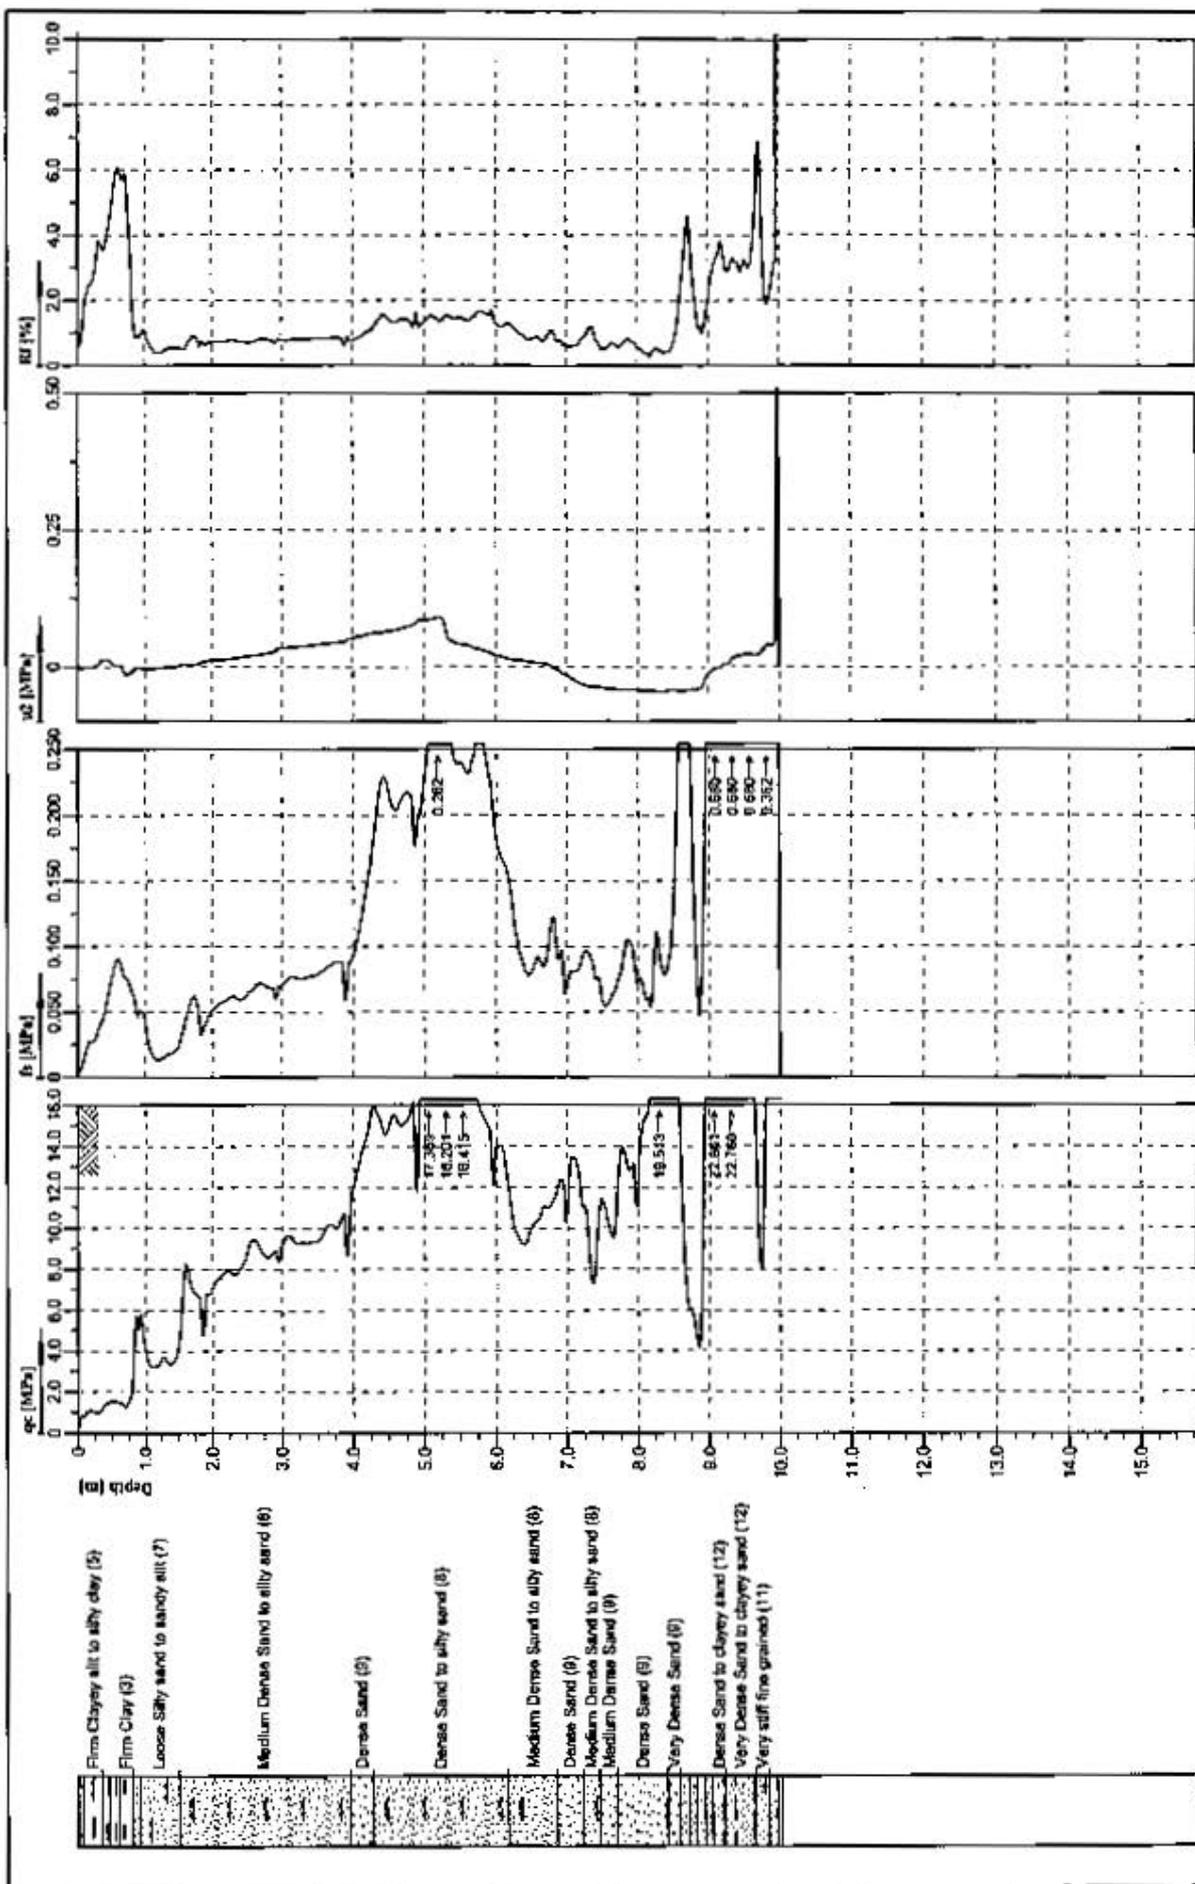

Location:	MANGAWHAI HEADS	Position:	X: 0.00 m, Y: 0.00 m	Test no:	CPT5
Project ID:	D1131	Client:	TONKIN & TAYLOR LTD	Date:	17/05/2006
Project:	MANGAWHAI HEADS SEWER PLANT - 23428.001	Page:	1/1	Scale:	1 : 100
		File:	CPT5.002		




 Cone No. 0

 Tip area (cm²): 10

 Sleeve area (cm²): 150



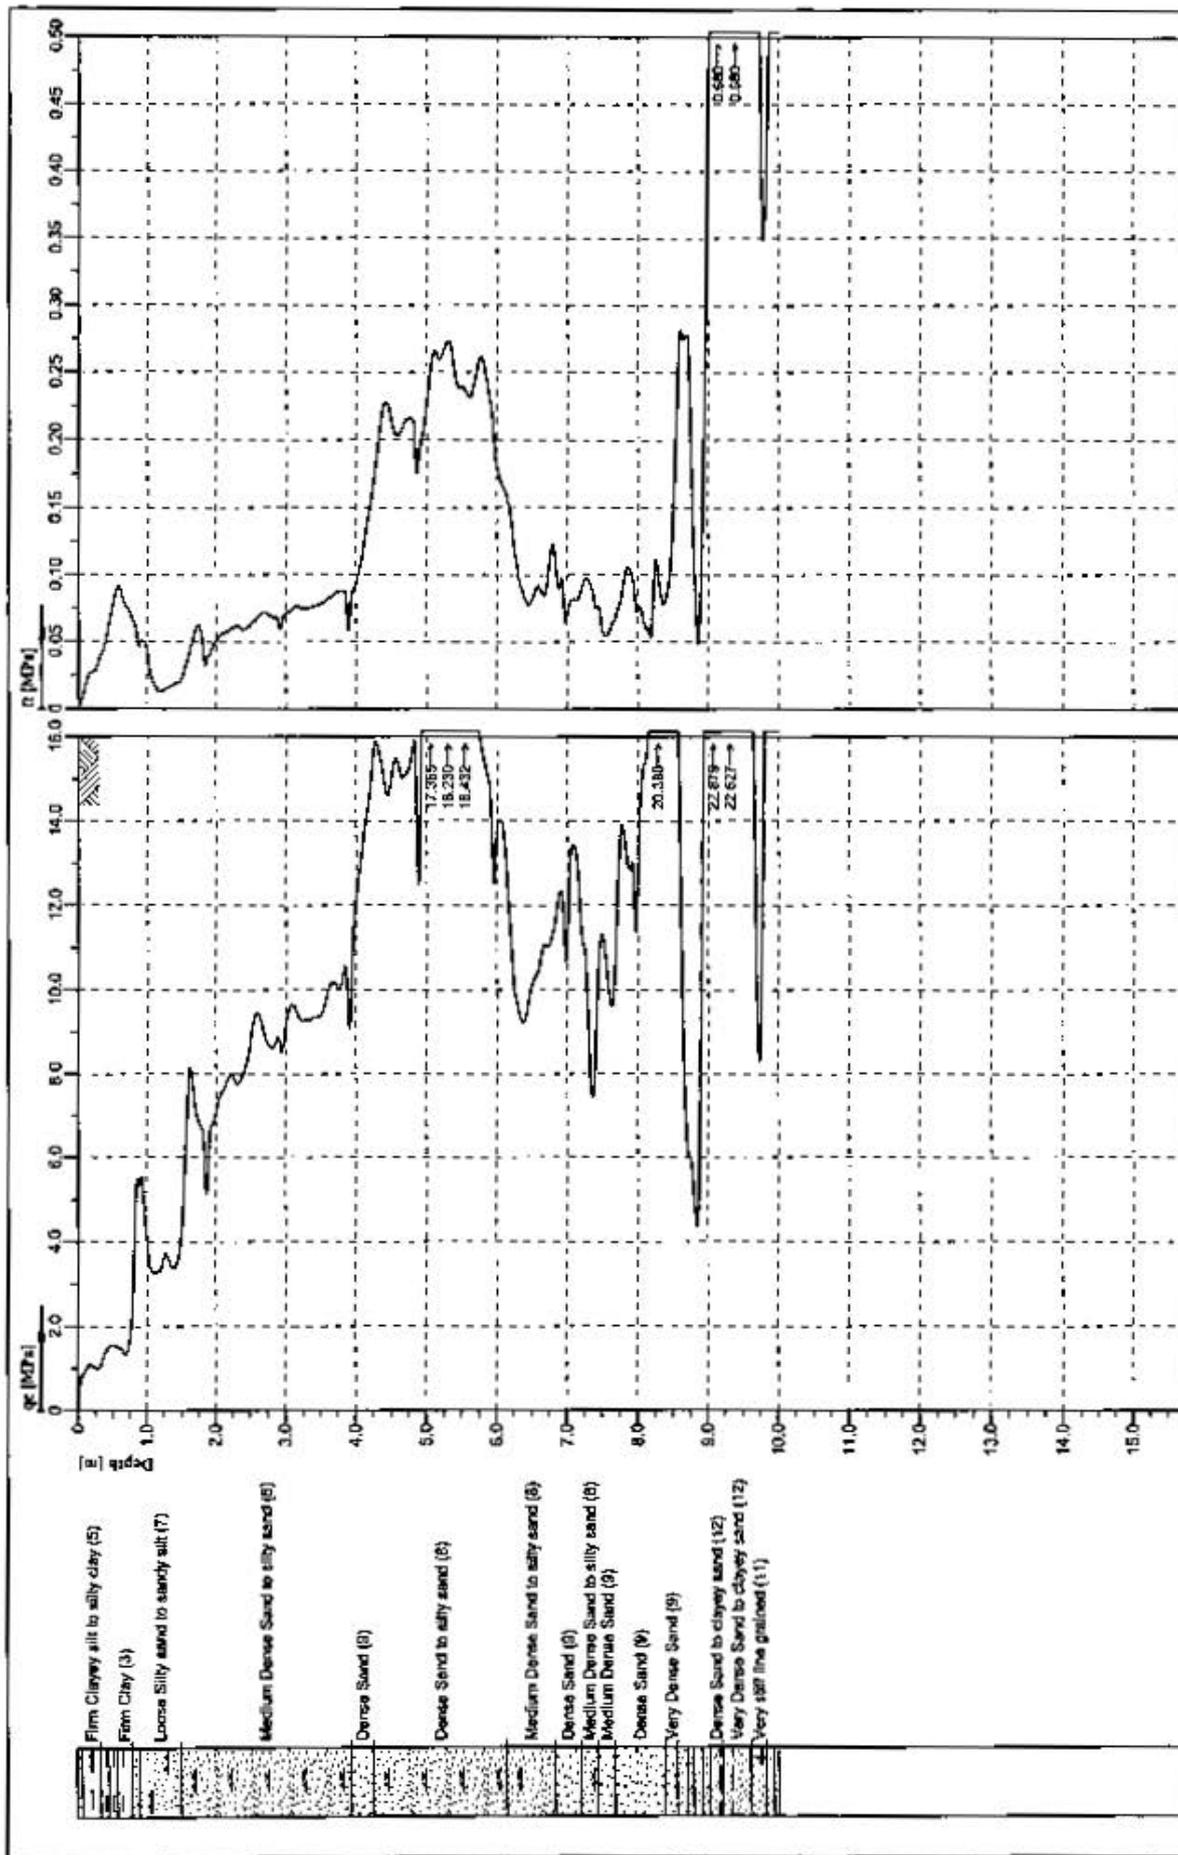


Location:	MANGAWHAI HEADS	Position:	X: 0.00 m, Y: 0.00 m	Ground level:	0.00	Test no.:	CPT5
Project ID:	D1131	Client:	TOKIN & TAYLOR LTD	Date:	17/05/2008	Scale:	1 : 100
Project:	MANGAWHAI HEADS SEWER PLANT - 23428.001	Page:	1/1	Fig:		File:	CPT5.002




Cone No: 2
 Tip area (cm²): 10
 Sleeve area (cm²): 189



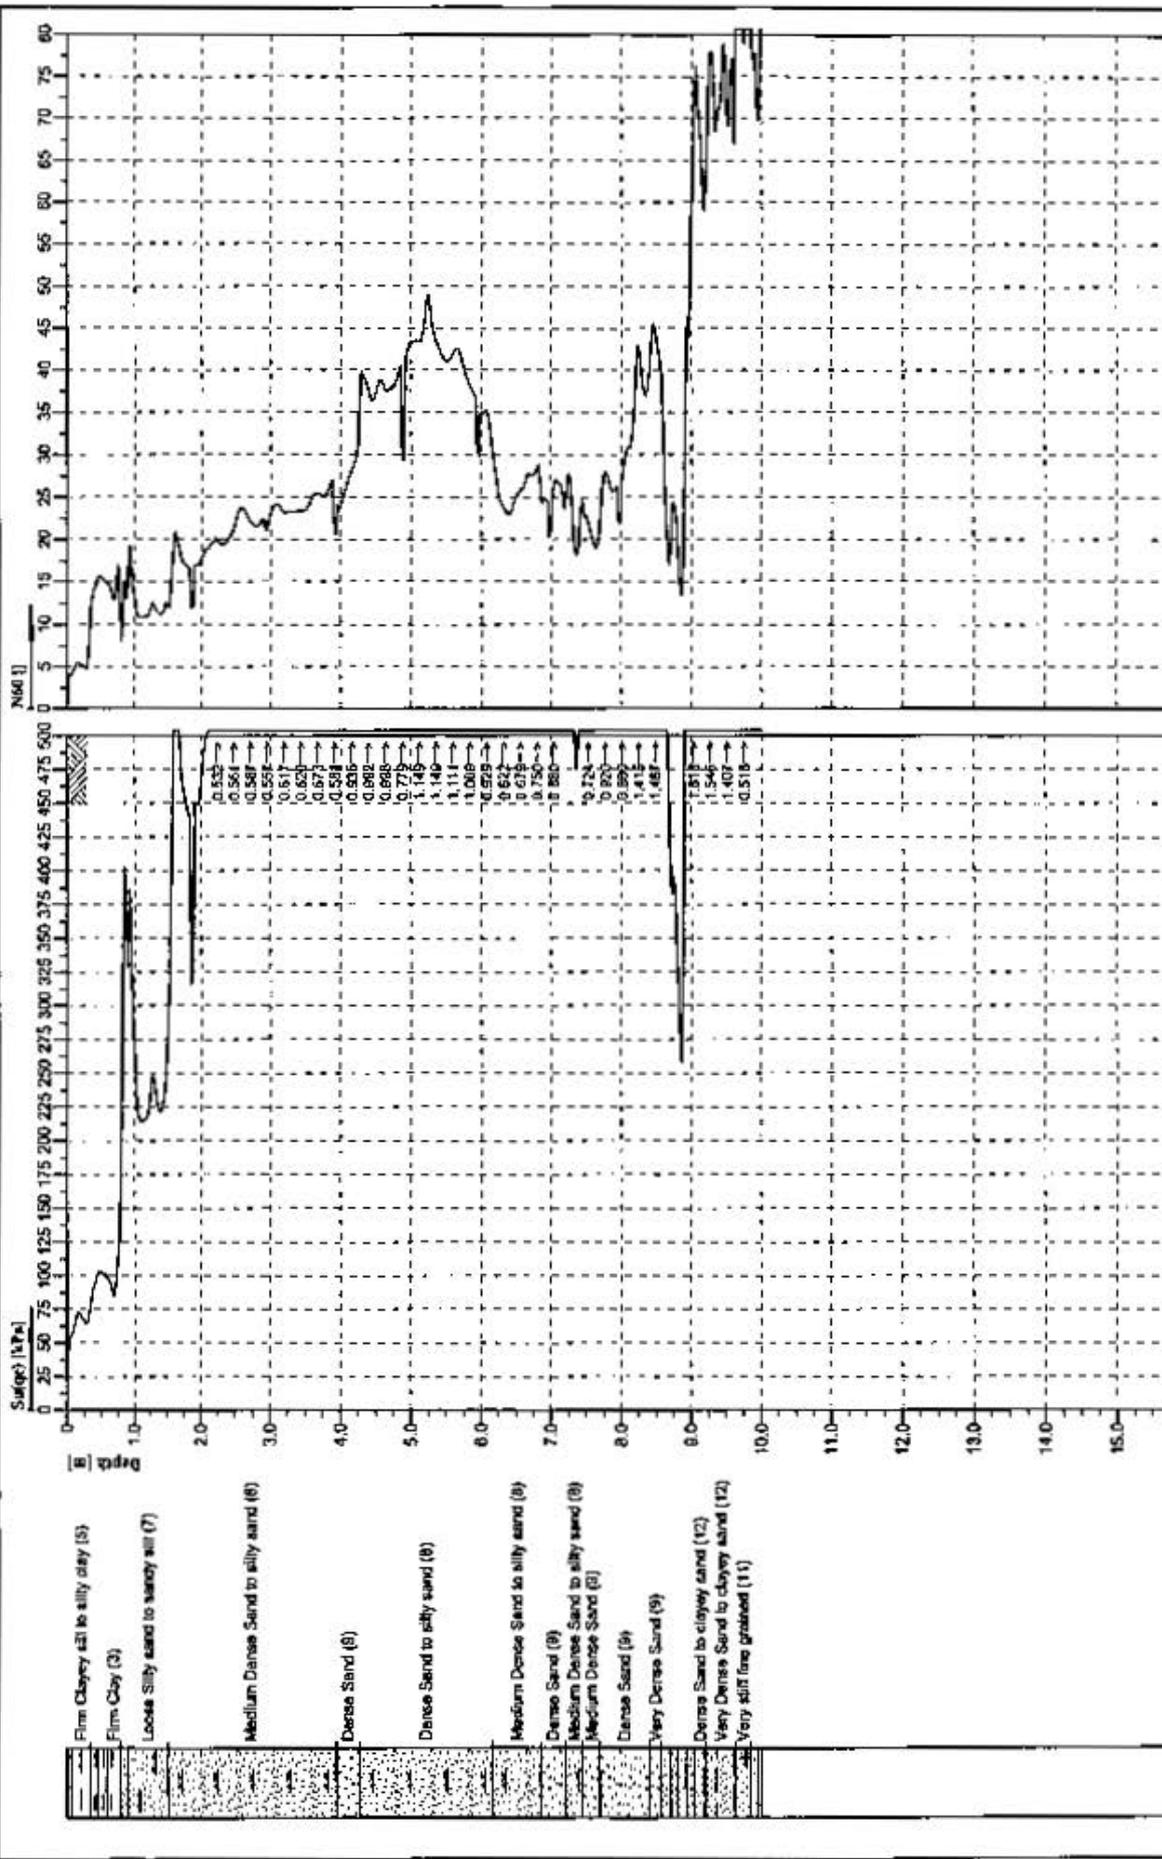

Location: MANGAWHAI HEADS
 Position: X: 0.00 m, Y: 0.00 m
 Project ID: D1131
 Client: TONKIN & TAYLOR LTD
 Project: MANGAWHAI HEADS SEWER PLANT - 23428.001
 Ground level: 0.00
 Test no: CPTS
 Date: 17/05/2006
 Scale: 1 : 100
 Page: 1/1
 File: CPTS.002

M.L.
 DE
 DESIGN ENGINEERING
 CONSULTANTS LTD.
 Suite 101, 150

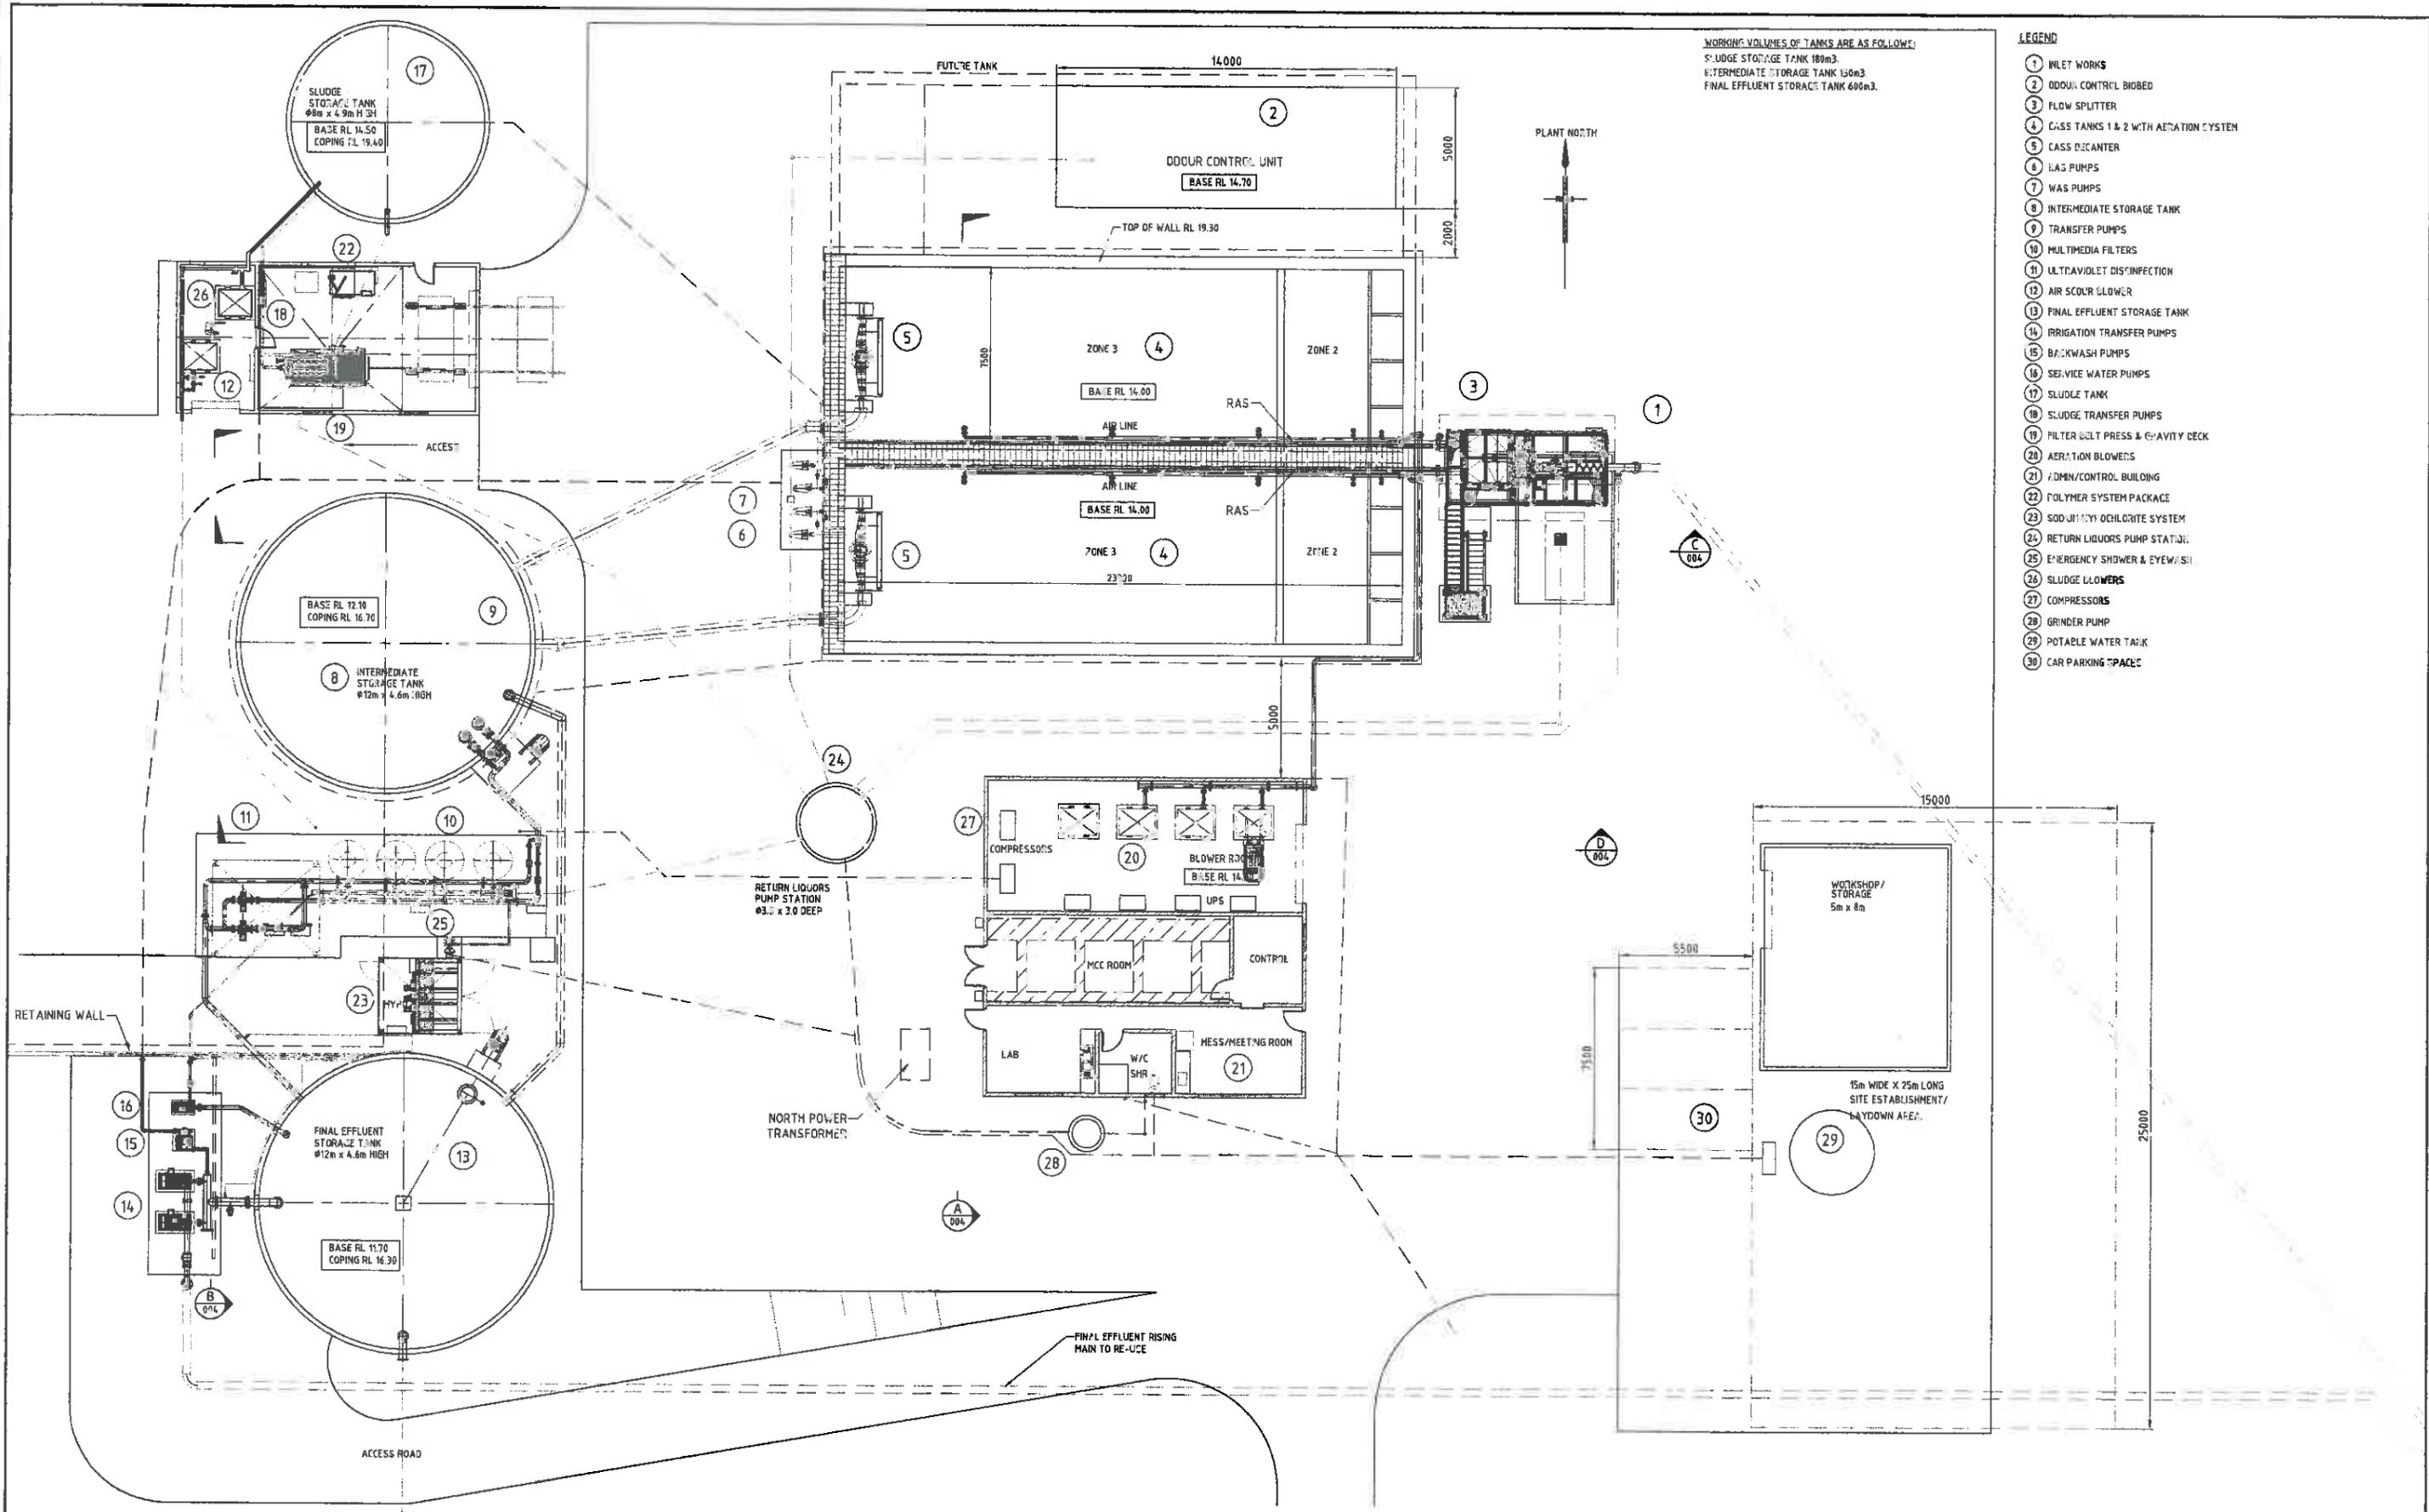


WORKING VOLUMES OF TANKS ARE AS FOLLOWS:
 SLUDGE STORAGE TANK 180m³
 FINAL EFFLUENT STORAGE TANK 600m³

- LEGEND**
- 1 INLET WORKS
 - 2 ODOUR CONTROL BIOTED
 - 3 FLOW SPLITTER
 - 4 CASS TANKS 1 & 2 WITH AERATION SYSTEM
 - 5 CASS DECANTER
 - 6 GAS PUMPS
 - 7 WAS PUMPS
 - 8 INTERMEDIATE STORAGE TANK
 - 9 TRANSFER PUMPS
 - 10 MULTIMEDIA FILTERS
 - 11 ULTRAVIOLET DISINFECTION
 - 12 AIR SCOUR FLOWER
 - 13 FINAL EFFLUENT STORAGE TANK
 - 14 IRRIGATION TRANSFER PUMPS
 - 17 SLUDGE TANK
 - 18 SLUDGE TRANSFER PUMPS
 - 19 FILTER BOLT PRESS & GRAVITY DECK
 - 20 AERATION BLOWERS
 - 21 ADMIN/CONTROL BUILDING
 - 22 POLYMER SYSTEM PACKAGE
 - 24 RETURN LIQUORS PUMP STATION
 - 25 EMERGENCY SHOWER & EYEWASH
 - 26 SLUDGE LOWERS
 - 27 COMPRESSORS
 - 28 GRINDER PUMP
 - 29 POTABLE WATER TANK
 - 30 CAR PARKING SPACE

REV	DESCRIPTION	DRN	DATE	CHK	APP
J	DRAIN MODIFICATIONS	DIJ	19.1.09	CJ	RJ
H	GENERAL REVISIONS	DIJ	9.1.09	CJ	RJ
G	REVISED	DIJ	22.9.08	CJ	RJ
F	REVISED	DIJ	9.9.08	CJ	RJ
E	REVISED SITE ARRANGEMENT	DIJ	3.9.08	C.J.	C.J.
D	INLET WORKS UPDATED	DIJ	5.8.08	AC	IF
C	GENERAL MODIFICATIONS	DIJ	10.7.08	AC	IF
B	CASS TANKS UPSIZED, CONTROL BUILDING ALTERED	DIJ	16.4.08	AC	IF
AC	AS CONSTRUCTED	DIJ	7.7.09	RJ	CJ

AS CONSTRUCTED
 Information supplied by construction contractor

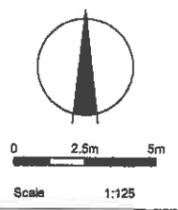


EARTH TEAM
 Global Water Projects and Products
 Melbourne - Tel 8517 9200

Designed: A.CHAPLIN
 Drawn: D.JOULES
 Checked: A.CHAPLIN
 Approved: I.FONES

MANGAWHAI ECOCARE
 MANGAWHAI INFRASTRUCTURE PROJECT


TREATMENT PLANT
 GENERAL ARRANGEMENT

Drawing No. A-89973-CIV-7303 Rev AC
 Sheet No. 86973
 © Earth Tech Engineering Pty Ltd ABN 61 099 482 888 A1

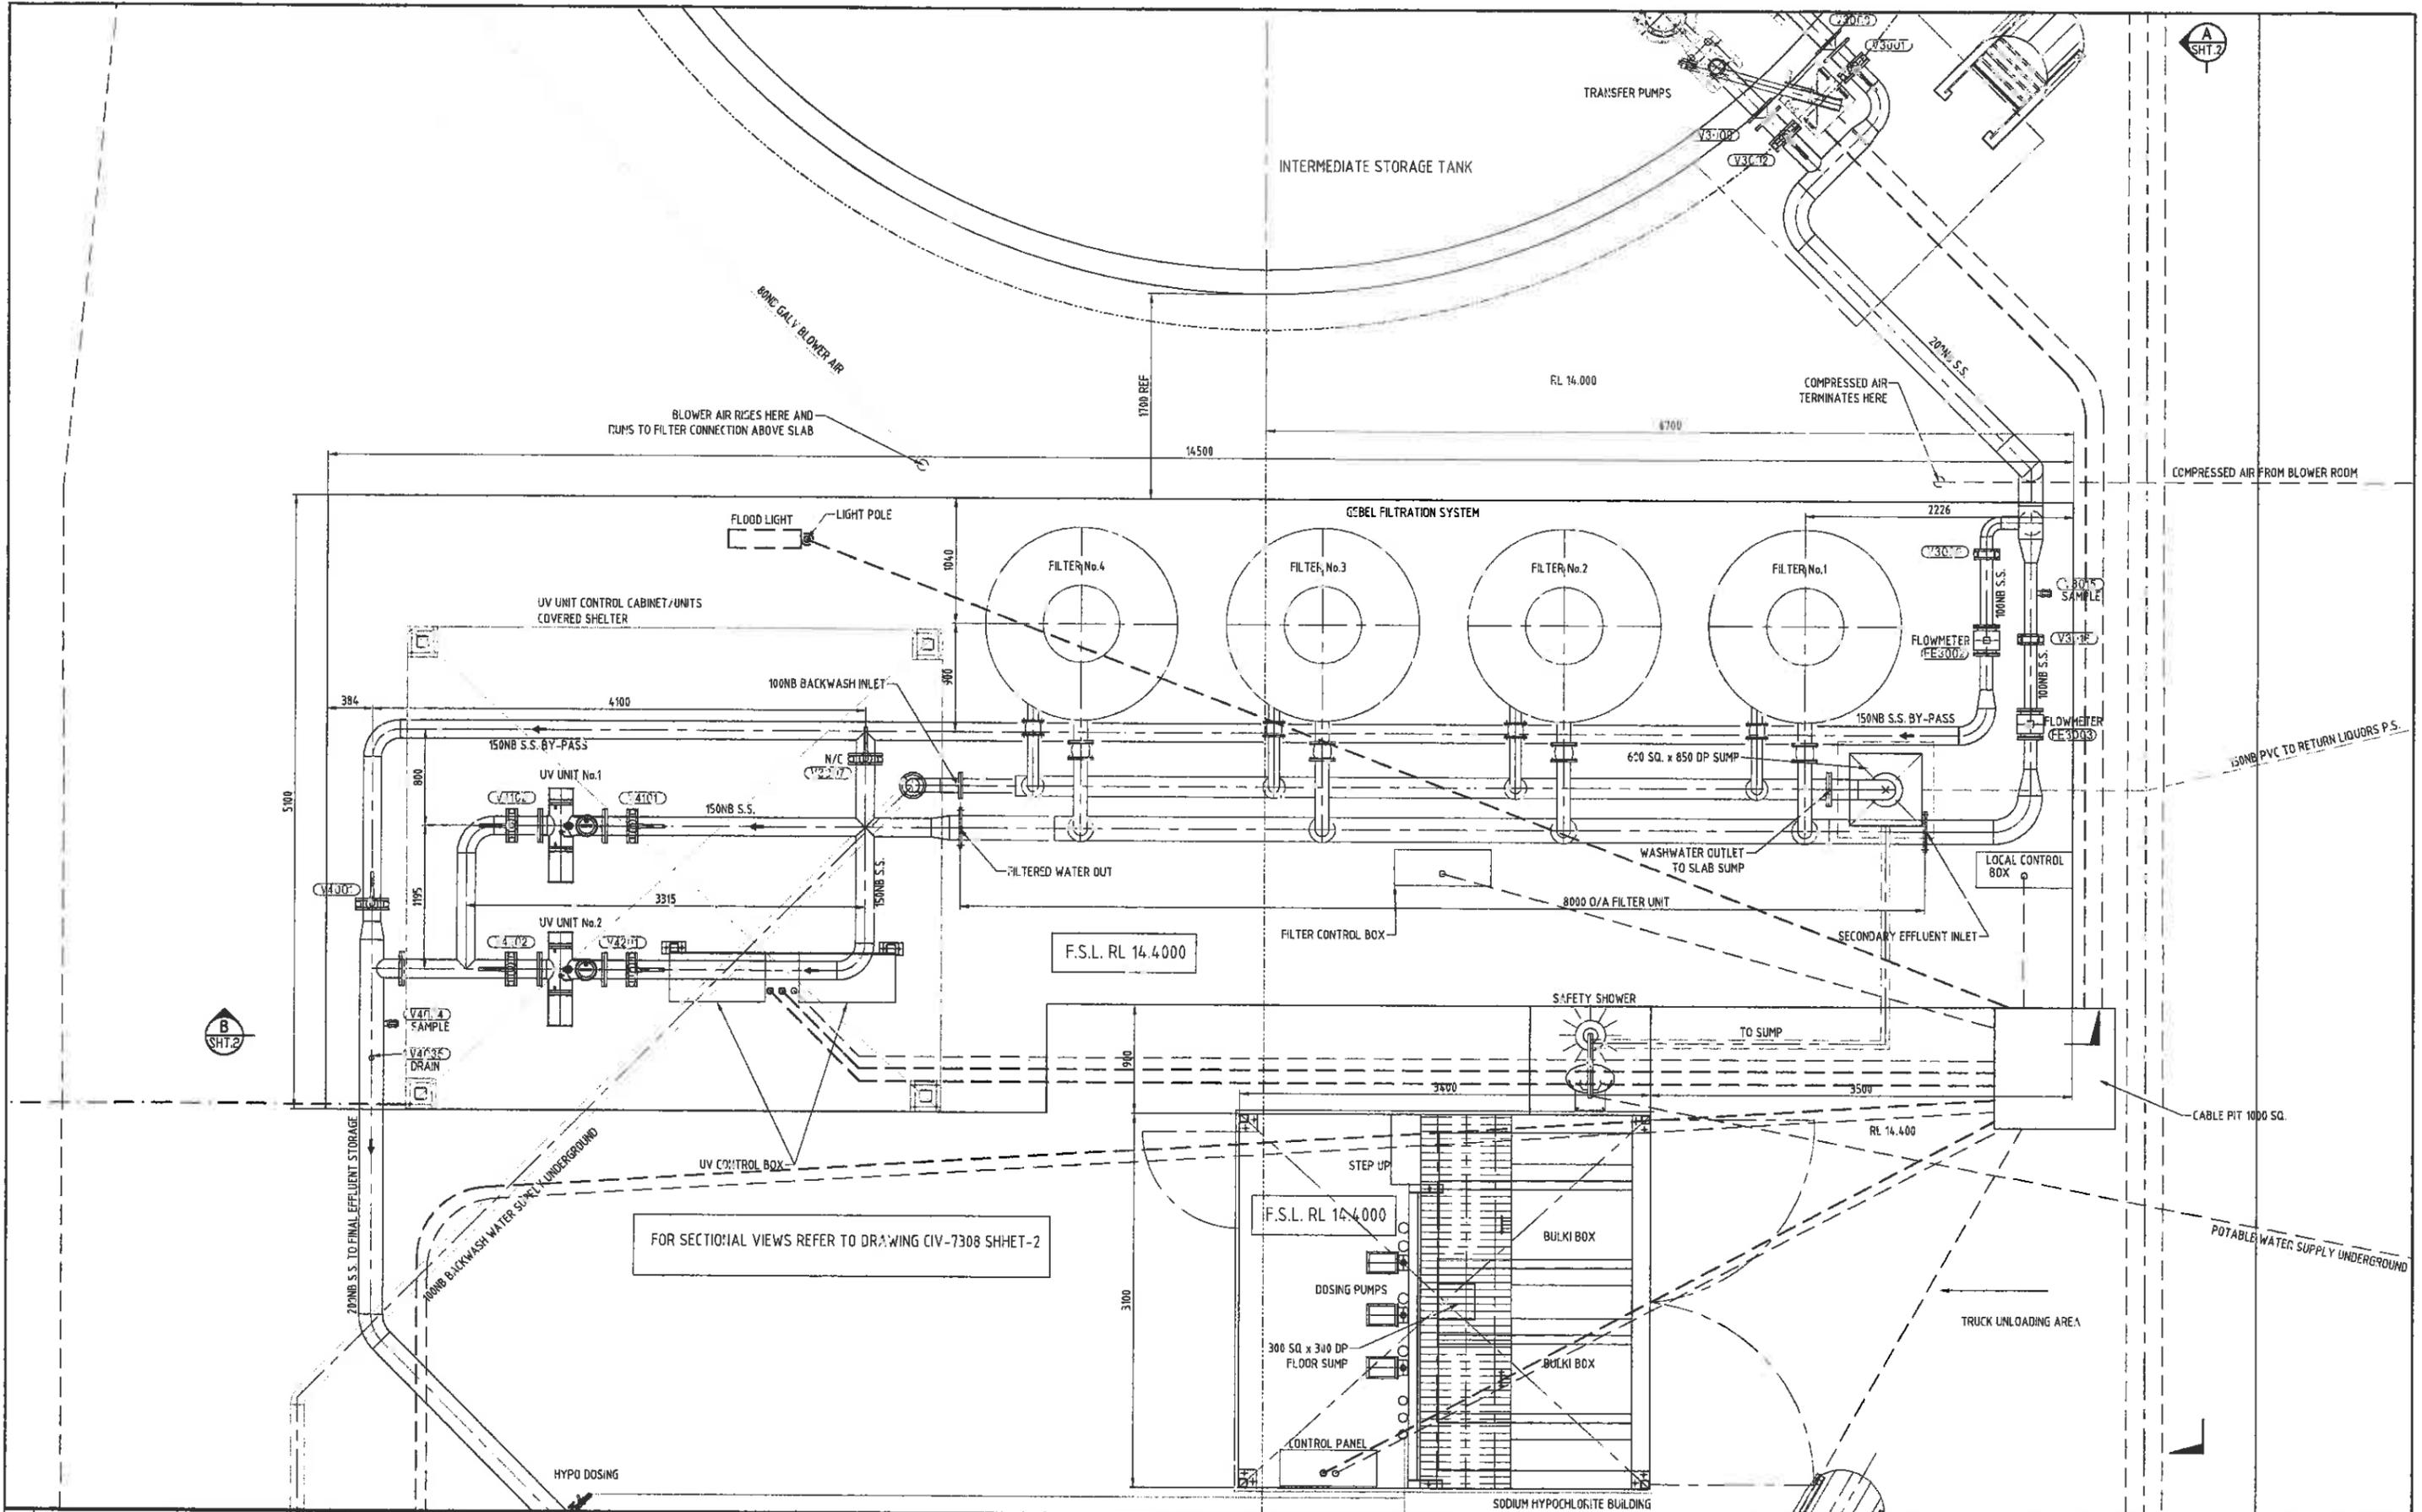

FOR SECTIONAL VIEWS REFER TO DRAWING CIV-7308 SHEET-2


AS CONSTRUCTED
Information supplied by construction contractor

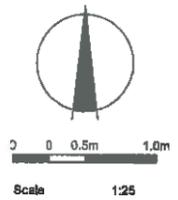

EARTH TECH
Water Infrastructure Group
Melbourne - Tel 98633500
Designed R. JOHNSON
Drawn D. JOULES
Checked C. JOHNSTON
Approved X


MANGAWHAI ECOCARE
MANGAWHAI INFRASTRUCTURE PROJECT
ULTRAVIOLET DISINFECTION & SODIUM HYPOCHLORITE ARRANGEMENT-SHEET-1
Drawing No. A1-89973-CIV-7308 Rev AC
Sheet No. SHEET 1 89973
© Earth Tech Engineering Pty Ltd ABN 61 088 482 013 A1

REV	DESCRIPTION	DRN	DATE	CHK	APP
AC	AS CONSTRUCTED	DU	8.7.09	RJ	CJ

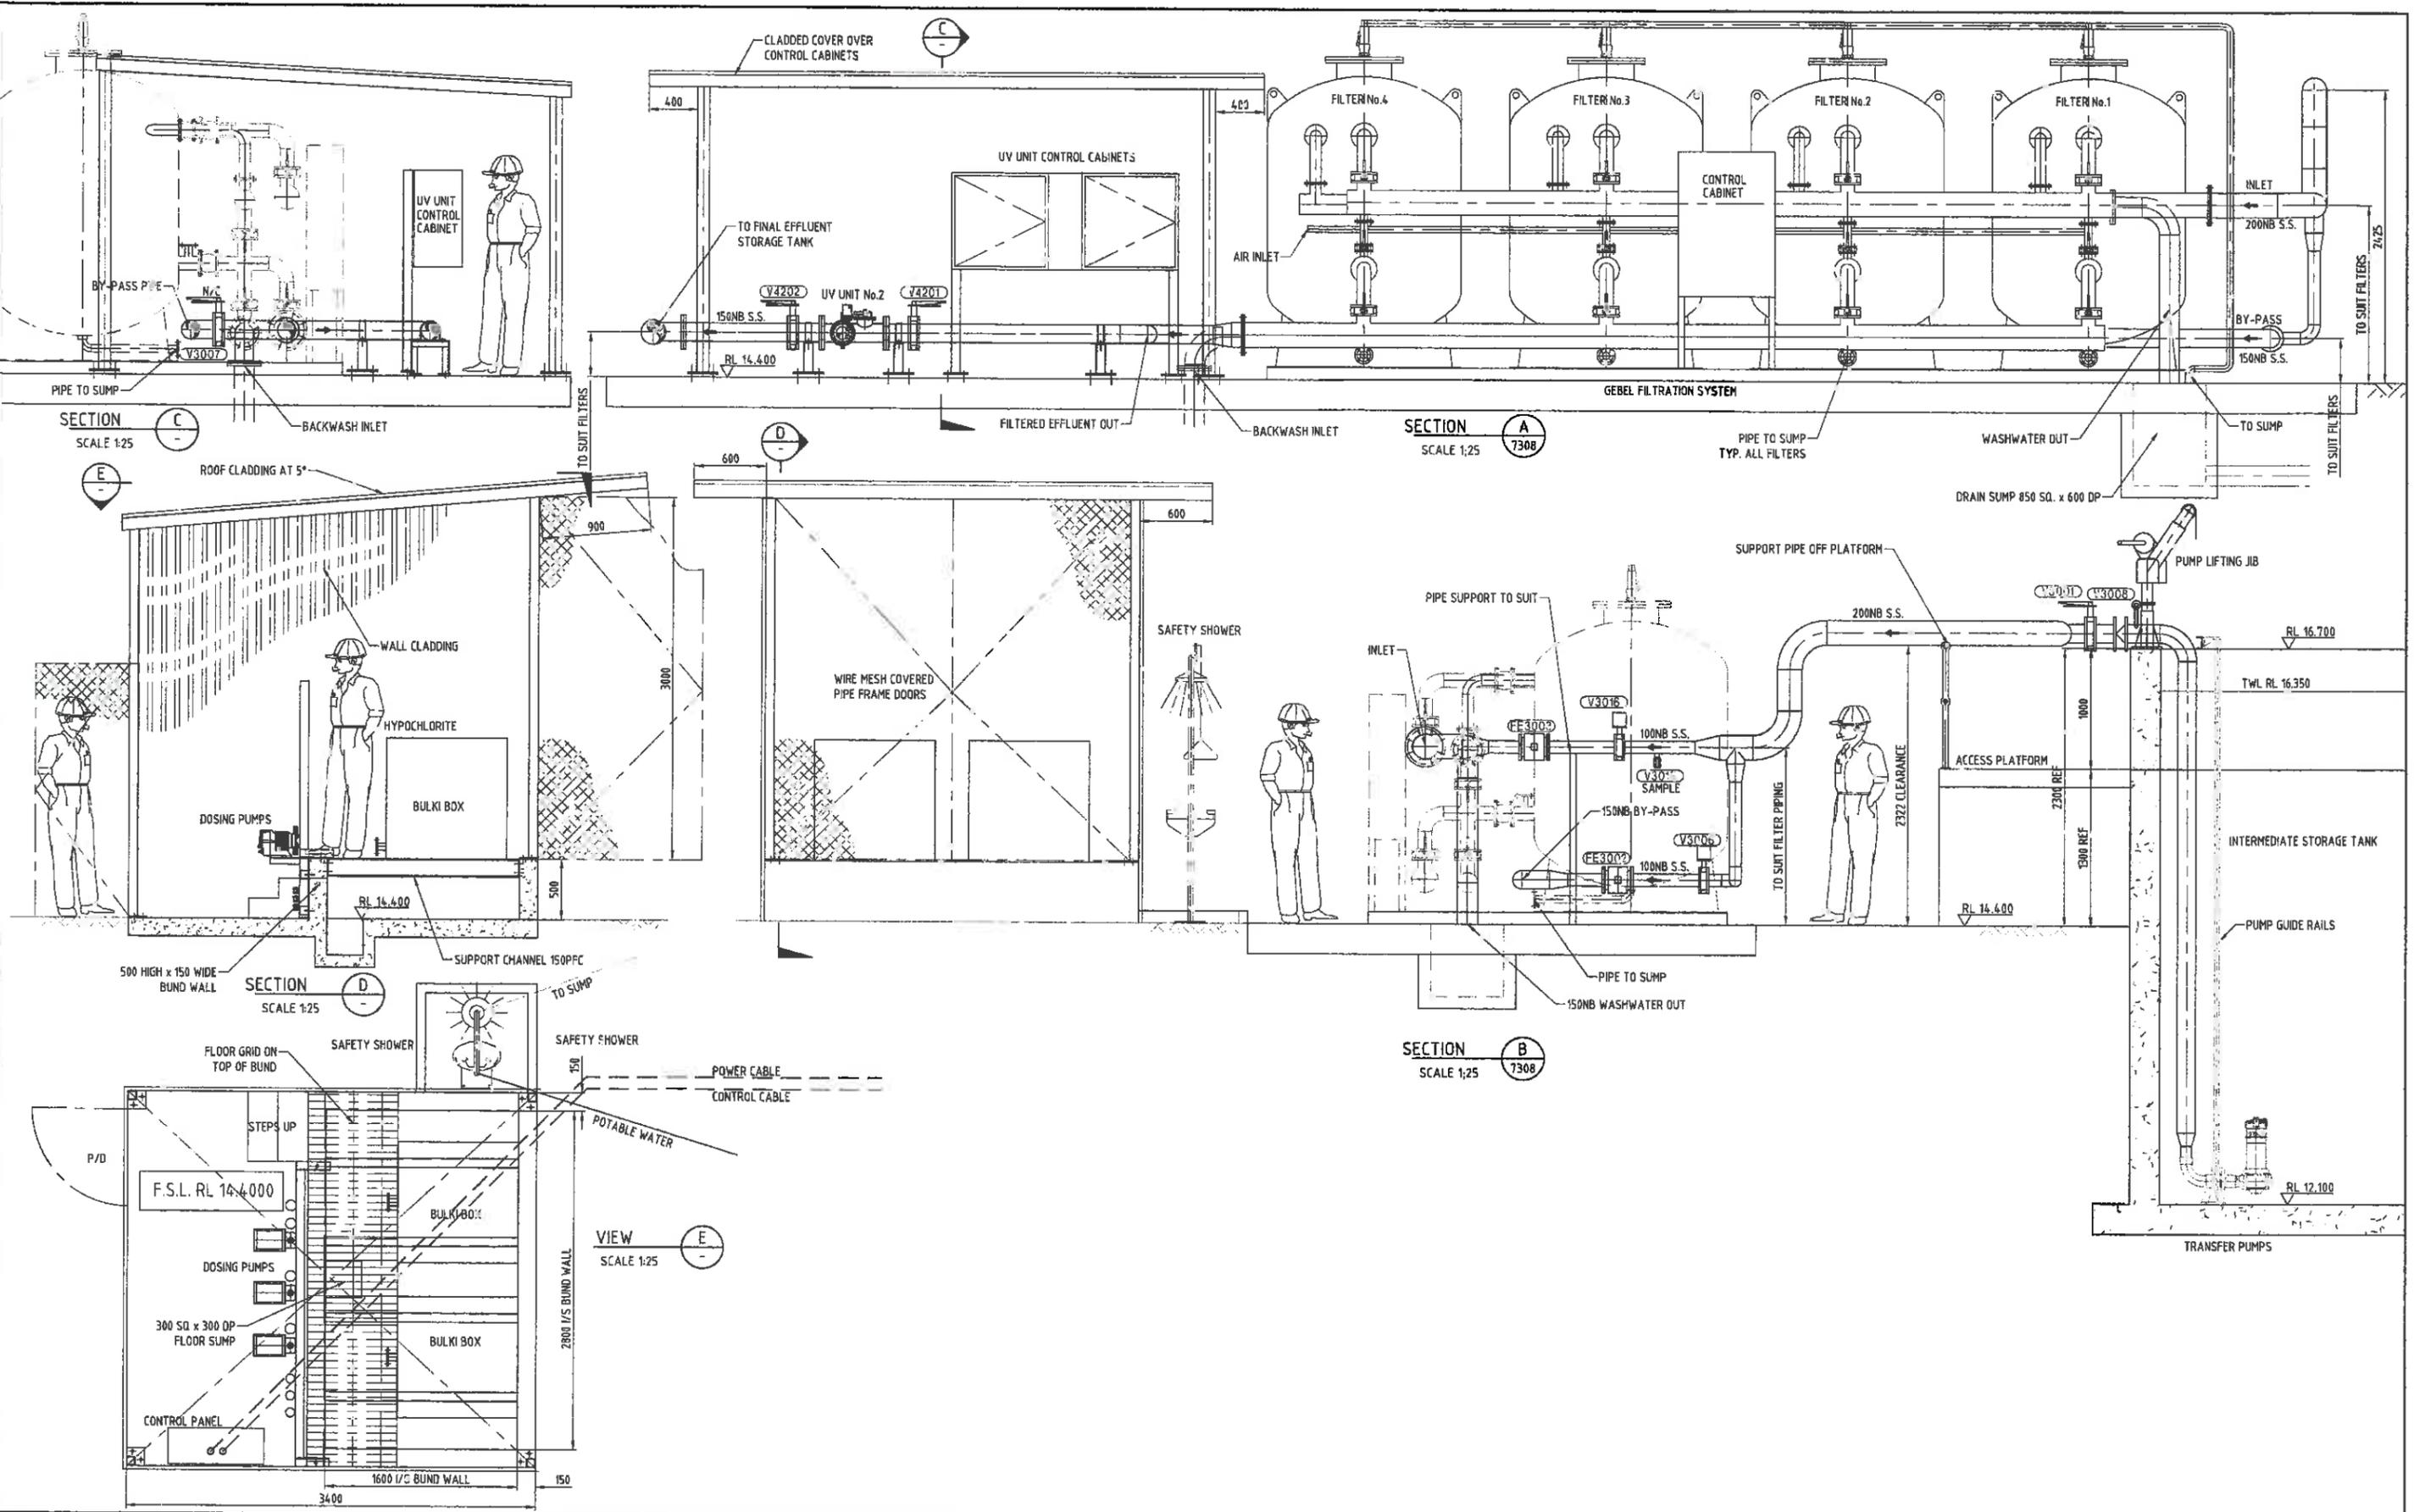

REV	DESCRIPTION	DRN	DATE	CHK	APP
0	ISSUED FOR CONSTRUCTION	DJ	24.4.09	RJ	CJ
C	COVER OVER UV AND DRAINAGE SUMP ALTERED	DJ	26.3.09	RJ	CJ
B	HYPO BUILDING ALTERED	DJ	29.2.09	CJ	RJ
A	ISSUED FOR APPRVAL	DJ	18.2.09	CJ	RJ

ISSUED FOR CONSTRUCTION

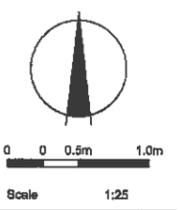

EARTH TECH


Water Infrastructure Group
Melbourne - Tel 98633500

Designed R.JOHNSON
Drawn D.JOULES
Checked C.JOHNSTON
Approved X

MANGAWHAI ECOCARE
MANGAWHAI INFRASTRUCTURE PROJECT


ULTRAVIOLET DISINFECTION & SODIUM HYPOCHLORITE SECTIONS SHEET-2

Drawing No. A-89973-CIV-7308 Rev 0
Sheet No. SHEET 2 89973
© Earth Tech Engineering Pty Ltd ABN 61 009 452 010 A1

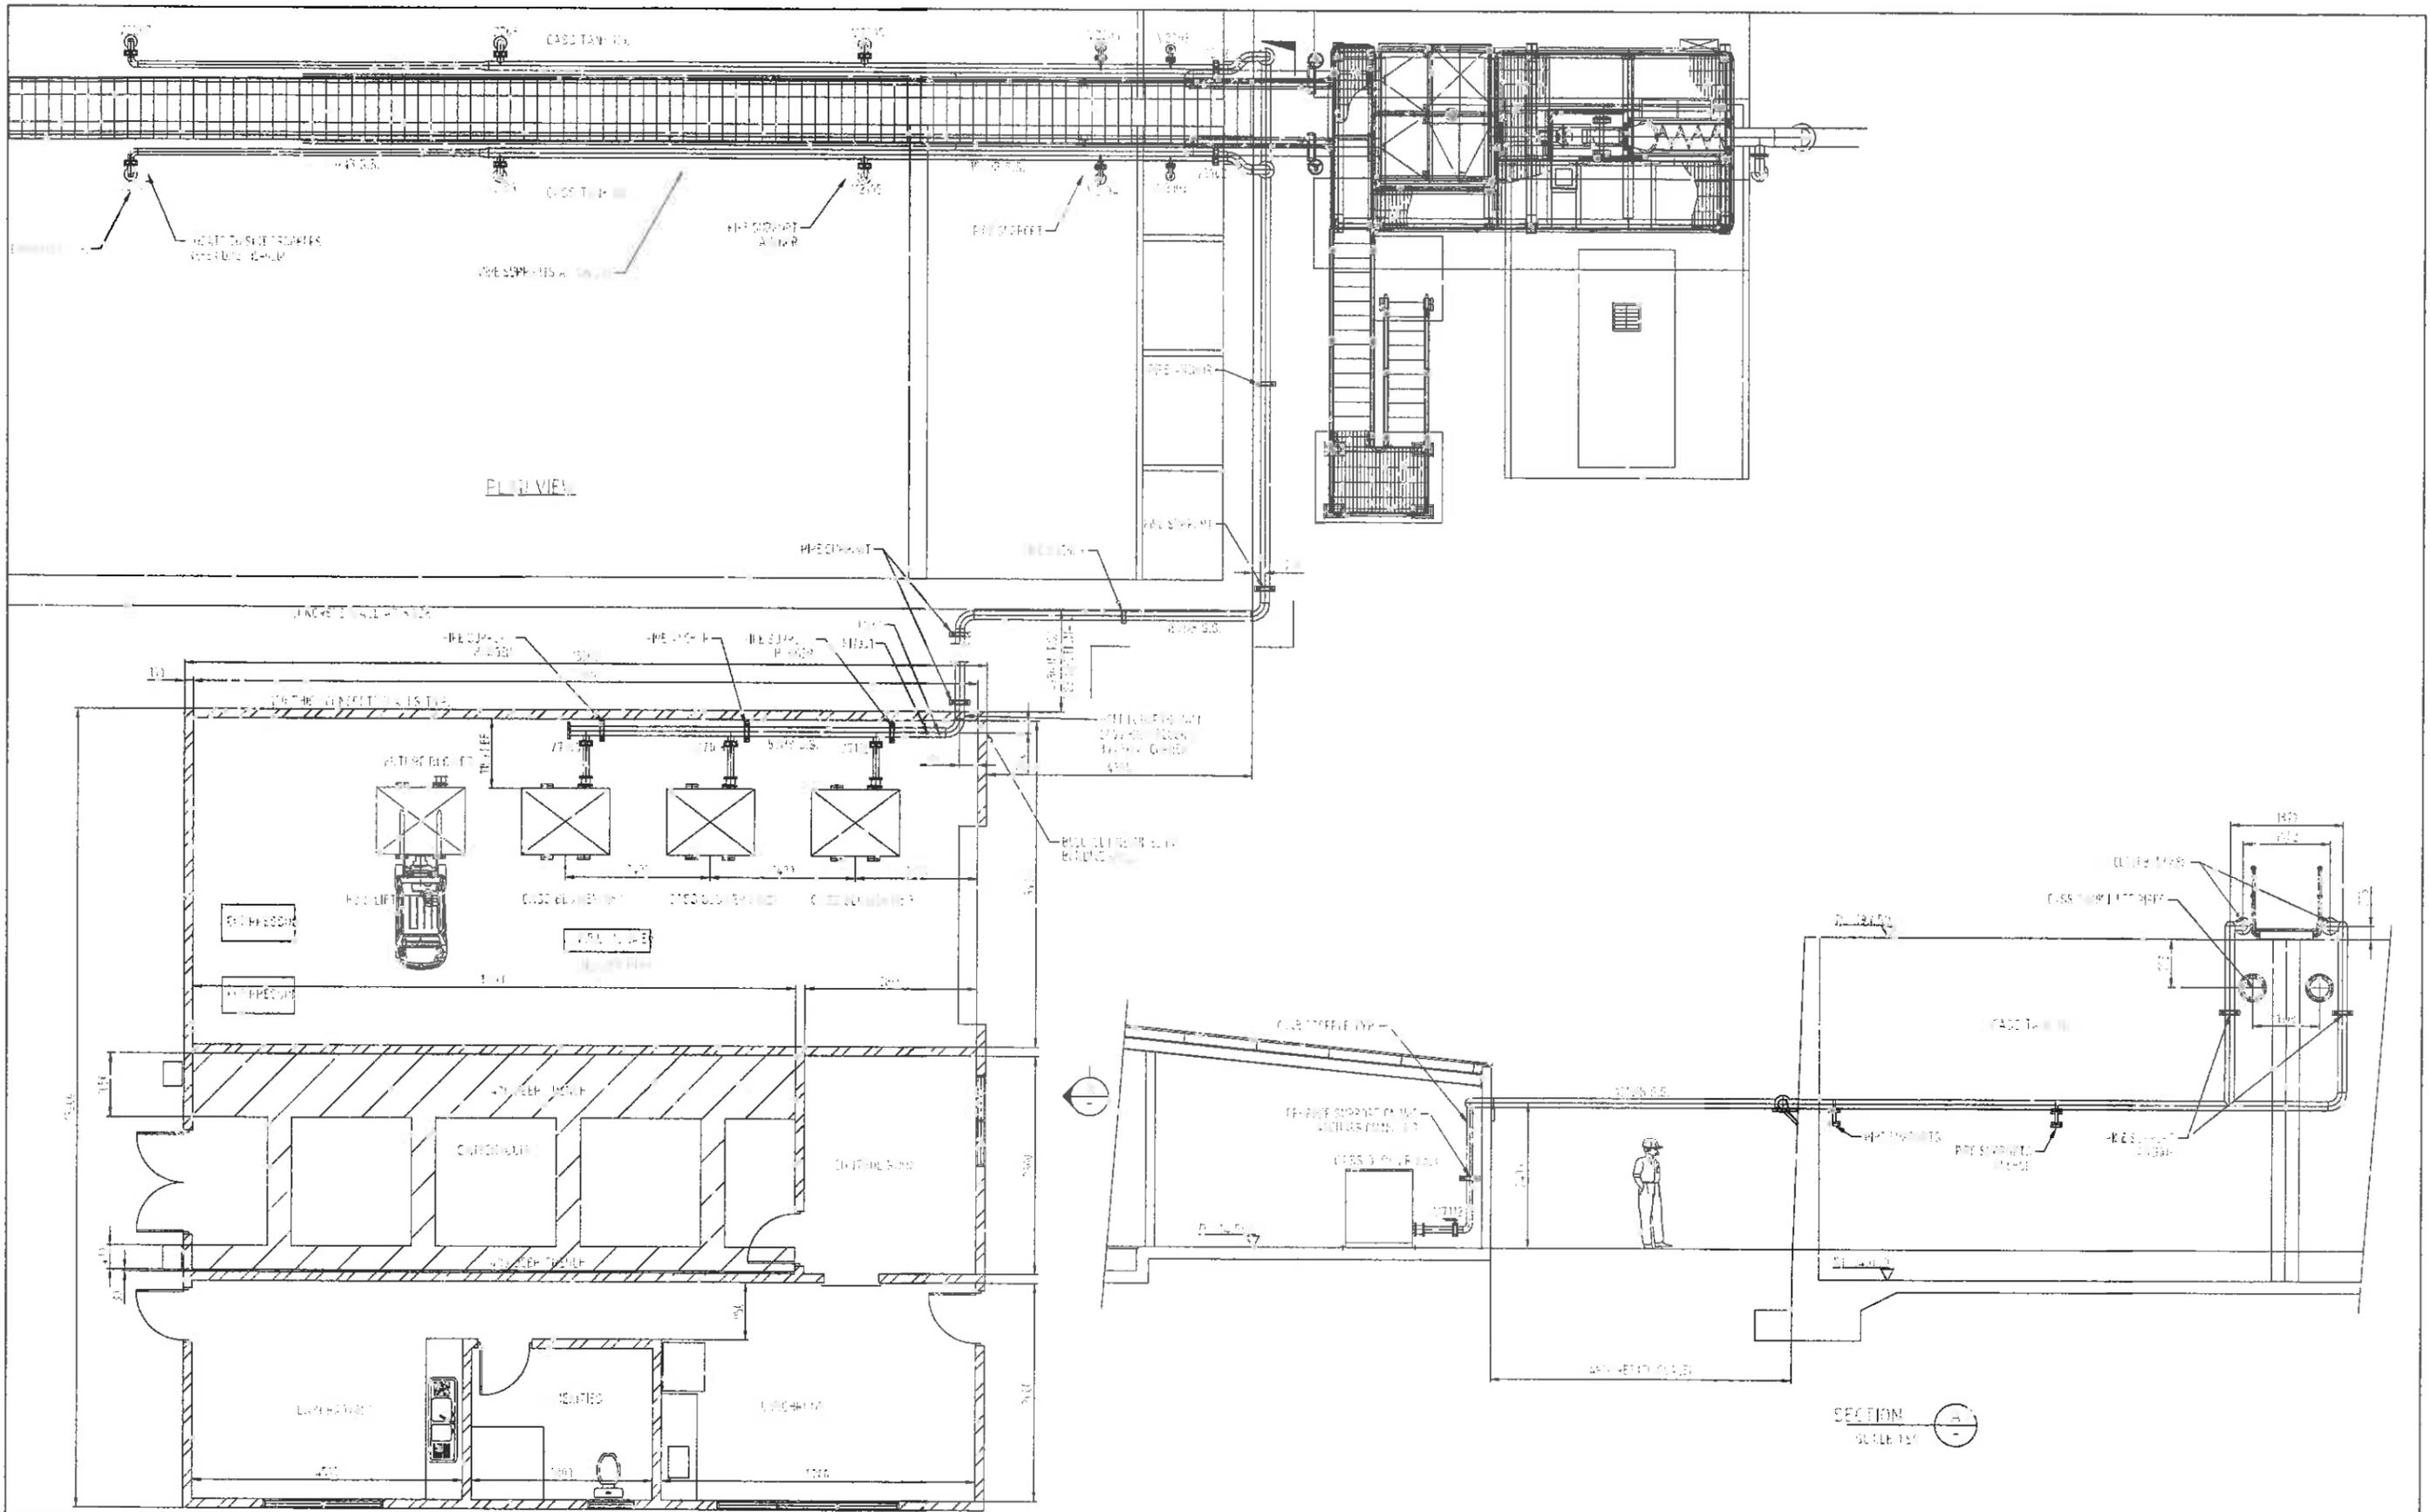

AS BUILT


REV	DESCRIPTION	DRN	DATE	CHK	APP
0	AS BUILT		27.07.10		

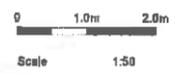

MANGAWHAI ECO-CARE
MANGAWHAI INFRASTRUCTURE PROJECT

MAIN BUILDING
EQUIPMENT & PIPING ARRANGEMENT

Drawing No. A-89973-CIV-7311 Rev 0
Sheet No. 89973
© Earth Tech Engineering Pty Ltd ABN 61 080 482 888 A1

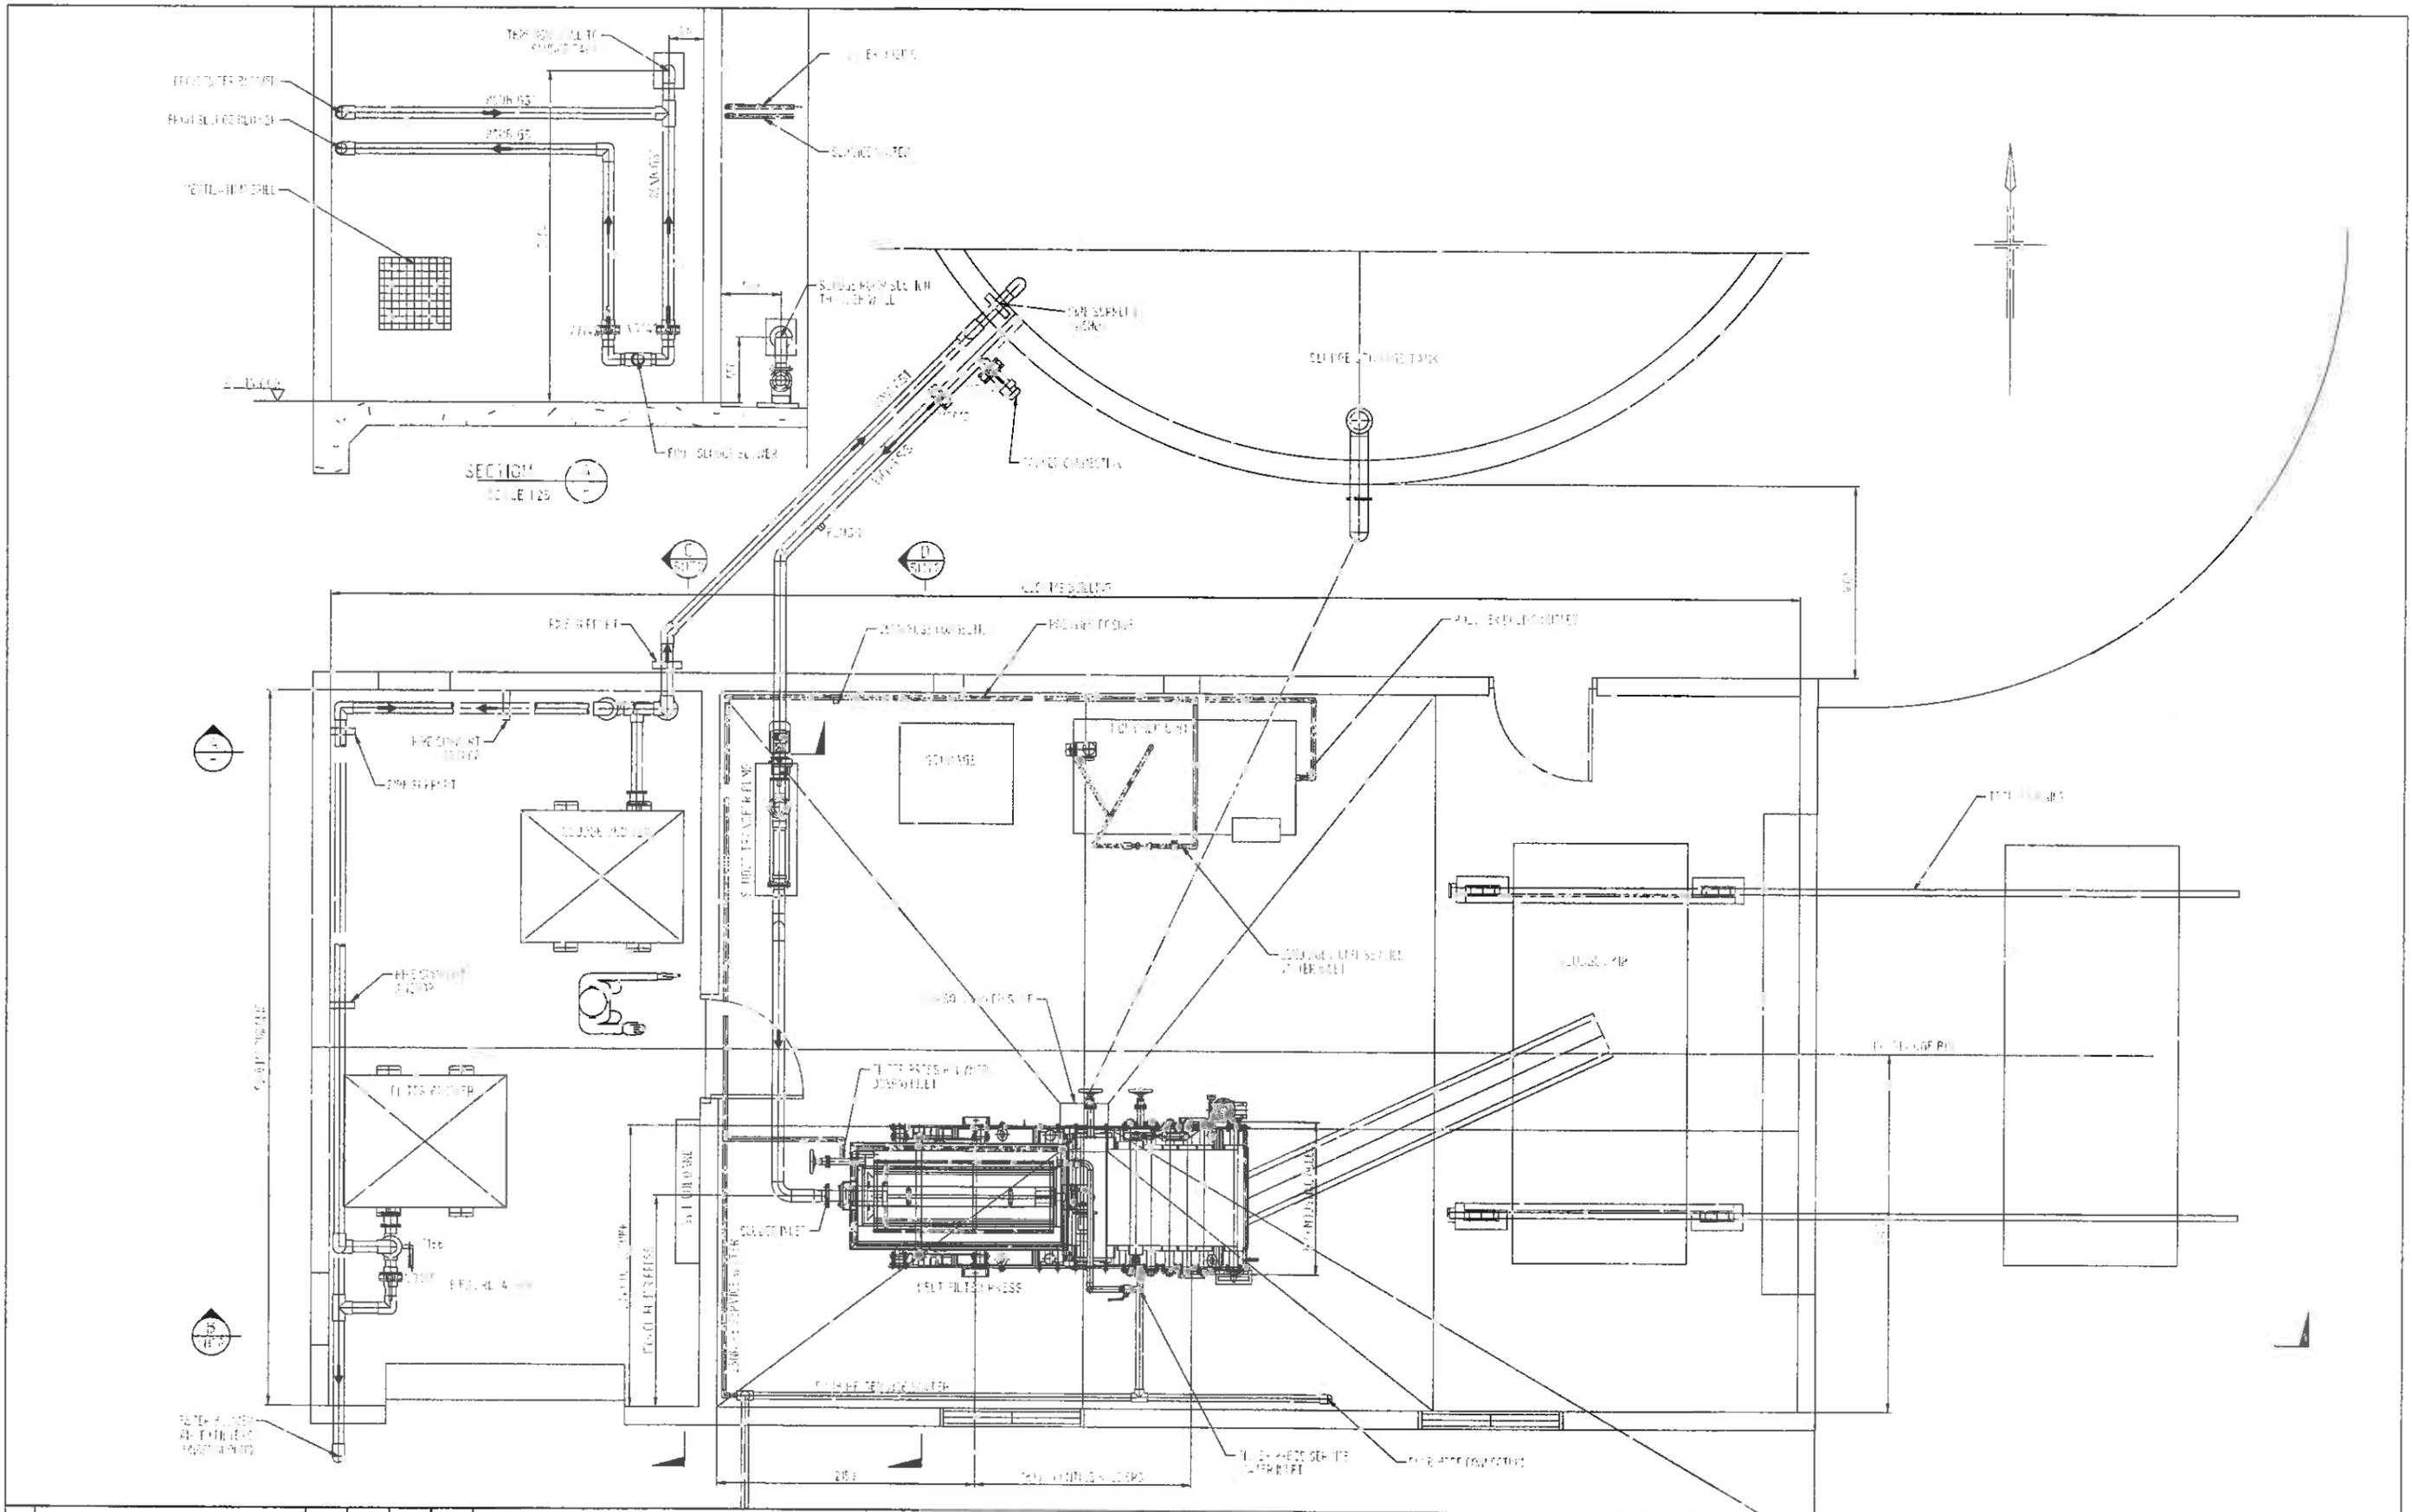

REV	DESCRIPTION	DRN	DATE	CHK	APP
0	AS BUILT		27.07.10		



AS BUILT




MANGAWHAI ECOCARE
MANGAWHAI INFRASTRUCTURE PROJECT

SLUDGE HANDLING AND BLOWER BUILDING
ARRANGEMENT - PLAN (SHEET-1)

Drawing No. A-89973-CIV-7312A Rev 0
Sheet No. SHEET 1 89973
© Earth Tech Engineering Pty Ltd ABN 61 089 482 888 A1

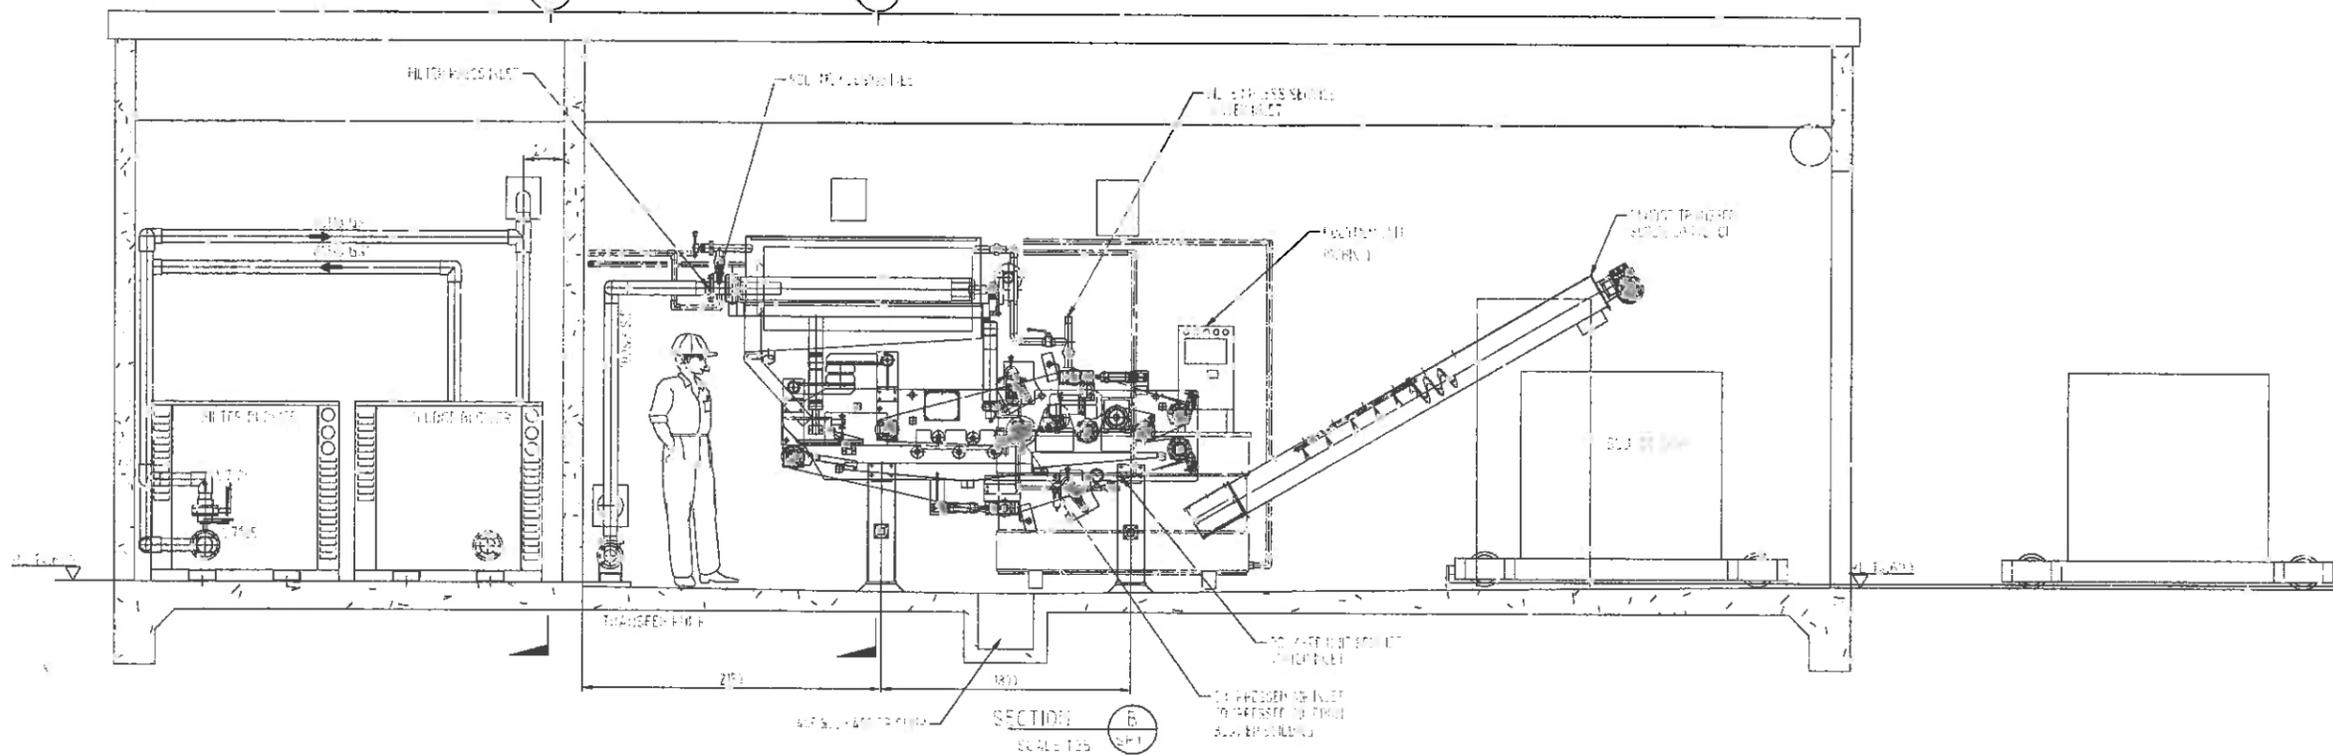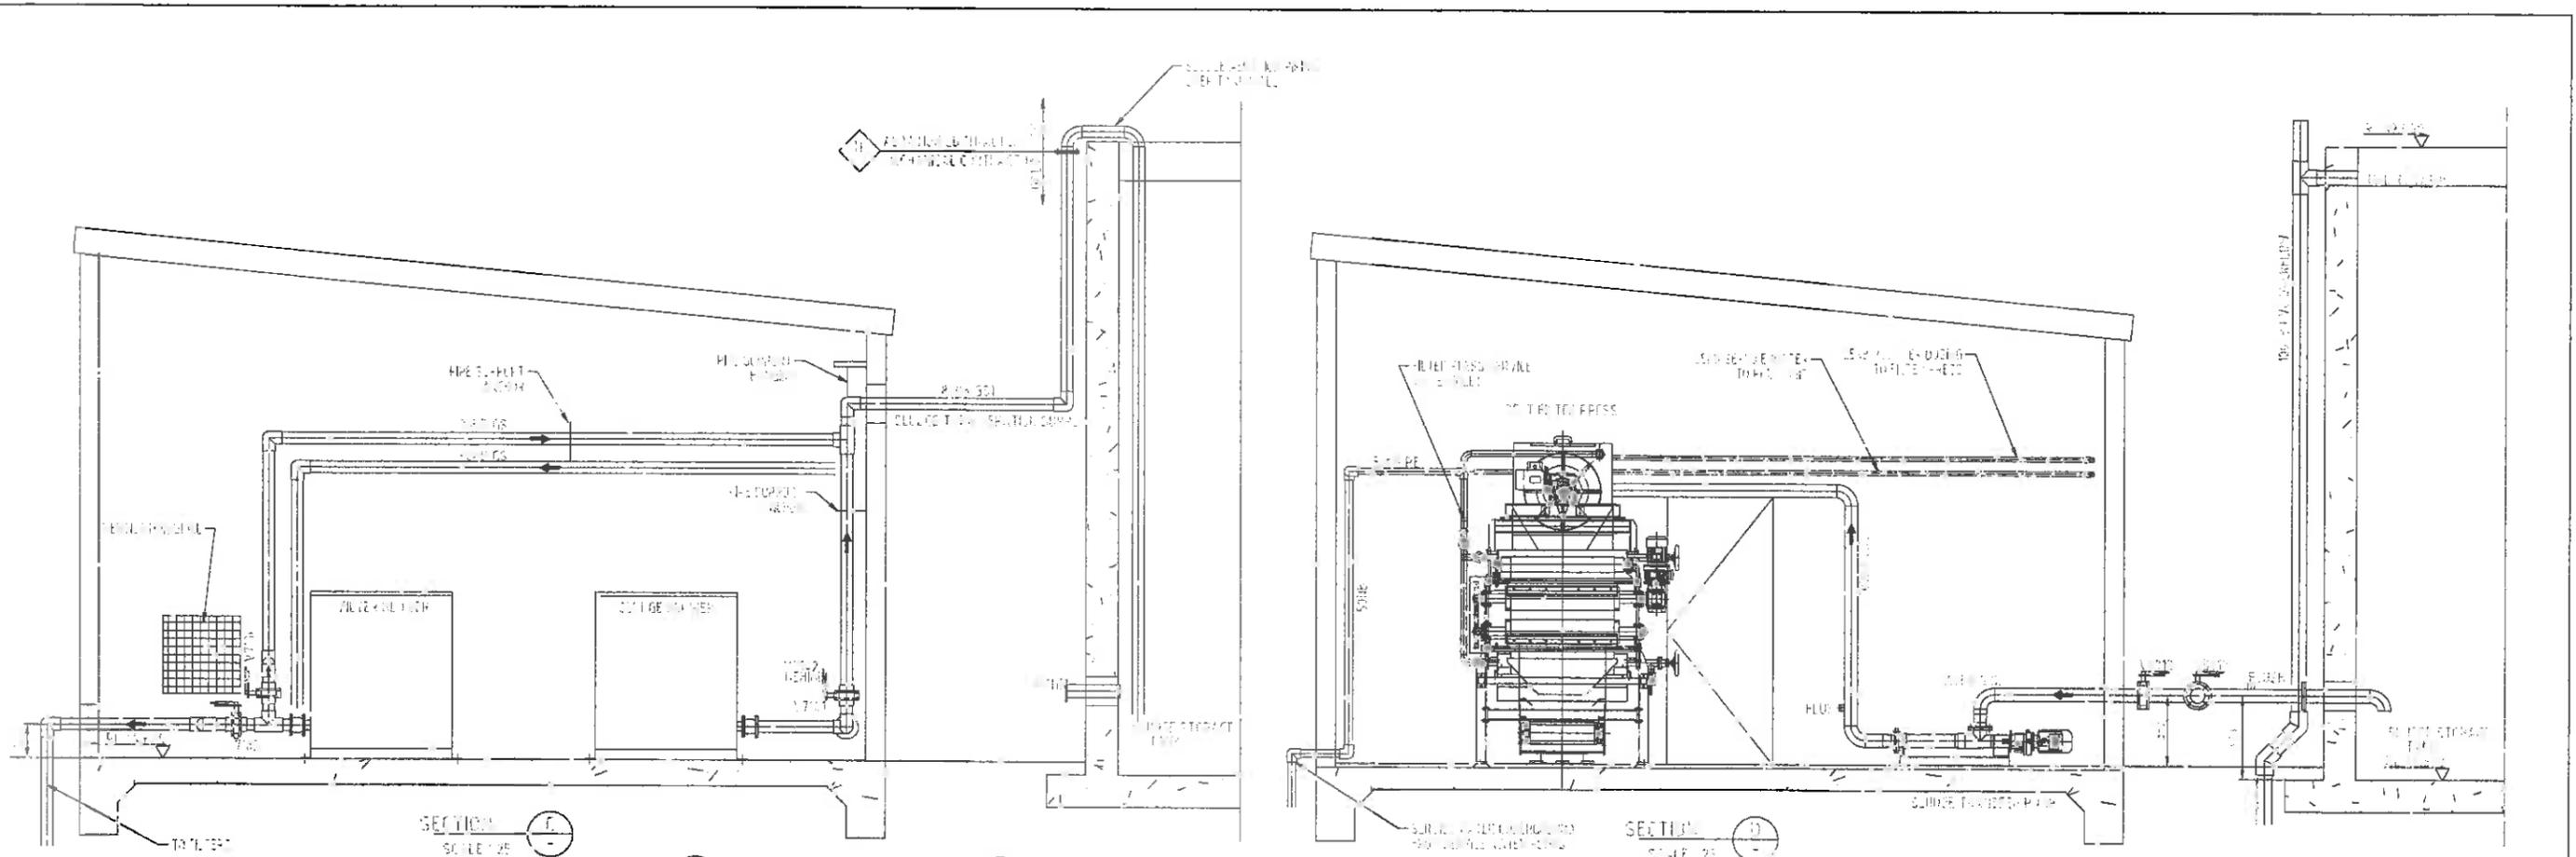

AS BUILT

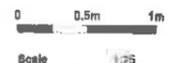


MANGAWHAI ECO CARE
MANGAWHAI INFRASTRUCTURE PROJECT

SLUDGE HANDLING AND BLOWER BUILDING
ARRANGEMENT - SECTIONS (SHEET-2)


Drawing No. A-89973-CIV-7312B Rev 0
Sheet No. SHEET 2 89973
(C) Earth Tech Engineering Pty Ltd A/N 91 000 482 880 A1

REV	DESCRIPTION	DRN	DATE	CHK	APP
0	AS BUILT		27.07.10		

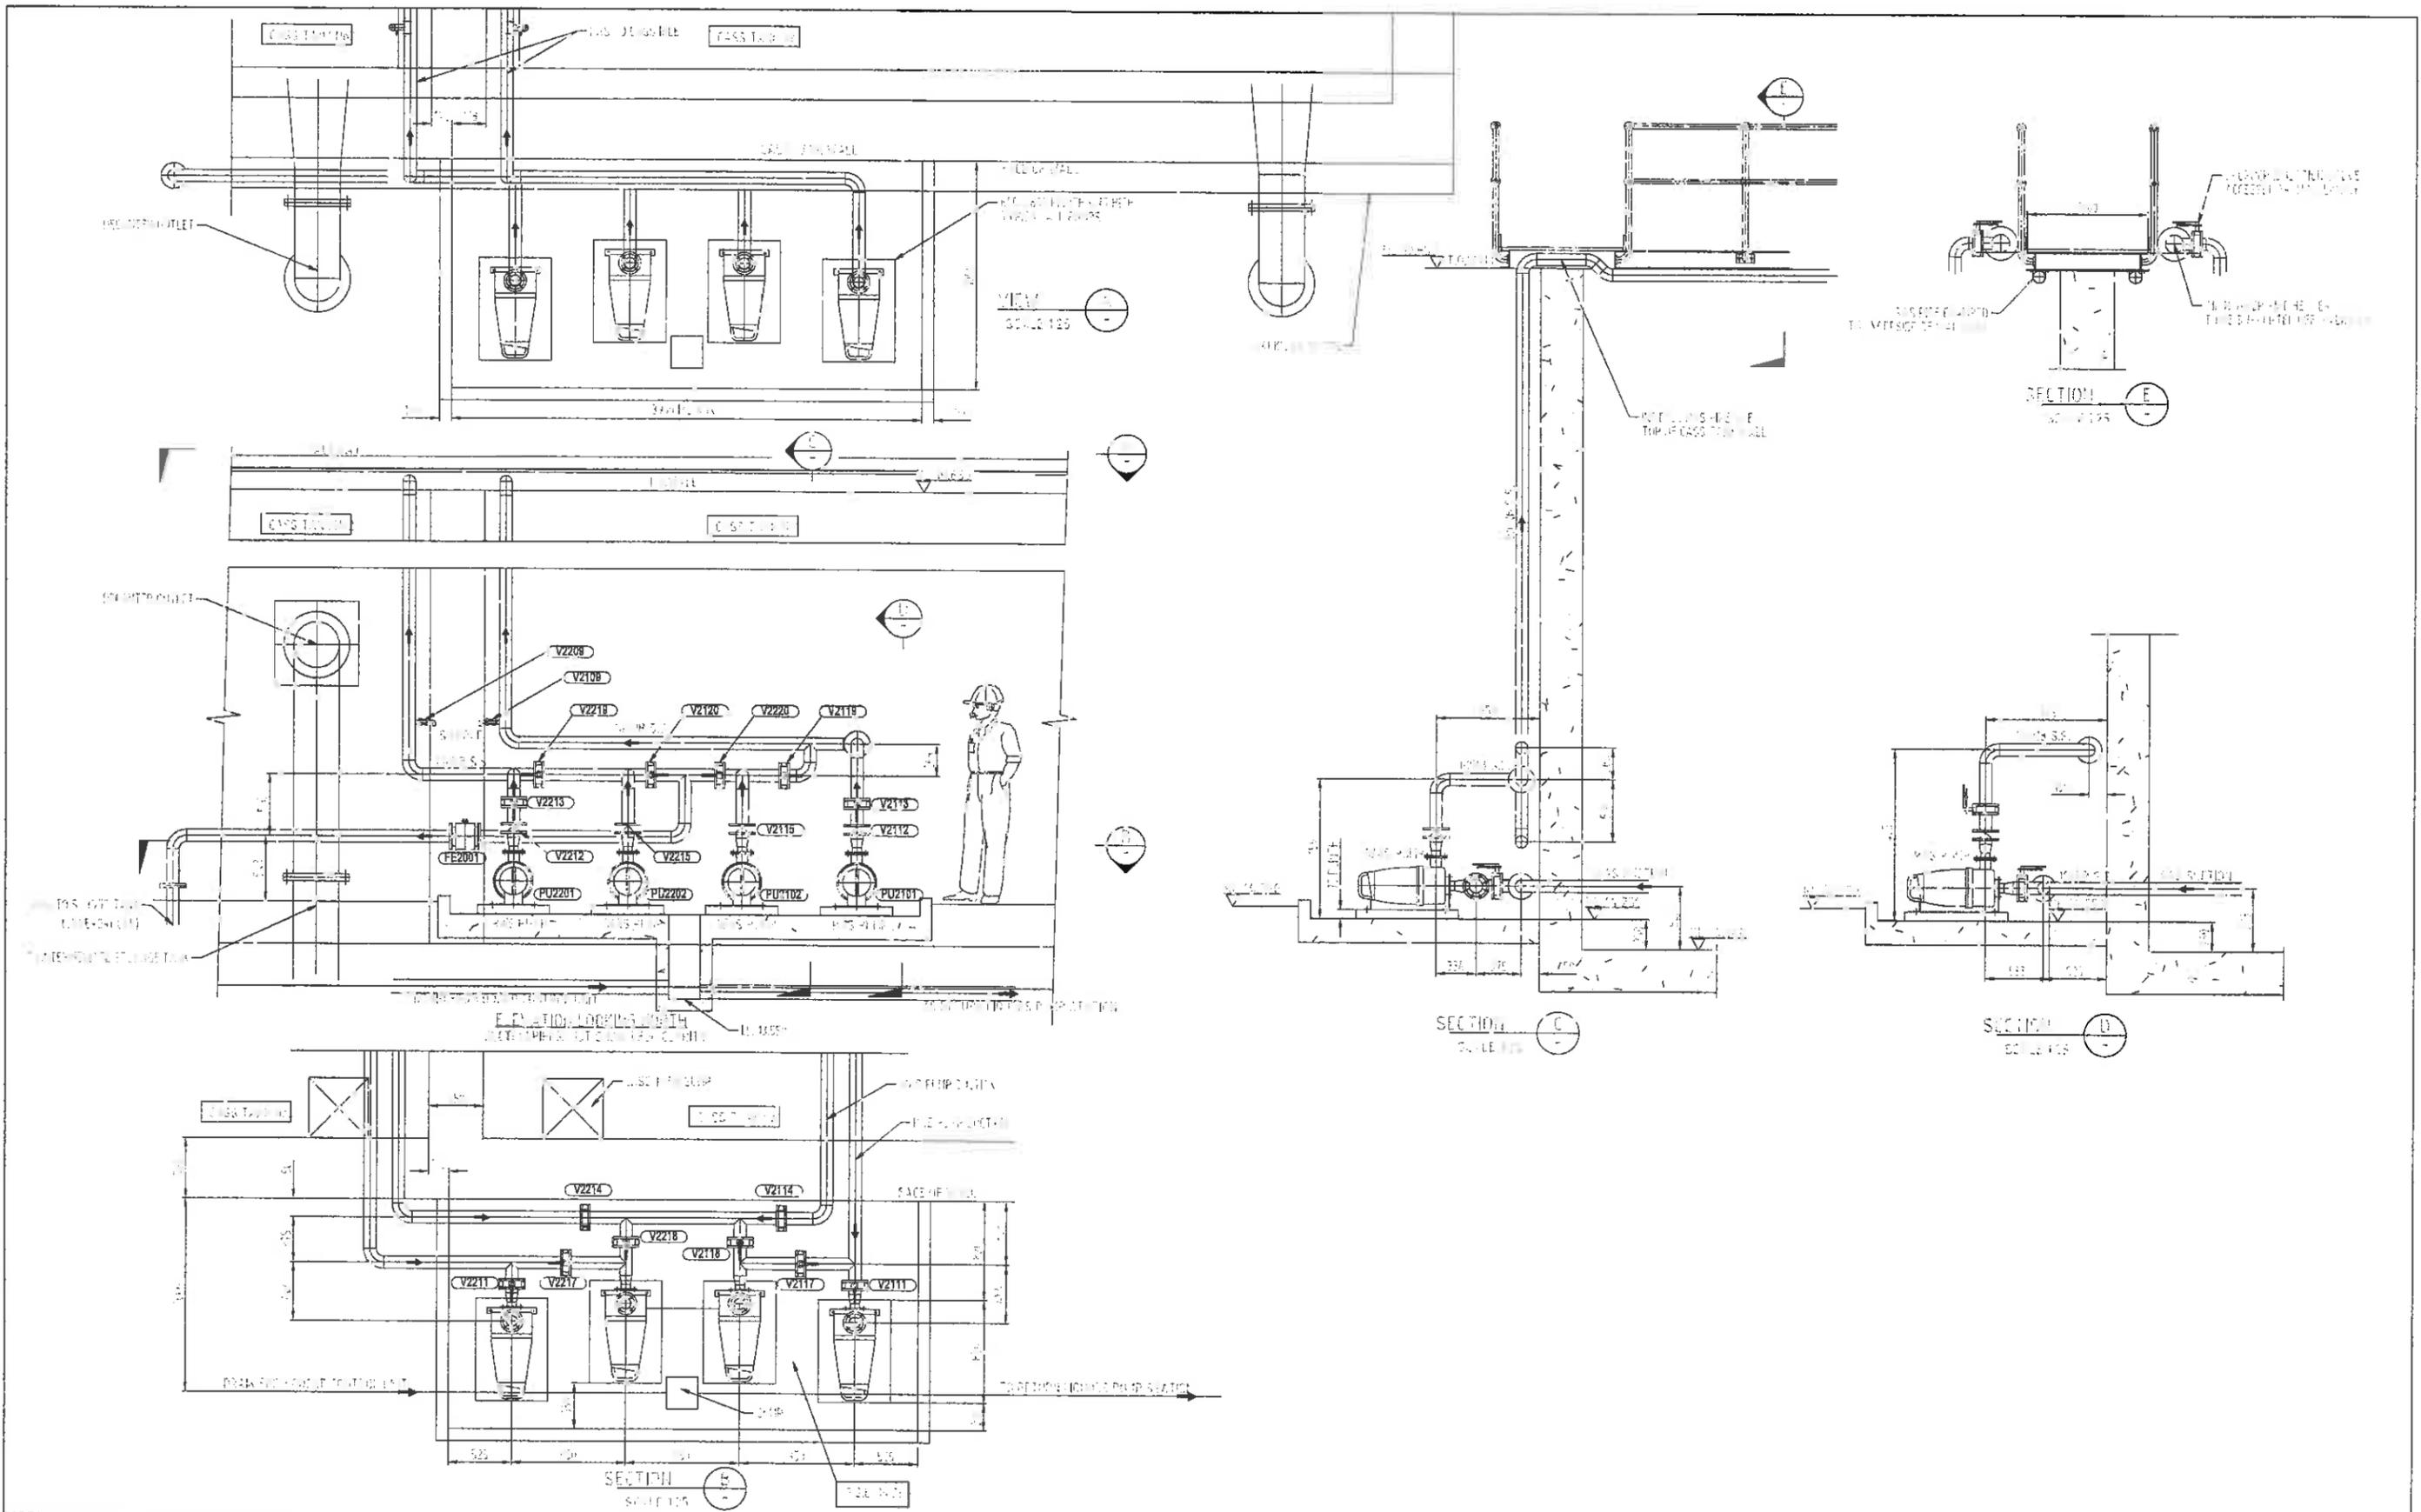

AS BUILT



REV	DESCRIPTION	DRN	DATE	CHK	APP
0	AS BUILT		27.07.10		

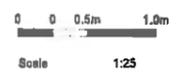

MANGAWHAI ECOCARE
MANGAWHAI INFRASTRUCTURE PROJECT


WAS & RAS PUMP ARRANGEMENT
PLAN AND SECTIONS

Drawing No. A-89973-CIV-7314 Rev 0
Sheet No. 89973
© Earth Tech Engineering Pty Ltd ABN 61 088 482 808 A1

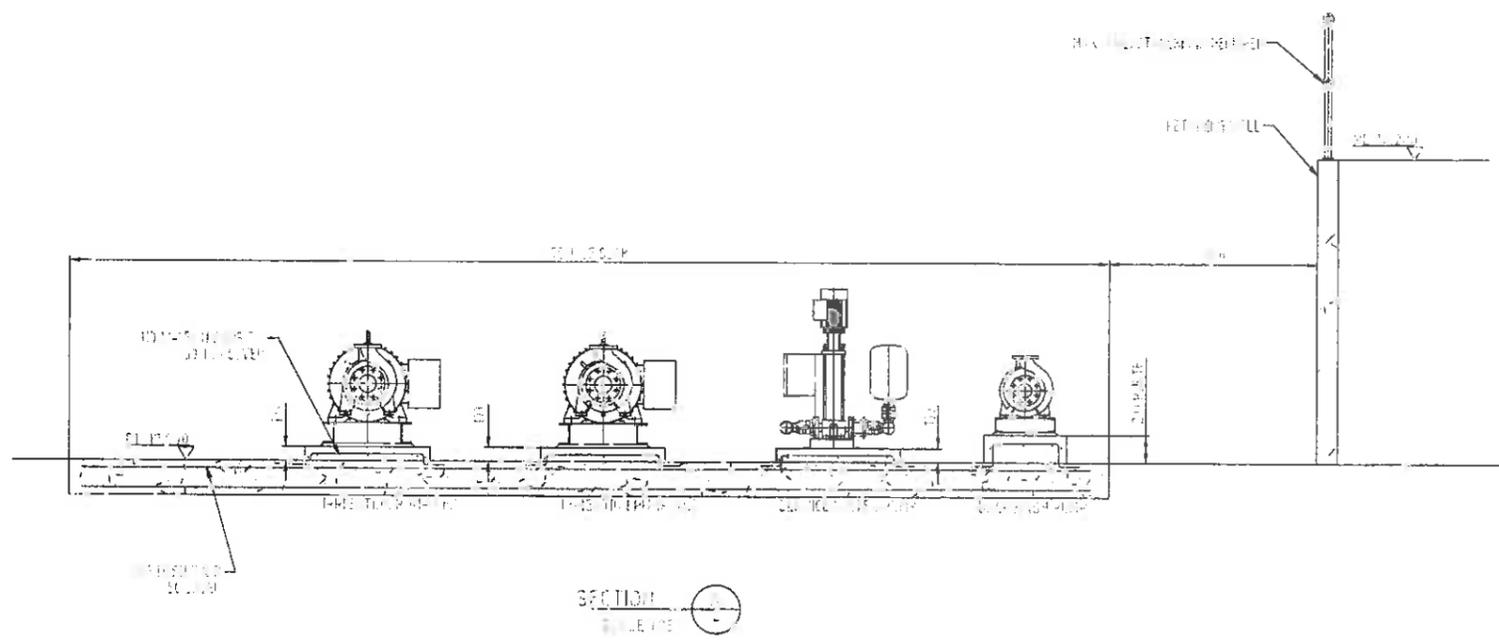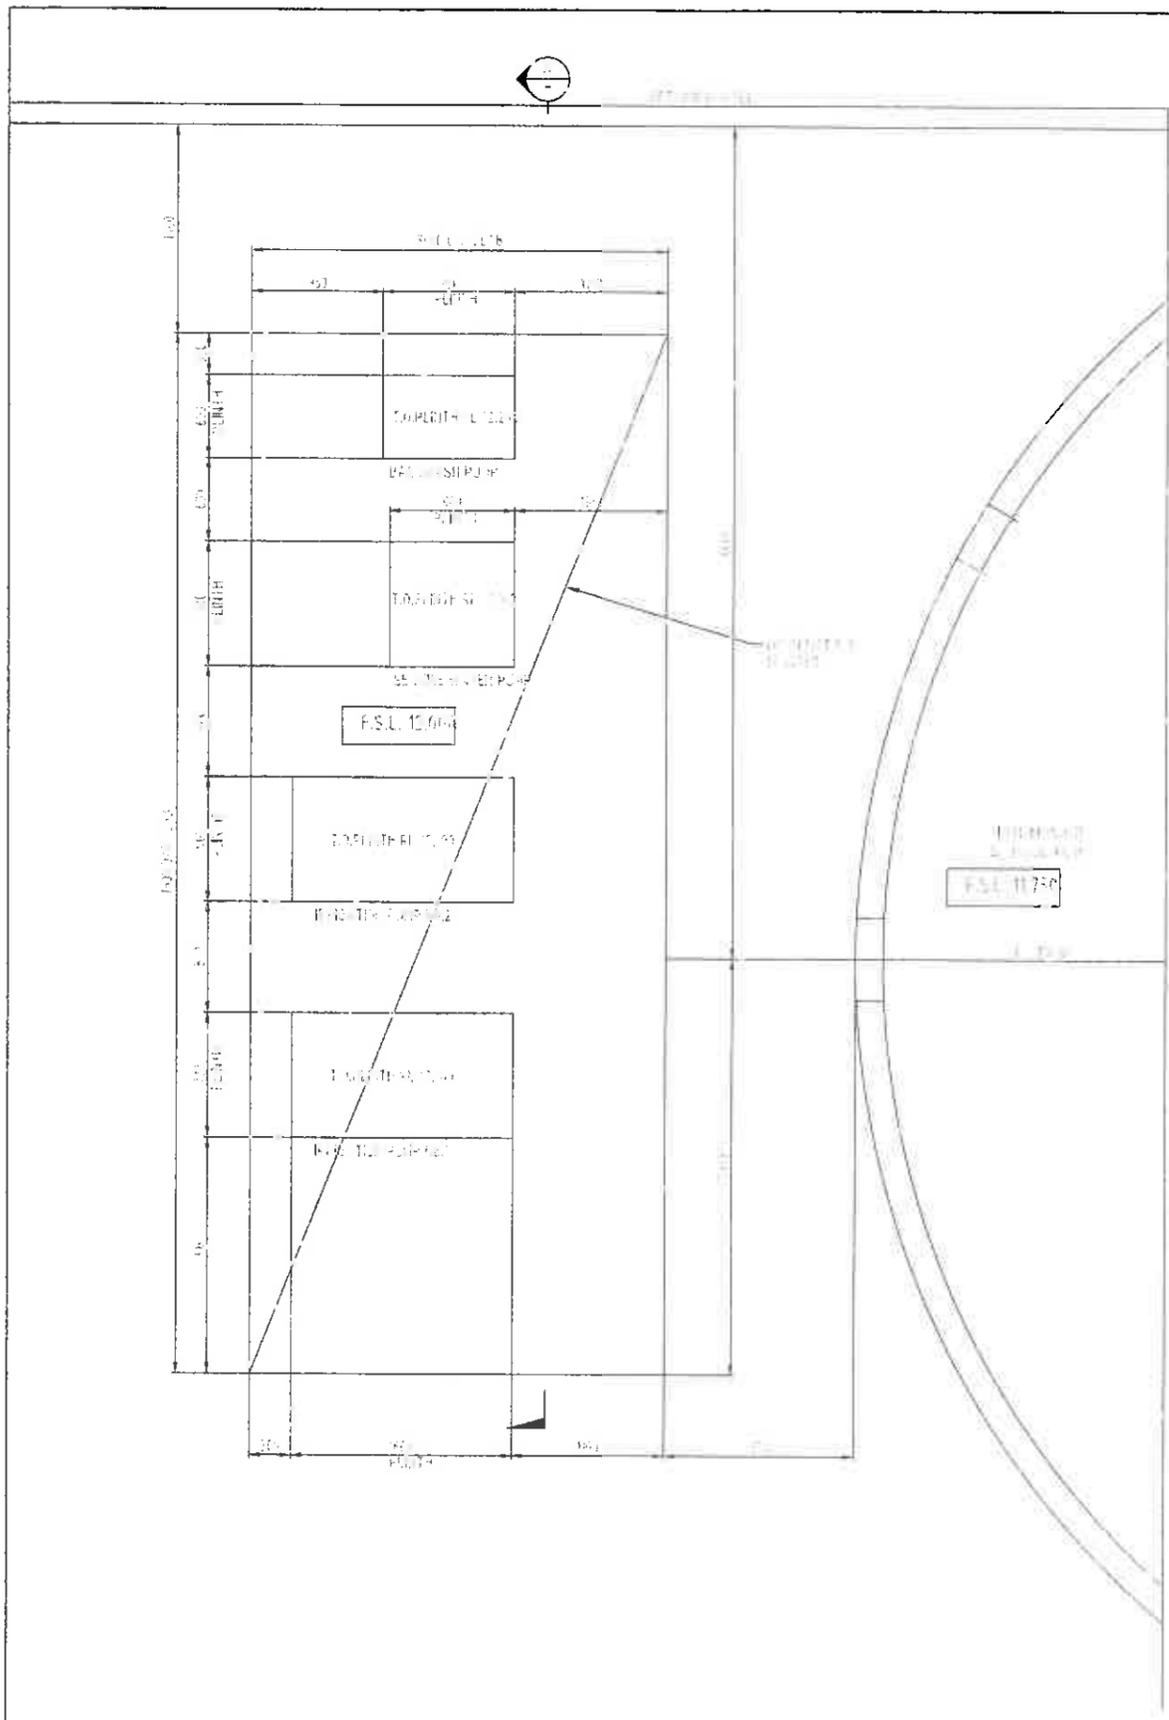

AS BUILT


REV	DESCRIPTION	DRN	DATE	CHK	APP
0	AS BUILT		27.07.10		

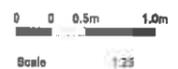

MANGAWHAI ECOCARE
MANGAWHAI INFRASTRUCTURE PROJECT


FINAL EFFLUENT TANK PUMP SLAB
AND PLINTH DETAILS

Drawing No. A-89973-CIV-7315 Rev 0
Sheet No. 69973
© Earth Tech Engineering Pty Ltd ABN 51 080 452 866 A1

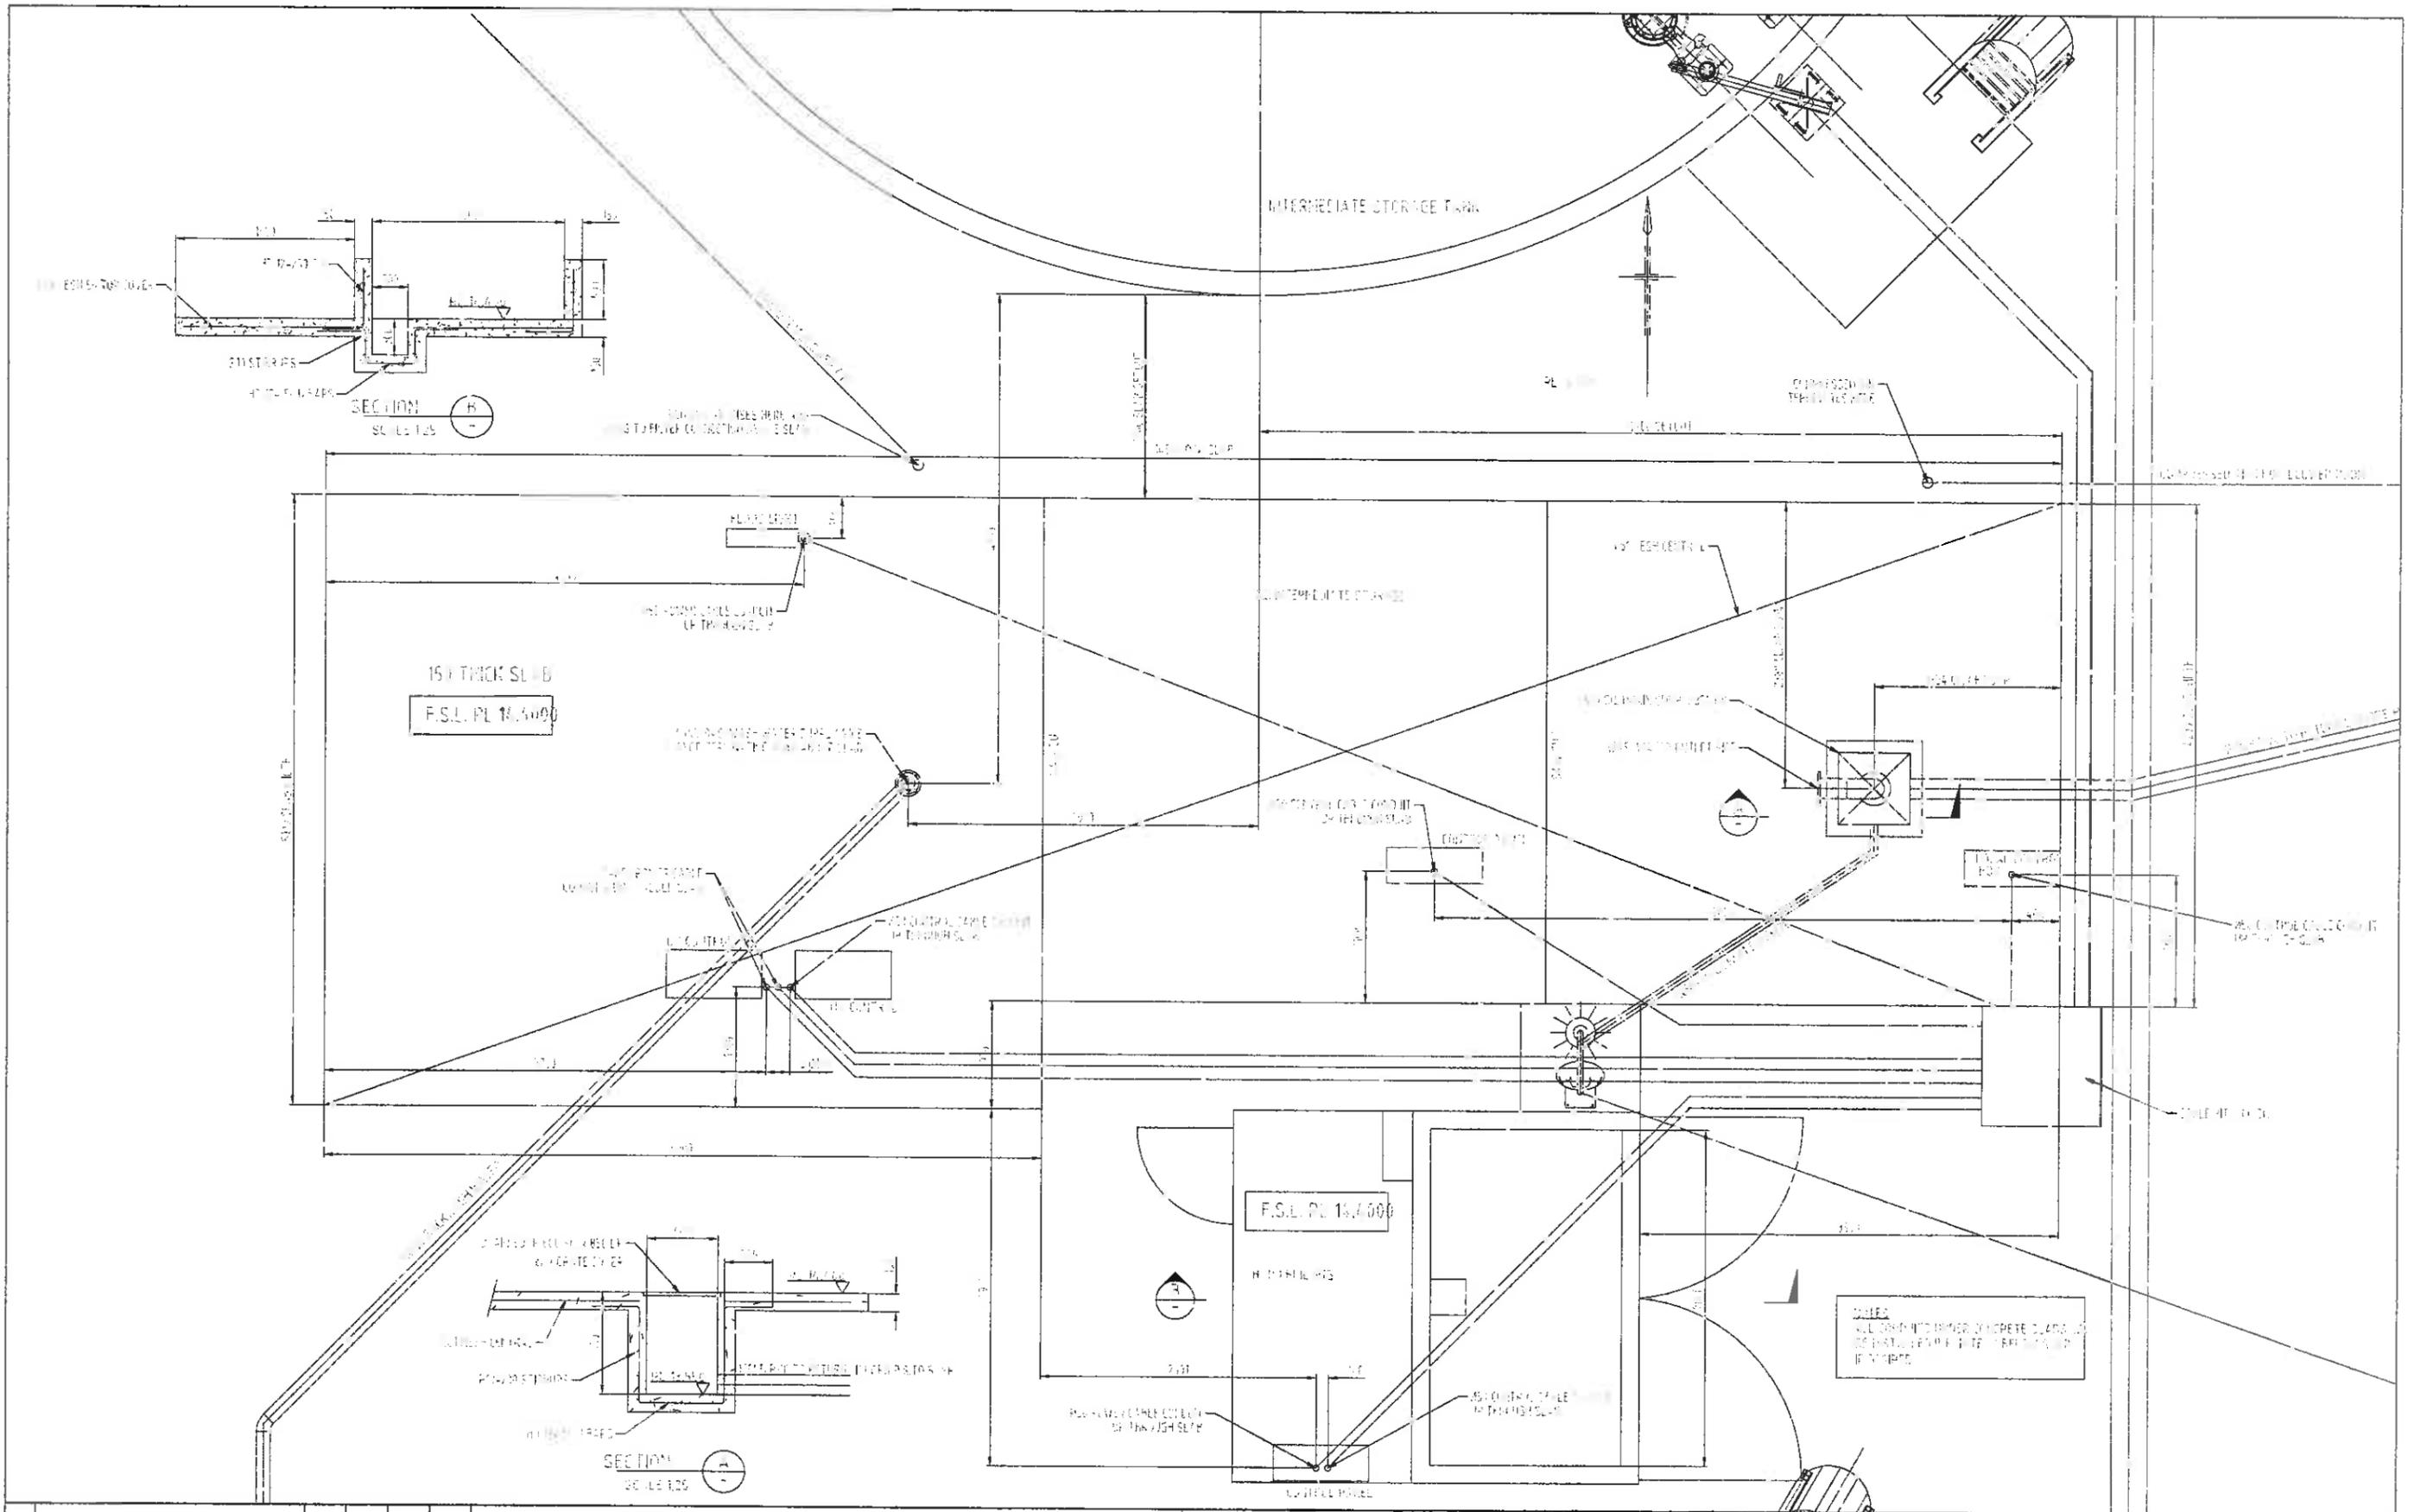

AS BUILT

REV	DESCRIPTION	DRN	DATE	CHK	APP
0	AS BUILT		27.07.10		

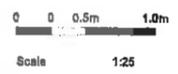


MANGAWHAI ECO CARE
MANGAWHAI INFRASTRUCTURE PROJECT

UV AND FILTER SLAB
CONCRETE DETAILS

Drawing No. A1-89973-CIV-7318 Rev 0
 Sheet No. 89973
 © Black Tech Engineering Pty Ltd ABN 61 089 482 868 A1


UNDERGROUND AGGI DRAINAGE, STORMWATER & PROCESS PIPING SCHEDULE

LINE No.	NB/TYP	LINE DESCRIPTION	HIGH POINT	LOW POINT
1	100NB AGGI	CASS TANK SEEPAGE/DRAINAGE	IL 13.20	IL 13.00
2	100NB AGGI	INTERMEDIATE TANK SEEPAGE/DRAINAGE	IL 12.90	IL 11.80
3	100NB AGGI	CASS TO INTERMEDIATE TANK SEEPAGE/DRAINAGE	IL 13.00	IL 11.90
4	100NB AGGI	INTERMEDIATE TANK TO RETAINING WALL DRAINAGE	IL 11.80	IL 11.50
5	100NB AGGI	RETAINING WALL SEEPAGE/DRAINAGE	IL 11.50	IL 11.20
6	375NB PVC PN6	DECANTER TO INTERMEDIATE TANK (2-LINES)	IL 12.15	IL 12.65
7	300NB PVC PN6	INTERMEDIATE TANK OVERFLOW TO FINAL STORAGE	IL 11.25	IL 13.10
8	150NB PVC DWV SNI6	FILTER BACKWASH DRAIN TO RETURN LIQUORS P.S.	IL 13.60	IL 13.17
9	150NB PVC DWV SNI6	SLUDGE BUILDING DRAIN TO RETURN LIQUORS P.S.	IL 13.70	IL 13.30
10	100NB PVC DWV SNI6	ODOUR BED DRAIN TO RAS/WAS SLAB DRAIN	IL 14.10	IL 13.60
11	100NB PVC DWV SNI6	RAS/WAS SLAB DRAIN TO RETURN LIQUORS P.S.	IL 13.60	IL 13.40
12	100NB PVC DWV SNI6	INLET WASHDOWN SLAB TO RETURN LIQUORS P.S.	IL 13.80	IL 13.10
13	32NB HDPE	CRINDET PUMP TO RETURN LIQUORS P.S.	IL 13.70	IL 13.60
14	150NB PVC PN6	RETURN LIQUORS P.S. TO PLANT INLET	IL 13.80	IL 13.70
15	100NB PVC PN6	WAS LINE TO SLUDGE STORAGE TANK	IL 13.90	IL 14.10
16	100NB PVC PN6	FILTER BACKWASH PUMP TO FILTERS	IL 13.60	IL 13.50
17	200NB PE PN12.5 BLACK	FROM PUMP TO CASS TANK/SLUDGE BUILDING	IL 13.60	IL 13.42
18	32NB PE PN12.5 BLUE	POTABLE WATER TO SHOWER/CONTROL BUILDING	IL 13.80	IL 13.80
19	100NB PVC DWV SNI6	CONTROL BUILDING STORMWATER TO DRAINAGE	IL 13.70	IL 13.39
20	100NB PVC DWV SNI6	SLUDGE BUILDING STORMWATER TO DRAINAGE	IL 13.90	IL 13.70
21	100NB PVC DWV SNI6	UV BUILDING STORMWATER TO DRAINAGE	IL 13.80	IL 13.60
22	100NB PVC DWV SNI6	SLUDGE TANK OVERFLOW TO SLUDGE BUILDING SUMP	IL 14.00	IL 13.70
23	50NB PVC DWV SNI6	SAFETY SHOWER DRAIN TO FILTER SLAB SUMP	IL 13.80	IL 13.60
24	300NB PVC DWV SNI6	FINAL TANK OVERFLOW	RL 10.03	RL 10.03
25	300NB PVC DWV SNI6	INLET PIPE TO CASS TANK		
26	300NB PVC DWV SNI6	DELIVERY PIPE TO DAM		

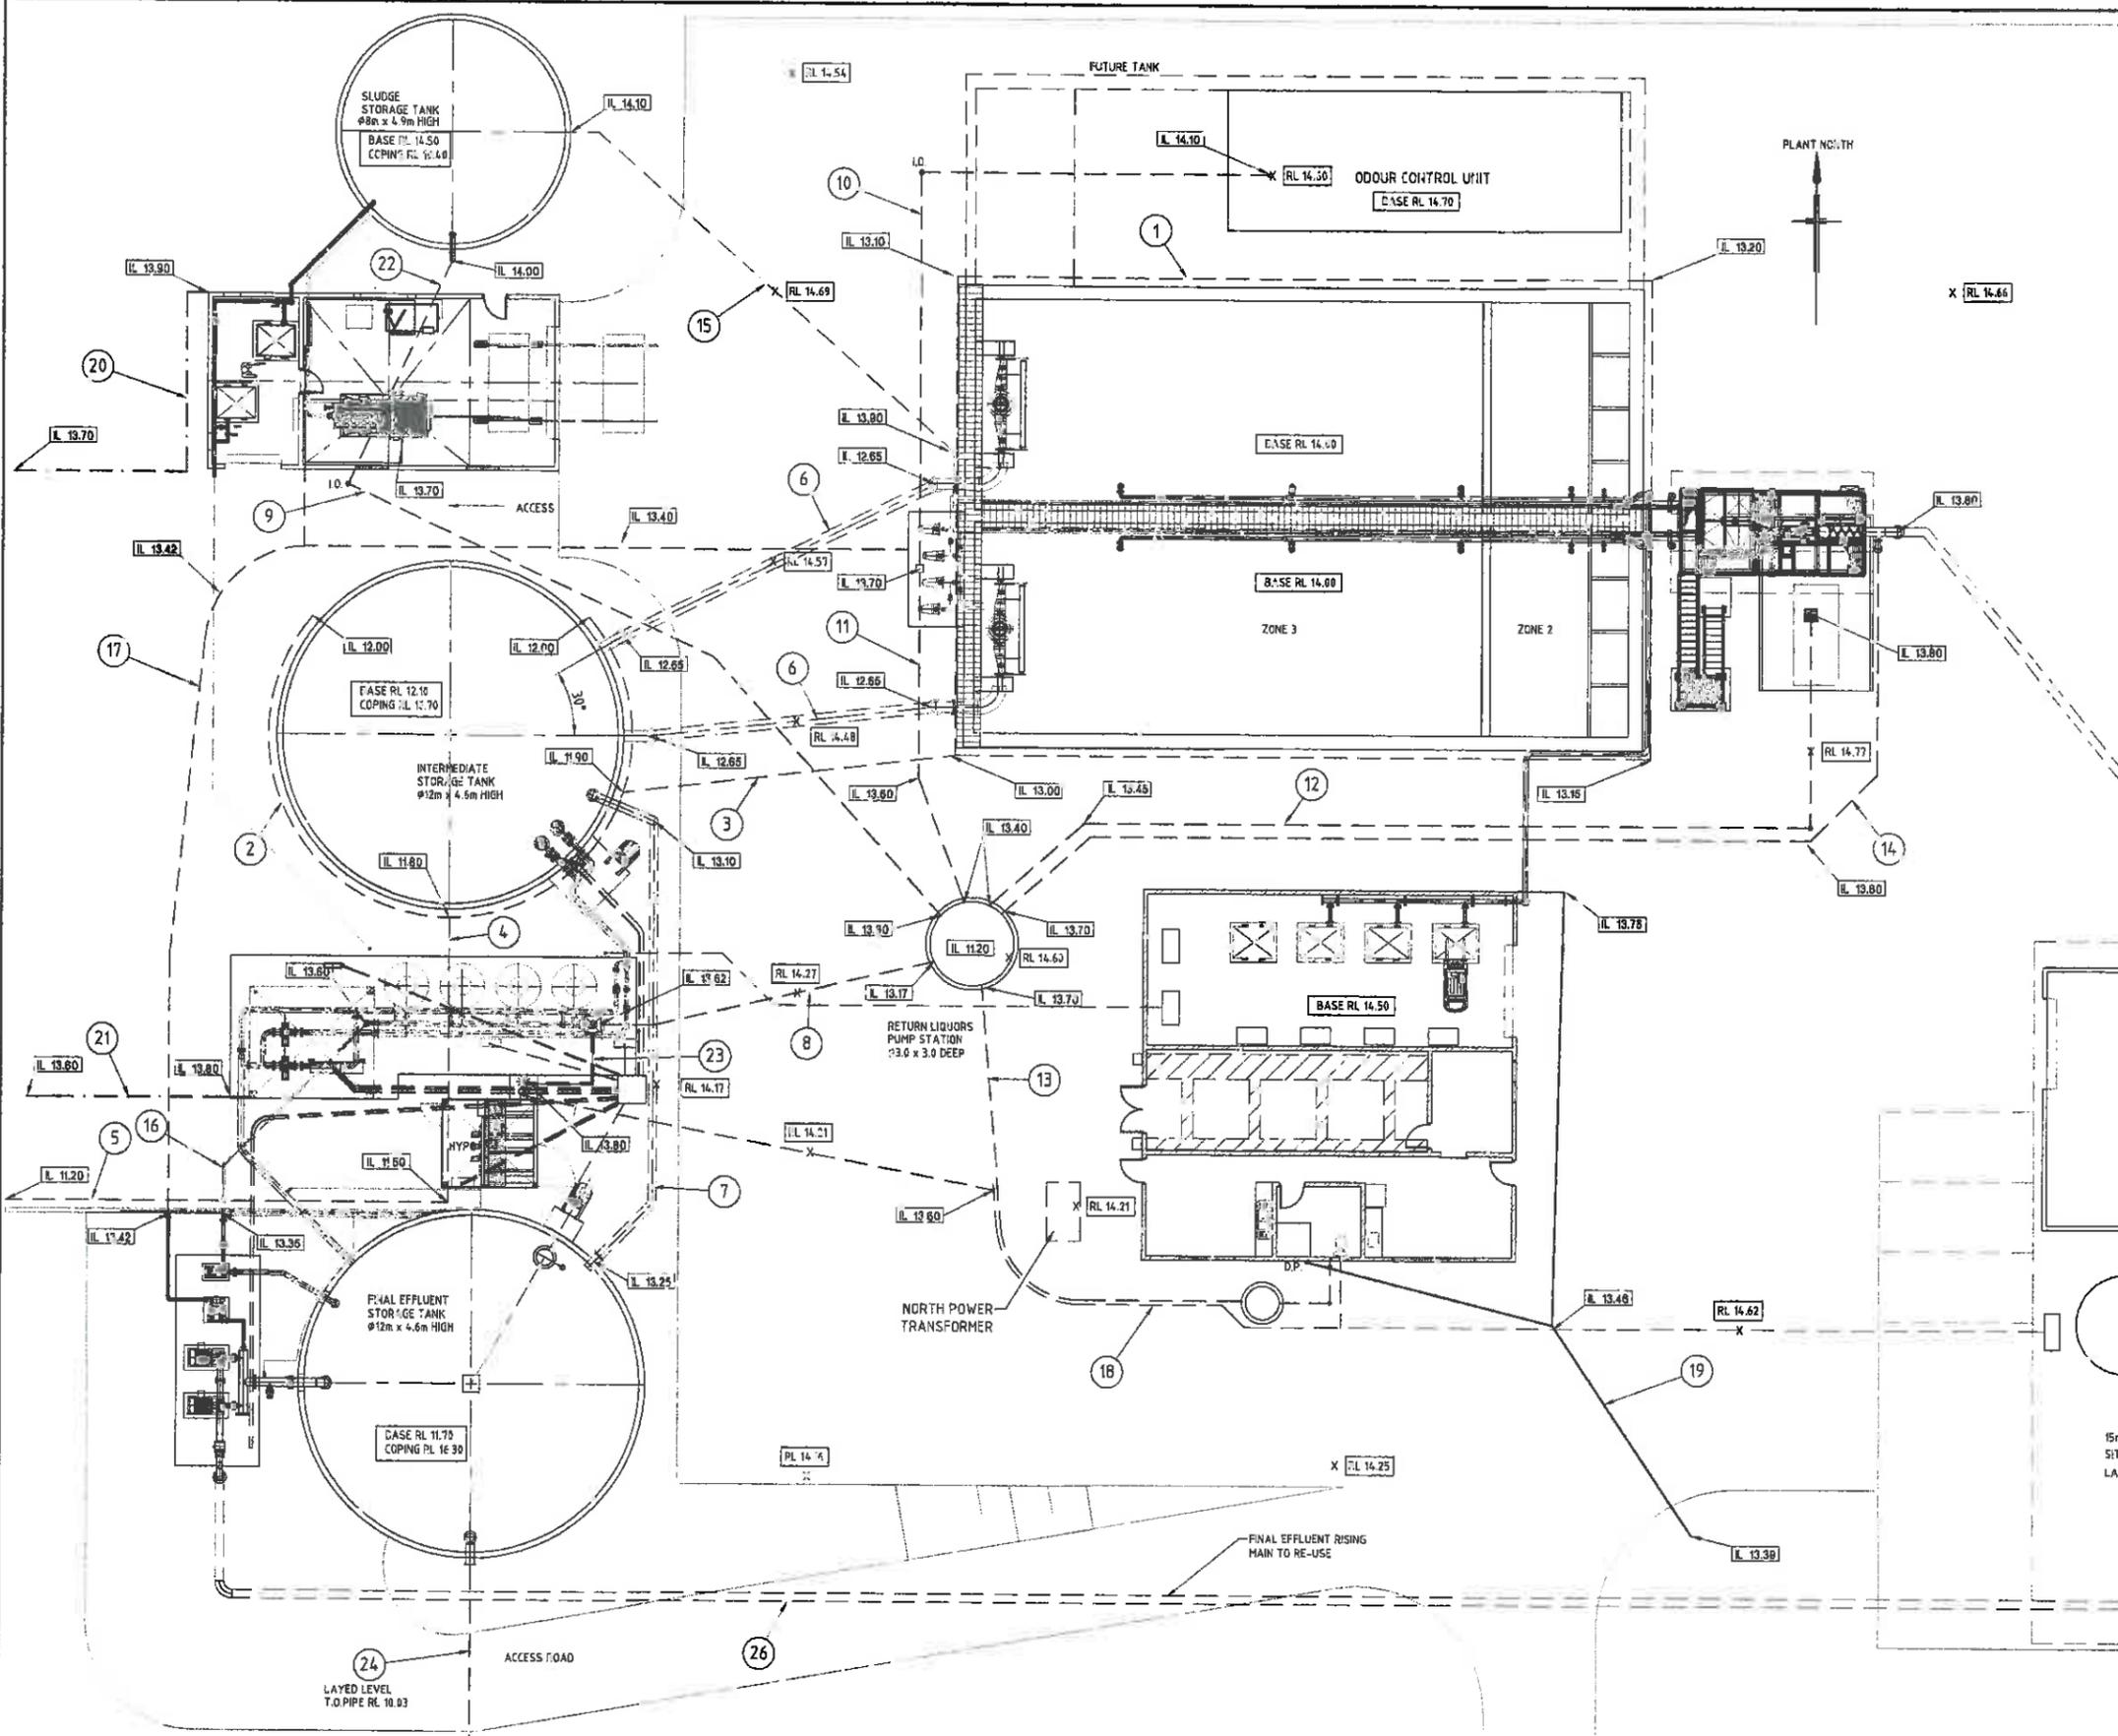

REV	DESCRIPTION	DRN	DATE	CHK	APP
AC	AS CONSTRUCTED		7.7.09	RJ	CJ
B	LINE 22 & 23 MOVED, LINE 10 RELOCATED		13.1.09	CJ	RJ
A	ISSUED FOR INFORMATION		8.1.09	CJ	CJ

AS CONSTRUCTED
Information supplied by construction contractor

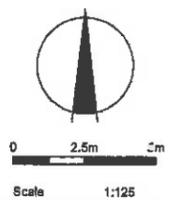


EARTH TECH
Global Water Projects and Products
Melbourne - Tel 8517 9200

Designed: C.JOHNSTON
Drawn: D.JOULES
Checked: C.JOHNSTON
Approved:

MANGAWHAI ECOCARE
MANGAWHAI INFRASTRUCTURE PROJECT

TREATMENT PLANT
UNDERGROUND PIPING ARRANGEMENT

Drawing No. A-89973-CIV-7320 Rev AC
Sheet No. 89973
© Earth Tech Engineering Pty Ltd ABN 61 006 471 886 A1

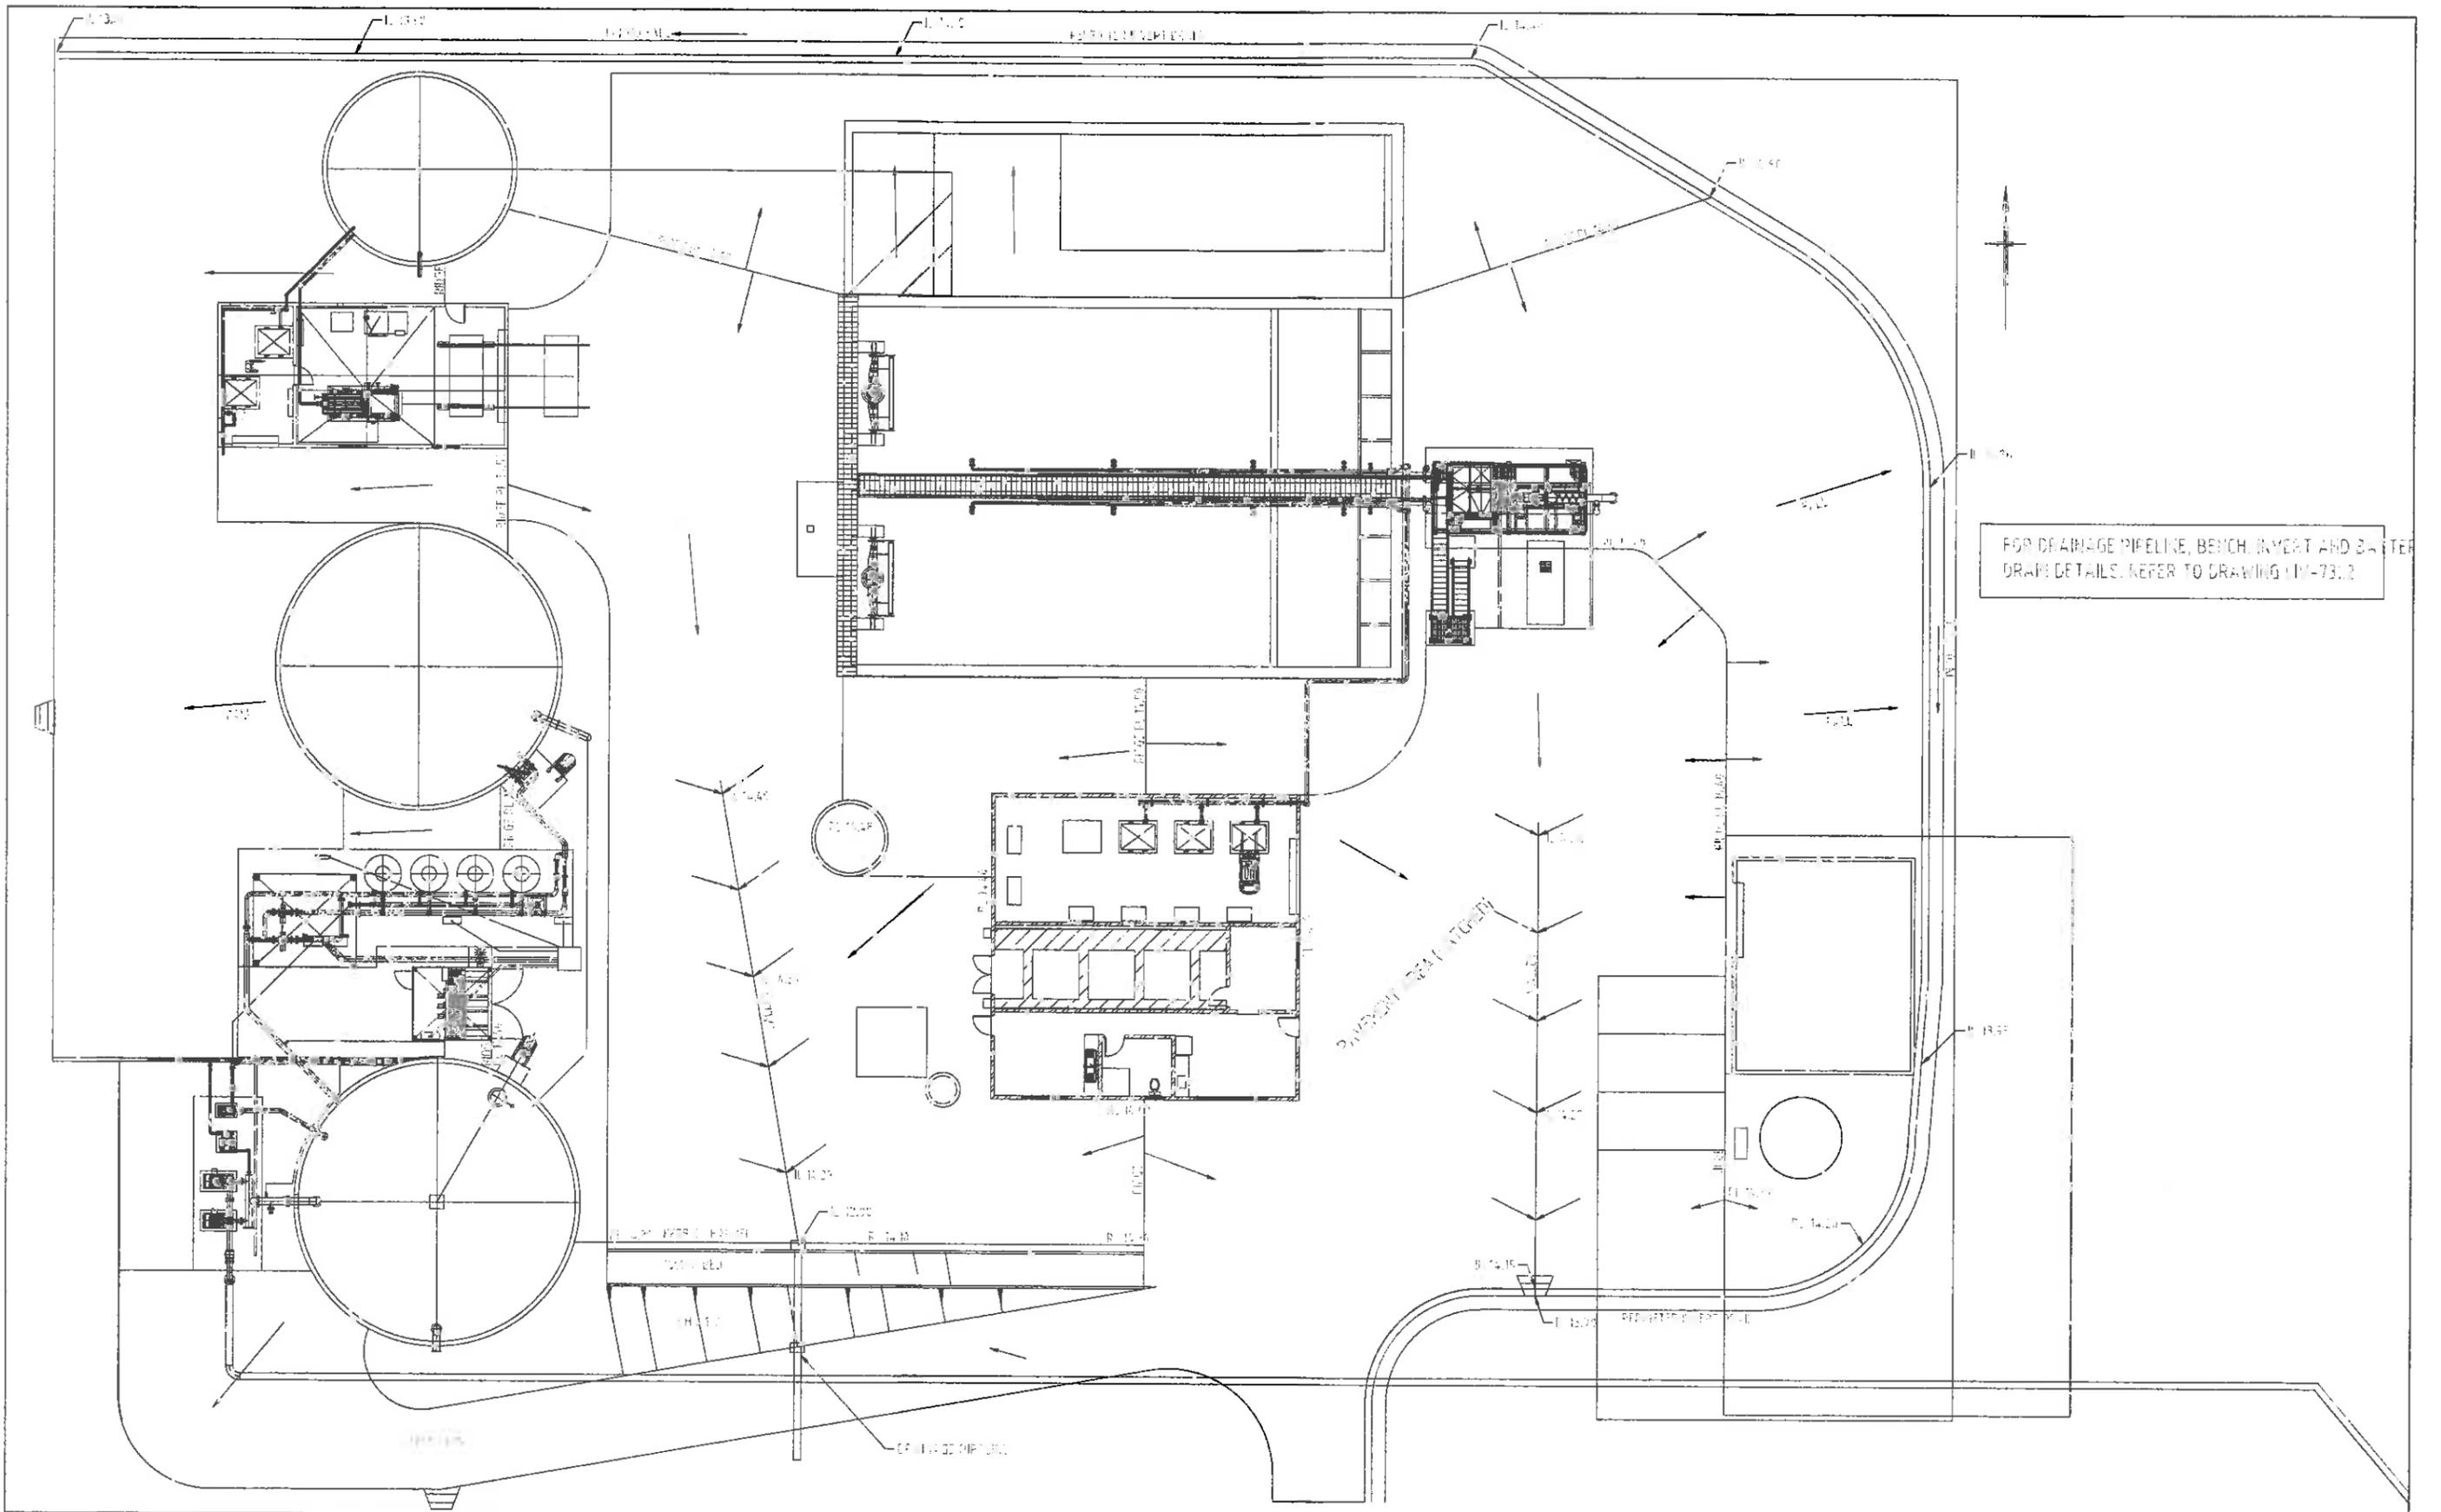

AS BUILT

REV	DESCRIPTION	DRN	DATE	CHK	APP
0	AS BUILT		27.07.10		


Scale 1:130



MANGAWHAI ECO CARE
MANGAWHAI INFRASTRUCTURE PROJECT


TREATMENT PLANT
FINISHED SURFACE LEVELS AND DRAINS

Drawing No. A-89973-CIV-7321 Rev A
Sheet No. 69873
© Earth Tech Engineering Pty Ltd ABN 61 088 482 888 A1

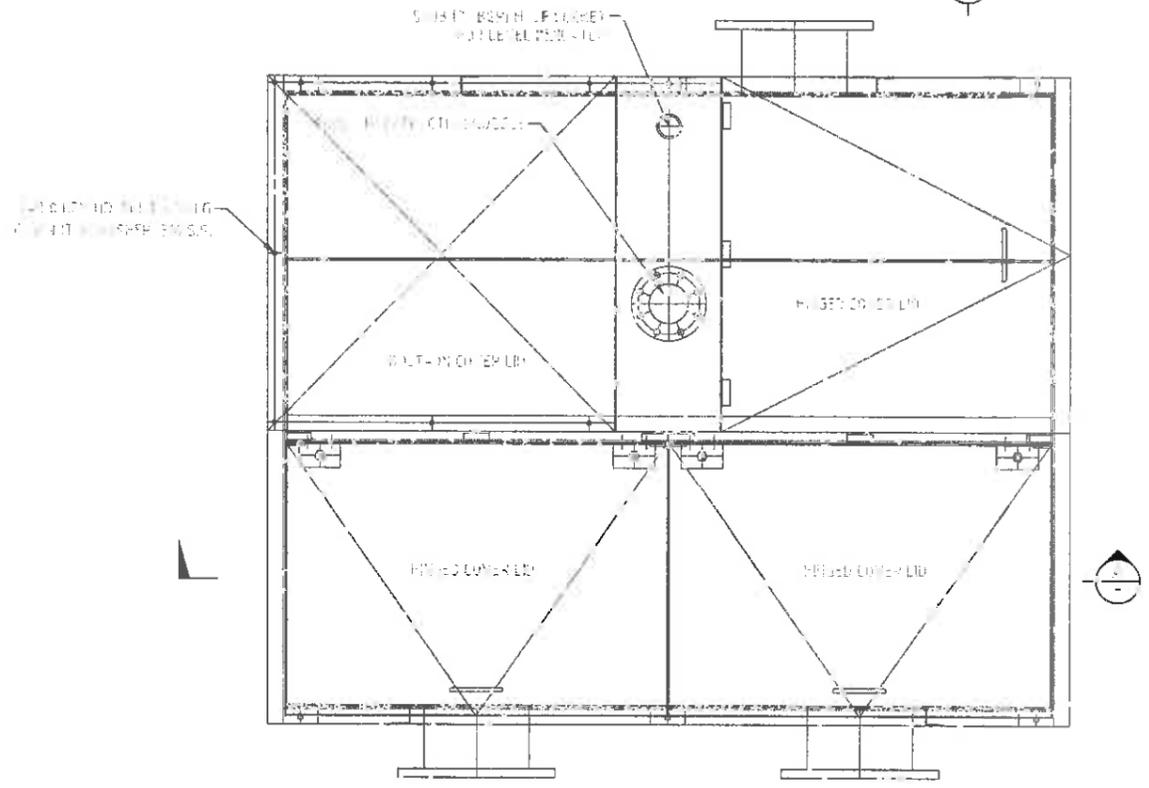


PLAN VIEW
INTERNAL DIMENSIONS ONLY

WATER CHAMBER
WATER CHAMBER
WATER CHAMBER
WATER CHAMBER

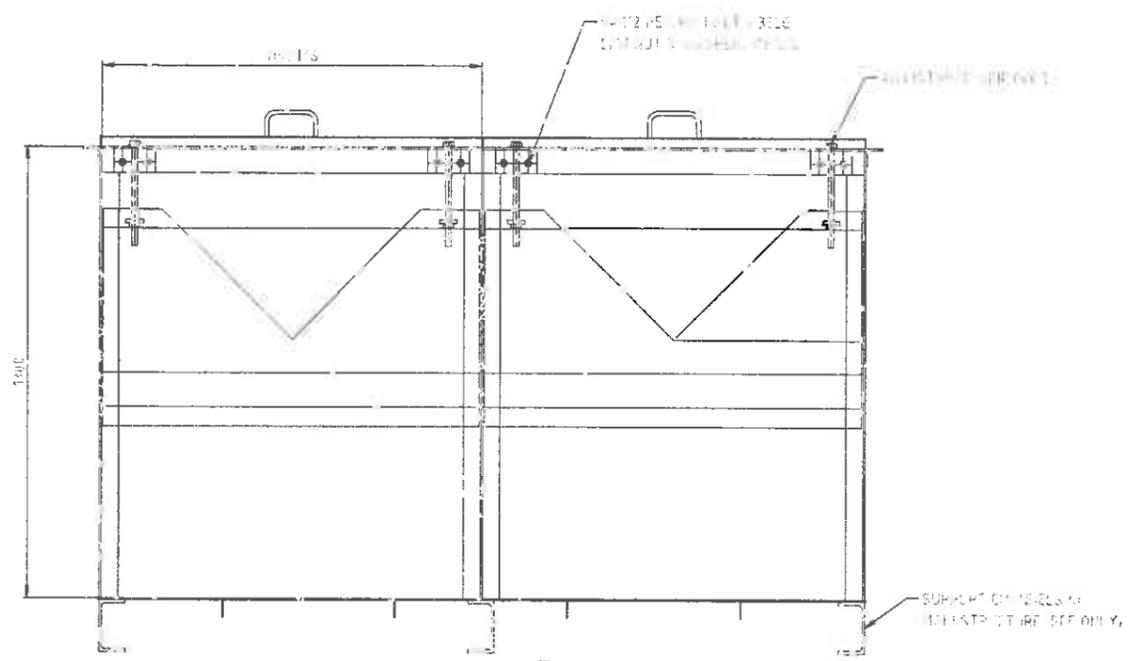

SECTION A-A
SCALE 1:10

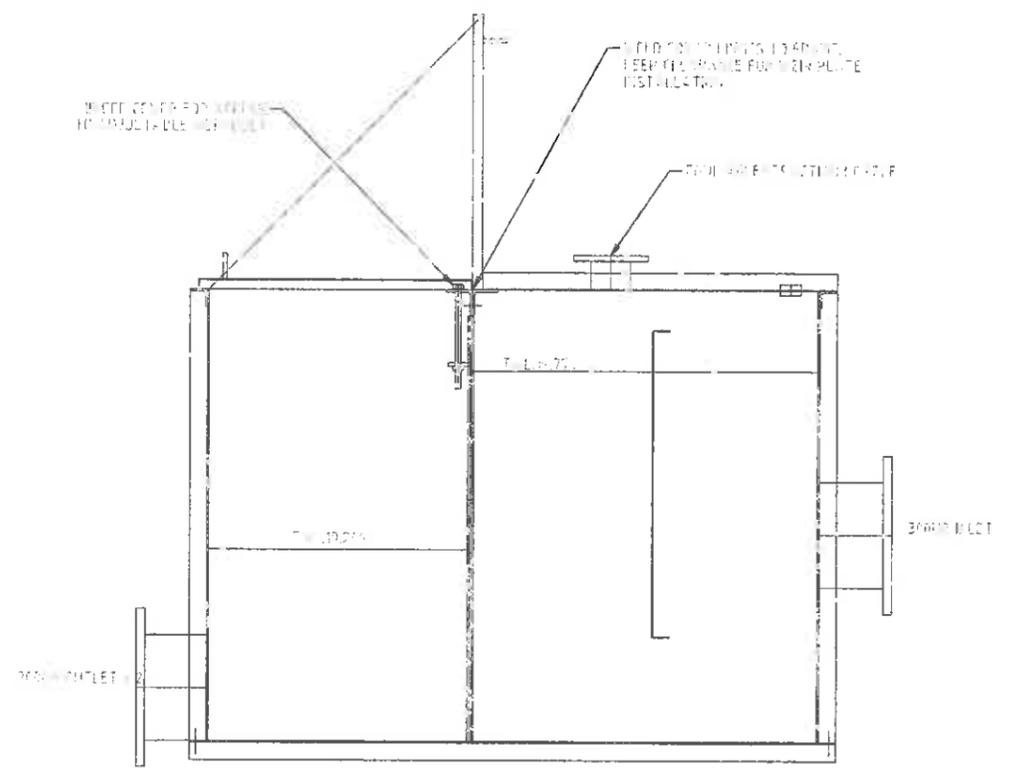

SECTION B-B
SCALE 1:10

AS BUILT


REV	DESCRIPTION	DRN	DATE	CHK	APP
0	AS BUILT		27.07.10		



MANGAWHAI ECOCARE
MANGAWHAI INFRASTRUCTURE PROJECT

INLET WORKS
SPLITTER BOX ARRANGEMENT

Drawing No. A-89973-STR-7330 Rev 0
Sheet No. 89973
© Earth Tech Engineering Pty Ltd A32811 088 432 868 A1

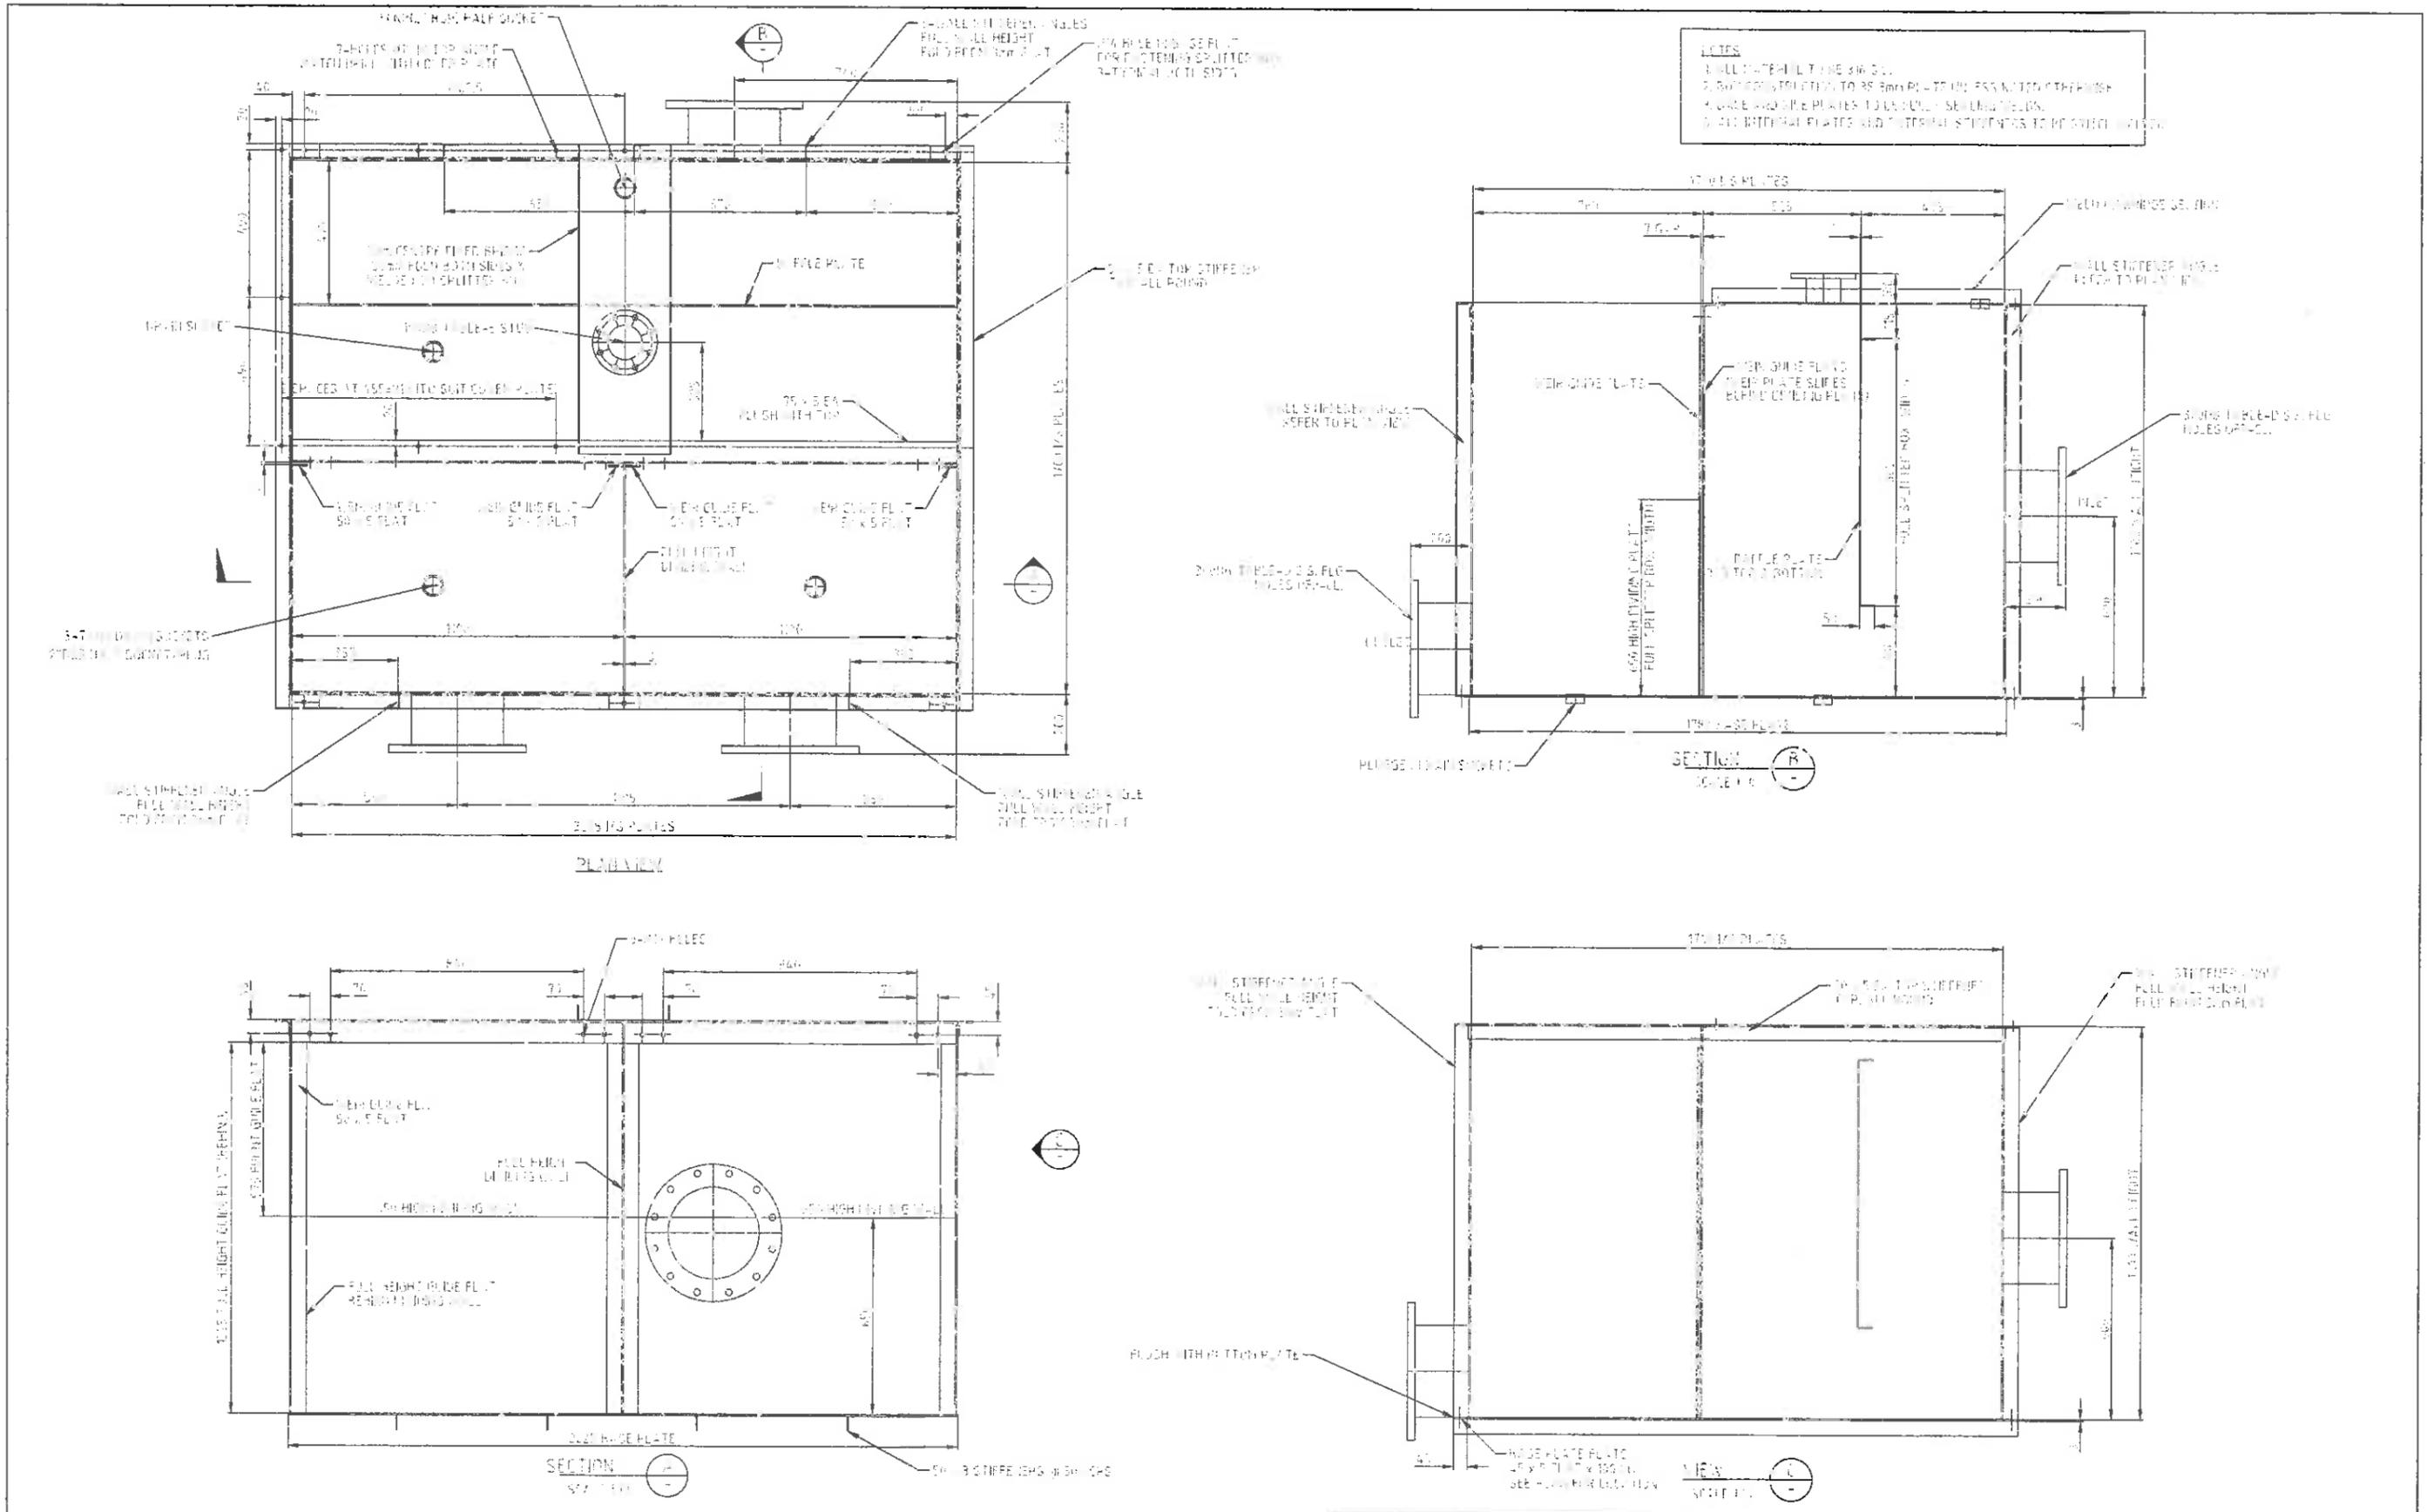

REV	DESCRIPTION	DRN	DATE	CHK	APP
0	AS BUILT		27.07.10		

AS BUILT

Scale 1:10



MANGAWHAI ECO CARE
MANGAWHAI INFRASTRUCTURE PROJECT

INLET WORKS
SPLITTER BOX DETAIL

Drawing No. A-89973-STR-7331 Rev 0
Sheet No. 89973
(c) Earth Tech Engineering Pty Ltd ABN 61 068 482 548 A1

Appendix B

Photos

Biofilter to be Removed



Biofilter and Bank on site of Balance Tank



Bank to be cut back for Construction



Base of Biofilter and Surface Material



Location of New Balance Tank



Back End of CASS and RAS Pumps



Location of New Balance Tank





Brush to be cleared

Bank to be Cut Back



Biofilter to be Removed



Surface Material on Balance Tank Area



Inlet Structure from East



Inlet Structure from South



Inlet with incoming Main




Underside View of Inlet Structure



Detail of upper level structure



Inlet Structure viewed from West

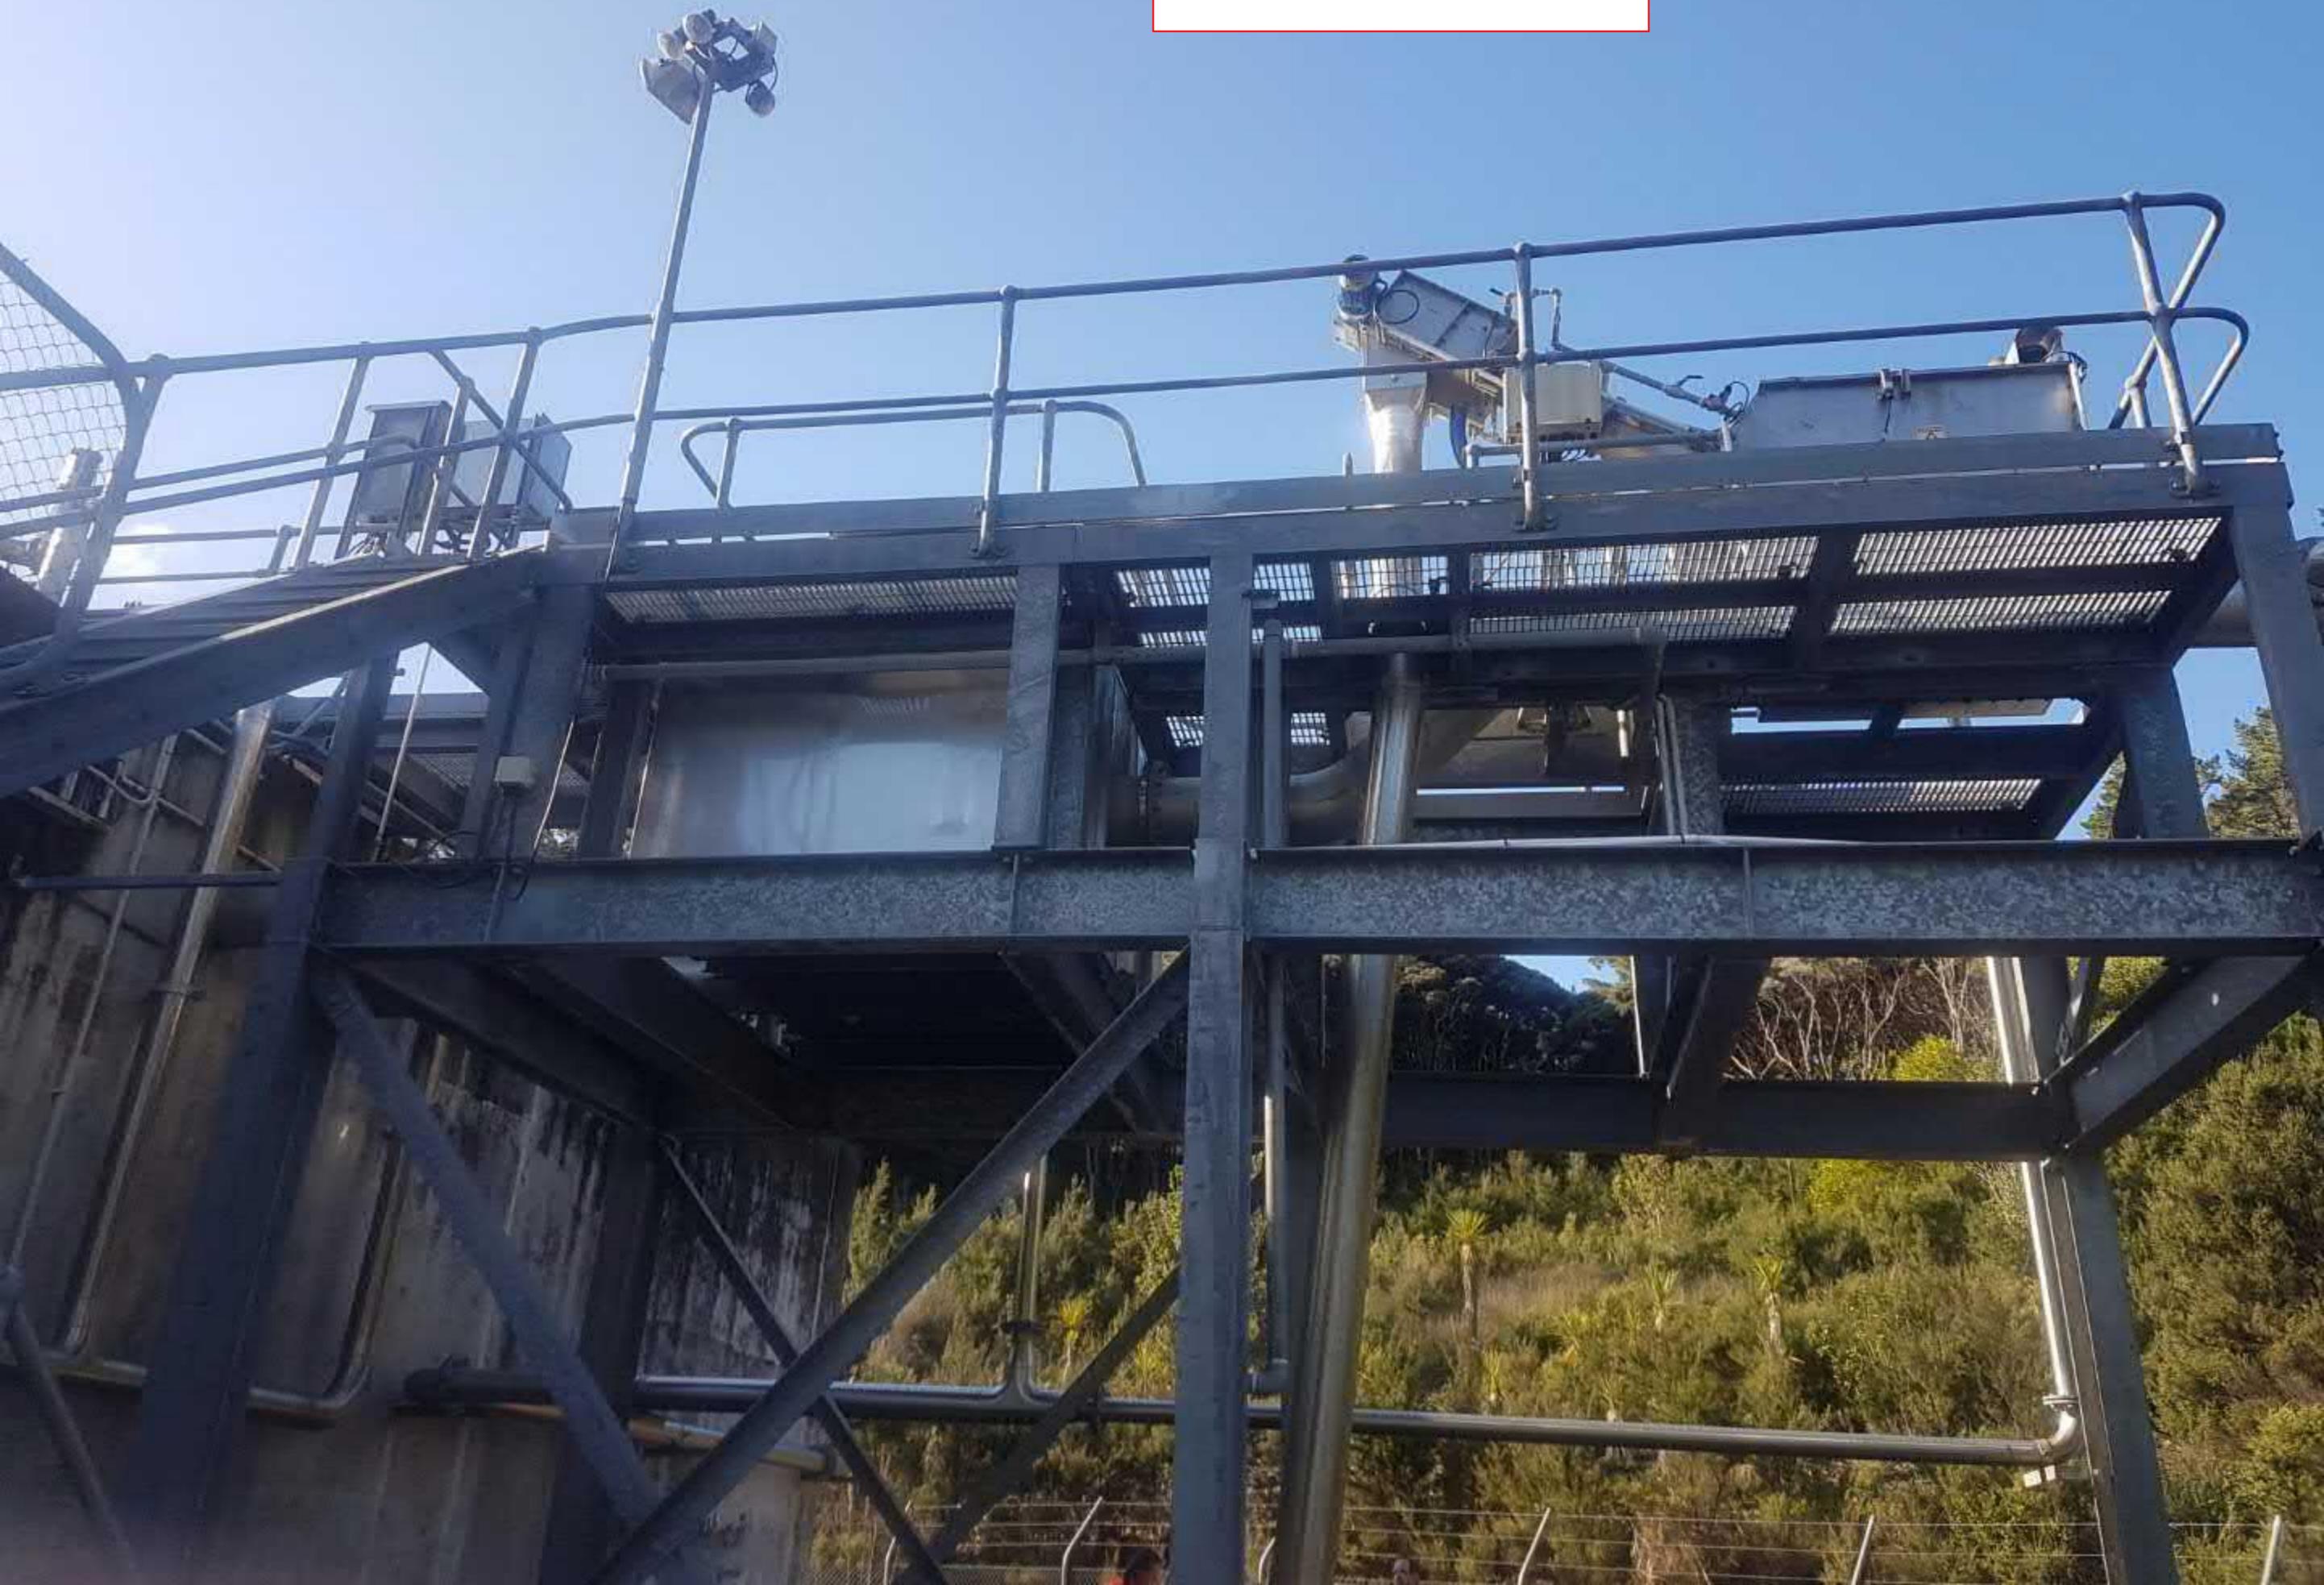

Access to CASS and Inlet



Stair Case and Mounting



SKIP AREA



CASS Inlet end and Internal Walls (New Balance Tank will not have internal walls)



CASS internal walls



CASS Reactor



General View of Balance Tank Area



General View of Balance Tank Area



Construction Joints in CASS Tank



Wall Detail CASS Tank



Appendix C

Hydraulic Profile Calculation

DRAFT

APPENDIX C Mangawhai Inlet Hydraulics Summary

S.No	levels	Calculated	From Drawings	
1	TWL in SBR	19.00	19.00	m
2	Headloss in discharge Pipework from Splitter Box to SBR	0.26	0.26	m
3	TWL in Splitter Box Outlet Side	19.26	19.26	m
4	V-Notch Weir IL	19.45	19.45	m
5	TWL Upstream of V-Notch Weir	19.77	19.77	m
6	Existing Screen IL	-	19.93	m
	Headloss Proposed Bypass to Ex Splitter	0.32		
7	TWL at proposed Bypass Chamber for 80 L/s	20.08	-	m
	Proposed Bypass Overflow Weir Level	20.18		
	Head over Rectangular Weir at 30 L/s	0.06		
8	TWL in Bypass Chamber @ 110 L/s	20.25	-	m
	Headloss Ex Screen to Proposed Bypass	0.26		
9	TWL at Screen Outlet	20.51	-	m

Height to Raise without any surcharge 0.58

Appendix D

Geotechnical Desktop Study

Kaipara District Council

MANGAWHAI COMMUNITY WASTEWATER TREATMENT PLAN EXPANSION (STAGE 1) GEOTECHNICAL DESKTOP STUDY

31 JULY 2020

PUBLIC



wsp

Question today
Imagine tomorrow
Create for the future

MANGAWHAI COMMUNITY WASTEWATER TREATMENT PLAN EXPANSION (STAGE 1)

GEOTECHNICAL DESKTOP STUDY

Kaipara District Council

WSP
Whangarei
Mansfield Terrace Service Lane
125A Bank Street
PO Box 553
Whangarei 0140, New Zealand
+64 9 430 1700
wsp.com/nz

REV	DATE	DETAILS
0	29 July 2020	First Issued Report

	NAME	DATE	SIGNATURE
Prepared by:	Dave WITJAKSONO	29 July 2020	
Reviewed by:	Glyn EAST		
Approved by:	Eros FOSCHIERI		

This document may contain confidential and legally privileged information, neither of which are intended to be waived, and must be used only for its intended purpose. Any unauthorised copying, dissemination or use in any form or by any means other than by the addressee, is strictly prohibited. If you have received this document in error or by any means other than as authorised addressee, please notify us immediately and we will arrange for its return to us.



Our ref: 1-14129.07

29 July 2020

Matthew Smith
Kaipara District Council
41 Hokianga Road
Dargaville
0310, New Zealand

Dear Matthew

Geotechnical Desktop Study – Mangawhai CWWTP Expansion (Stage 1)

This report presents the summary of our review we carried out to the site subsurface conditions and the geomorphology of the site based on the existing available information, and provides preliminary comments and recommendations for the proposed development of another two balance tanks to the northeast of the existing CASS tank.

Our general review of the available information indicates the site is generally geotechnically suitable for the proposed development. Specific comment in this regard is provided within this report.

Dave Witjaksono
Senior Geotechnical Engineer



TABLE OF CONTENTS

1	INTRODUCTION	1
1.1	BACKGROUND.....	1
1.2	OBJECTIVES AND SCOPE OF WORK.....	1
2	SITE APPRAISAL.....	2
2.1	SITE DESCRIPTION	2
2.2	GEOLOGICAL REVIEW.....	2
2.3	SUBSURFACE CONDITION.....	2
2.4	GROUNDWATER.....	3
3	GEOTECHNICAL ISSUES	4
3.1	FOUNDATION DESIGN.....	4
3.2	GROUND SETTLEMENT.....	4
3.3	SITE EARTHWORKS.....	4
3.4	GEOTECHNICAL DESIGN PARAMATERS.....	5
3.5	PAVEMENT	5
3.6	SITE SEISMICITY	5
3.7	LIQUEFACTION POTENTIAL.....	6
	APPENDIX A.....	7
	HISTORICAL SPT	7
	APPENDIX B	8
	HISTORICAL CPT	8
	APPENDIX C	9
	NEW CPT LOCATION FOR THE PROPOSED DEVELOPMENTS.....	9

1 INTRODUCTION

1.1 BACKGROUND

This geotechnical desktop study report was prepared by WSP for Kaipara District Council (KDC) in association with the proposed expansion of Mangawhai Community Waste Water Treatment Plan (CWWTP) Stage 1 as mentioned on WSP letter of service to KDC (Offer of service letter, Ref.: 1-14159.00, dated 17 June 2020). The purpose of this assessment has been to perform desktop study on the available geological, geotechnical and geomorphology information relevant for the current proposed expansion of the plant.

1.2 OBJECTIVES AND SCOPE OF WORK

In this financial year 2020/21 the proposed facility expansion is to build another two balance tanks immediately to the northeast of the existing CASS tanks. To facilitate the development of this facility, the scope of work has comprised the following:

- Desktop review of the geotechnical investigation report for the existing plant with its relevancy to the prevailing building codes;
- Provide assessments on of potential geohazard and constraints for the proposed development;
- Should it be needed, propose the required geotechnical investigation; and,
- Preparation of this Stage 1 Preliminary Geotechnical Desktop Study report.

2 SITE APPRAISAL

2.1 SITE DESCRIPTION

The site of the existing plant is situated on the westside on an isthmus which is surrounded by Mangawhai Harbour inlet on its eastern, southern, and western perimeter. The existing plant lies on a flat terrain but gently sloping to the south with the current existing CASS tank lies below the low hilly dunes to the southeast perimeter of Mangawhai Heads Golf Club. The current plant is accessible from short distance access road off the northeast side of Thelma South Road.

2.2 GEOLOGICAL REVIEW

Review of the geological formation for the site was carried out from the available online information published by the Geological and Nuclear Science (GNS website). The physiographic features of this area are mainly fluvial and coastal plains. The data from GNS website indicates that the site is underlain by late Pleistocene parabolic dune sands sediments of Kariotahi Group which (Quaternary sands) with the lithology [IQd]. This late Pleistocene dune sands is considered aged (>100,000 years) which is likely less susceptible to liquefy for the triggering events from this area.

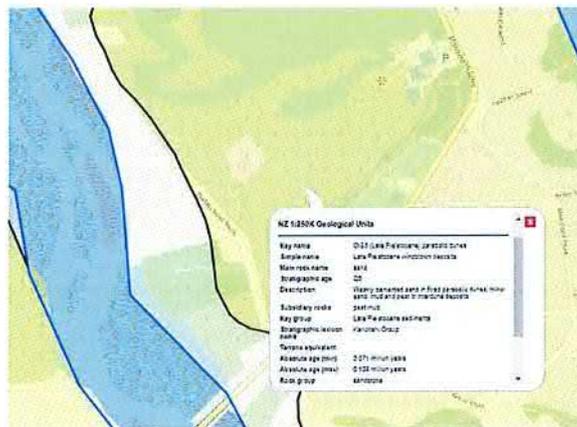


Figure 1: Geological Review from GNS.

Edbrook reported that this Pleistocene dune sands deposition comprises of weakly cemented and moderately consolidated to unconsolidated coastal sand deposits of shallow marine, beach and dune origin. Younger depositions of Holocene-aged fixed dunes overlay the Pleistocene dunes behind the active dune deposits on the coast. This formation has been actively vegetated despite its lacks well-developed soils.

There is not known of any active fault within the proximity of 500km from this this area.

2.3 SUBSURFACE CONDITION

The geotechnical investigations undertaken by Tonkin and Taylor in May 2006 comprised a total of 4 boreholes with SPT and 5 Cone Penetration Tests (CPT). These boreholes were drilled to a maximum depth of 10 m below the existing ground level. The CPT were pushed to maximum depth of 15 m. Two of boreholes were installed with piezometers with screening filter on the

bottom 2 – 3 m. Copies of the historic soil investigation logs and the CPT records are attached to this report together with a site plan showing their locations.

The borehole logs indicate that majority of the site was underlain by quaternary sands with the sequence of geology as the following prior to the development of the current plant:

- 0 m to 0.5 m below ground level: Topsoil;
- 0.5 m to 10.0 m below ground level: Estuarine deposits (CPT1, 2, 3, 4 and BH4), and;
- 10.0 m to end of boreholes: Quaternary sands (BH1, 2, 3, and CPT 5).

This estuarine deposit is likely formed from the water body trapped behind sand dunes. The estuarine deposits comprise of fine to medium grained sands with high plasticity silts and clays with some organic, having SPT'N' value from 2 to 9. The CPT readings suggested that this deposit is prevalent in most of the area at shallow depth, which is quite inconsistent with the adjacent boreholes and the recorded SPT'N' values.

The Waitemata formation Group is likely present beneath these dune sands formation at the depth of about 16 m.

2.4 GROUNDWATER

From the two piezometers on the site, it was recorded groundwater level of about 4 – 6 m below ground level which were taken during the wet period in June 2006. Despite this level is considered deep as to trigger liquefaction on this aged dense sand, the new proposed CPT will provide factual results to the issues.

3 GEOTECHNICAL ISSUES

We consider that the site is generally suitable for the proposed development of another two balance tanks to the northeast of the existing CASS tank. However, the presence of soft silty clay deposits which were recorded by the historical CPT at shallow depth should be considered as part of the due diligence process. Therefore, for the proposed future developments, at least another four CPTs are required to be placed to refusal with two of them within the footprint of the new proposed tanks structure with another two to the northwest of the existing intermediate storage tank. The plan showing the proposed CPT location is enclosed behind.

These new CPT readings together with the historical boreholes from Tonkin & Taylor will be used to develop for a new geological model which runs from northeast to southwest direction. As we were unable to obtain these historical CPT soft data for our processing, the new CPT data will be used to assess the liquefaction potential for the new developments in this area and the future expansion.

3.1 FOUNDATION DESIGN

The new balance tank is likely to be similar in shape and size to the adjacent CASS tank with footprint dimension of 20 x 15 sqm. With the tank stand of about 5 m above ground with 1 m embedment, it is expected to have maximum distributed pressure of about 60 kPa. An underground perimeter drainage should exist around this structure at the soffit level of the footing considering the high permeability of the foundation soils.

Where heavy loaded structure cannot be sufficiently supported by shallow foundations, a distributed raft foundation or slab below ground may be required. Pile foundation is unlikely required on this soil materials unless the new CPT result indicate that the ground is prone to liquefaction triggering in this area.

All foundation should extend below the topsoil materials by extending them to at least 0.5m depth. With all the structures founded on medium dense to stiff silts and loose sands of the quaternary deposition without any immediate soft compressible materials underneath and the groundwater is kept far below the foundation width, the foundation load is limited to an Ultimate (Rupture) Bearing Capacity of at least 300 kPa.

3.2 GROUND SETTLEMENT

The static ground settlement is likely to occur immediately during the construction of the new tanks structures. The total settlement of structures designed with an ultimate bearing capacity of 300 kPa is estimated to be between 10 mm and 20 mm. Increased bearing capacities may be possible, subject to favourable results from the new proposed CPT.

3.3 SITE EARTHWORKS

There is no record available from the earthworks which were carried out for the construction of the existing plant. However, we were made aware that the exiting plant were placed on the top of a maximum of 1 m of compacted fill materials which presumably was obtained locally. And we believe the all topsoil and unsuitable materials were stripped prior to the placement of this bulk fill.

Should the undulating hill on the northeast require cutting to allow for a flat platform for the new balance tanks, all new slope required to be battered with gradient of (V): (H) = 1: 2.5 for a maximum 2.5 m high with setback of 1 m wide terraces. To prevent the new cutting hill from wind erosion, replanting with the local scrubs and grass is advisable.

As the new balance tank requires excavation for placing the soffit level of the foundation, all short term battered can be safely achieve with gradient of (V): (H) = 1: 2 for a maximum of 2 m cut slope.

3.4 GEOTECHNICAL DESIGN PARAMATERS

Based on our review of the historical boreholes for the development of the existing plant, geotechnical parameters have been derived for each soil consistency encountered from each borehole and is presented on table below. These parameters have been assumed for engineering analysis including slope stability assessment, foundation design and retaining wall design.

Table 1 Geotechnical Design Parameters

SOIL CONSISTENCY	UNIT WEIGHT [KN/M ³]	EFFECTIVE FRICTION ANGLE [DEGREE]	EFFECTIVE COHESION [KPA]
Loose Sand	18	30	0
Med Dense Sand	18	32	0

3.5 PAVEMENT

We recommend heavy traffic be design using a subgrade CBR of 5. Proof rolling should be carried out under the supervision of a suitably qualified engineer or geologist, to confirm that the subgrade has the required stiffness. Any soft spots encountered should be sub-excavated and replaced with well compacted and well graded hardfill.

3.6 SITE SEISMICITY

Mangawhai CWWTP site is distant from any known geological active faults. Based on New Zealand Standard for Structural Design Actions (NZS 1170: 2004) favourable method for seismic site determination from shear wave velocity, we have carried out independent check from SPT'N' reading. In terms of NZS 1170, the site subsoil category should be taken as Class C (shallow soil sites).

For geotechnical design a horizontal seismic acceleration = 0.18g (ULS) and 0.03g (SLS1) may be used. This is derived using the following factors $C_{0,1000} = 0.1g$, $R_u = 1.8$ (ULS) and 0.25 (SLS1) and assuming a 1 in 2500-year event (ULS) and 1 in 25-year (SLS1).

3.7 LIQUEFACTION POTENTIAL

We were unable to obtain the soft data from the historical CPT for liquefaction potential assessments. With the fine-grained soil silty sands and sandy silts encountered on site and groundwater table is relatively high, we shall address this following the new CPT results.

APPENDIX A

HISTORICAL SPT



LEGEND
 Tonkin & Taylor Ltd
 Meehan, Borneak
 Location (May 2005)
 Tonkin & Taylor Ltd
 Test Pit Location
 (May 2005)
 CPT 1
 Tonkin & Taylor Ltd
 Cone Penetration Test
 Location (May 2008)
 SCALE 1: 1000

PROJECT: EARTHTECH MANGAWHAI SEWER PROJECT GEOTECHNICAL INVESTIGATION FILED INVESTIGATION PLAN SCALE: 1:1000	
Tonkin & Taylor Environmental & Engineering Consultants  Auckland 105 Corban Cove Rd, Newmarket Tel: (09) 305 6000 Fax: (09) 307 0885 Email: a.t@earthtech.co.nz www.earthtech.co.nz	
1. All dimensions are in metres unless noted otherwise. 2. Base drawing supplied by Gee Smart Ltd (Job Title Mangawhai O-His Resupply Job Number P101817)	
DRAWN: [] CHECKED: [] DATE: []	PROJECT: P-131428-001-01 DRAWING: 131428.001-01
NOT FOR CONSTRUCTION This drawing is not to be used for construction	
REVISION: [] BY: [] DATE: []	REFERENCE: []



TONKIN & TAYLOR LTD
BOREHOLE LOG

BOREHOLE No: BHI
Hole Location: GPS mark 39
SHEET..... OF.....

PROJECT: Mangawhai Sewer Plant - Geo		LOCATION: Mangawhai		JOB No: 23428.001															
CO-ORDINATES mN mE		DRILL TYPE: GEOPROBE		HOLE STARTED: 15/5/06															
R.L. DATUM		DRILL METHOD: Percussion		HOLE FINISHED: 15/5/06															
		DRILL FLUID: N/A		DRILLED BY: LDE															
				LOGGED BY: SJWW CHECKED: JRL															
GEOLOGICAL		ENGINEERING DESCRIPTION																	
GEOLOGICAL UNIT, GENERIC NAME, ORIGIN, MINERAL COMPOSITION.		FLUID LOSS	NUMBER	CORE RECOVERY	METHOD	CASING	TESTS	SAMPLES	R.L. (m)	DEPTH (m)	GRAPHIC LOG	CLASSIFICATION SYMBOL	MOISTURE CONDITION	WEATHERING CLASSIFICATION	SHANK'S TRENCH (UP)	COMPRESSION STRENGTH (kPa)	DEFECT SPACING (mm)	SOIL DESCRIPTION Soil type, minor components, plasticity or particle size, colour.	
																		ROCK DESCRIPTION Substance Rock type, particle size, colour, mineral components Defects: Type, inclination, thickness, roughness, shape.	
TOPSOIL										0		MH		VSI				SILT, some fine sand, moderately to highly plastic, stiff to very stiff, some roots in top 200mm, grey brown. NO RECOVERY.	
QUARTERNARY SANDS					AUGER					1		MH						SILT, some fine sand, some clay, very stiff, highly plastic, wet, light grey (very), mottled light orange brown.	
			450	1050	SPT		2 3 2 N=3			2		SM		L				SAND (fine), loosely packed, moist to wet, occasional black carbonaceous specks throughout, light orange brown.	
BOX 1			450	1050	SPT		3 5 4 N=9			3									
			450	1050	SPT		3 4 3 N=9			4									
			450	1050	SPT		2 4 6 N=10			5								- becomes very light brown, white and black specks, saturated.	
			150	1050	SPT		3 4 8 N=12			6				MD				- black carbonaceous material for 50mm (1mm thick layers). - becomes orange brown, some silt and lightly packed. - becomes loosely packed, minor silt.	
BOX 2			450	1050	SPT		3 5 9 N=14			7								- becomes tightly packed, light brown with black carbonaceous specks and streaks, silty. - minor silt, loosely packed.	
BOX 3										8								END OF BOREHOLE AT 10.0m	



TONKIN & TAYLOR LTD

BOREHOLE LOG

BOREHOLE No: BH2
 Hole Location: GPS mark 40
 SHEET..... OF.....

PROJECT: Mangawhai Sewer Plant - Geo		LOCATION: Mangawhai		JOB No: 23428.001							
CO-ORDINATES mN mE		DRILL TYPE: GEOPROBE		HOLE STARTED: 15/5/06							
R.L. m		DRILL METHOD: Percussion		HOLE FINISHED: 15/5/06							
DATUM		DRILL FLUID: N/A		DRILLED BY: LDE LOGGED BY: SJW/vy CHECKED: JRI							
GEOLOGICAL				ENGINEERING DESCRIPTION							
GEOLOGICAL UNIT, GENERIC NAME, ORIGIN, MINERAL COMPOSITION	FLUID LOSS WATER	CORE RECOVERY	TESTS	DEPTH (m)	CLASSIFICATION SYMBOL	MOISTURE CONTENT	STRENGTH CLASSIFICATION	SHEAR STRENGTH (kPa)	COMPRESSIVE STRENGTH (kPa)	DEFECT SPACING (mm)	BORE DESCRIPTION Soil type, major components, plasticity or particle size, colour. ROCK DESCRIPTION Substrata: Rock type, particle size, colour, fracture components. Defects: Type, orientation, thickness, roughness, filling.
QUATERNARY SANDS				1	MH		V+				SILT, some fine sand, highly plastic, wet, brown. - becomes light brown orange, very stiff. - twigs. SAND (fine to medium), some silt, loosely packed, wet, light brown orange brown. NO RECOVERY.
			4 4 5 N=9	2	SM		L				
			4 4 5 N=10	3							
			4 4 5 N=10	4							
			4 4 5 N=10	5							
			5 4 8 N=14	6							
			3 3 8 N=13	7	MH		St				
				8			St				
				9							
				10							

BOX 1

BOX 2

BOX 3



TONKIN & TAYLOR LTD
BOREHOLE LOG

BOREHOLE No: BH3
Hole Location: GPS mark 41
SHEET...!..... OF.....!.....

PROJECT: Mangawhai Sewer Plant - Geo	LOCATION: Mangawhai	JOB No: 23428.001
CO-ORDINATES mN mE	DRILL TYPE: GEOPROBE	HOLE STARTED: 16/5/06
R.L. m	DRILL METHOD: Percussion	HOLE FINISHED: 16/5/06
DATUM	DRILL FLUID: N/A	DRILLED BY: LDE
		LOGGED BY: SJWW CHECKED: JRL

GEOLOGICAL		ENGINEERING DESCRIPTION																	
GEOLOGICAL UNIT, GENERIC NAME, ORIGIN, MINERAL COMPOSITION.	FLUID LOSS	WATER	CORE RECOVERY	METHOD	CASING	TESTS	SAMPLER	R.L. (m)	DEPTH (m)	GRAPHIC LOG	CLASSIFICATION SYMBOL	MOISTURE CONDITION	WEATHERING	STRENGTH/STABILITY CLASSIFICATION	SHEAR STRENGTH (kPa)	COMPRESSIVE STRENGTH (kPa)	DEFECT SPACING (mm)	SOIL DESCRIPTION	
																		ROCK DESCRIPTION	
TOPSOIL									0		OL			St					SILT, some sand (fine), organic, roots, dark brown.
QUARTERNARY SANDS				AUGER					1		SM								SAND (fine), very silty, non plastic, moist to wet, highly packed, grey brown.
				AUGER		3 4 N=7			2		MH								SILT, slightly sandy, highly plastic, stiff to very stiff, wet, light brown mottled orange.
				AUGER		4 5 N=8			3										- firm for 100mm.
				AUGER		4 5 N=12			4					M-D					SAND (fine to medium), loosely packed, wet, occasional black specks, (carbonaceous material / or weathering), light orange brown.
				AUGER		4 5 N=12			5										- becomes saturated.
BOX 1				AUGER					6										
				AUGER					7										
BOX 2				AUGER					8		MII								- 50mm layer silty, very light grey / brown.
				AUGER					9										SILT, sandy (fine), saturated, soft to firm in some parts, SAND is dominant fraction (loosely packed), light brown.
				AUGER					10		SM			D					SAND, fine to medium, wet, only just tightly packed, orange brown mottled black.
BOX 3				AUGER					9										END OF BOREHOLE AT 9.0m
									10										- rods jammed. - piezometer installed. - 0.0 to 7.0m bentonite seal. - screened 7.0 to 9.0m.



TONKIN & TAYLOR LTD


BOREHOLE LOG

BOREHOLE No: BH4
 Hole Location: GPS mark 42
 SHEET OF
 1

PROJECT: Mangawhai Sewer Plant - Geo		LOCATION: Mangawhai		JOB No: 23428.001													
CO-ORDINATES mN mE		DRILL TYPE: GEOPROBE		HOLE STARTED: 16/5/06													
R.L. m		DRILL METHOD: Percussion		HOLE FINISHED: 16/5/06													
DATUM		DRILL FLUID: N/A		LOGGED BY: SIWW CHECKED: JRI.													
GEOLOGICAL			ENGINEERING DESCRIPTION														
GEOLOGICAL UNIT, GENERAL NAME, ORIGIN, MINERAL COMPOSITION	FLUID LOSS WATER	COPE RECOVERY	METHOD	CASING	TESTS	SAMPLES R.L. (m)	DEPTH (m)	GRAPHIC LOG	CLASSIFICATION SYMBOL	MOISTURE CONDITION	WEATHERING	STRENGTH CLASSIFICATION	SHEAR STRENGTH (kPa)	COMPRESSIVE STRENGTH (MPa)	DEFECT BRACING (mm)	BOL DESCRIPTION Soil type, minor components, plasticity or particle size, colour.	ROCK DESCRIPTION Substance: Rock type, particle size, colour, minor components. Defects: Type, location, thickness, roughness, filling.
TOPSOIL									OL			F				SILT, sandy, organic, roots, wet, dark brown.	
ESTUARINE DEPOSITS		450	SPT		0		1		MH			St				SILT, some sand, moderately plastic, wet, firm, light brown mottled orange.	
		1050	AUGER		1		2		SM							SAND (fine to medium), some silt, loosely packed, light orange brown.	1.7
BOX 1		450	SPT		0		3		MH							SILT, sandy, stiff to very stiff, roots, low to moderately plastic, light brown grey. - becomes clayey, minor sand, very highly plastic, firm to stiff.	2
		1050	AUGER		0		4		SM			L				- becomes orange brown.	3
		450	SPT		0		5		SM							SAND (fine), crumbly, tightly packed, hard, moist, limonite, orange brown (dark orange).	
		1050	AUGER		2		6		MH							SAND (fine to medium), loosely packed to tightly packed orange brown with black fine gravel sized specks.	4
BOX 2		450	SPT		2		7		MH							SILT, minor fine sand, wet, stiff, highly plastic, orange brown.	
		1050	AUGER		3		8		MH							SILT, hard orange brown with very hard SAND to coarse gravel sized angular orange brown clasts of limonite.	5
		1450	AUGER		6		9		SM			MD				SILT, clayey, minor fine to coarse rounded sand, (sand green grey and white), very highly plastic, stiff to very stiff, light grey. - coarse gravel very rounded (one).	5
BOX 3		925	SPT		12		10					D				SAND (fine), silty with some medium to coarse SAND tightly packed. - coarse gravel sized light green grey SILT clast. - 6.0 to 6.5m orange brown to brown stained layers up to 10mm thick.	6
		1450	AUGER		30		11									- saturated.	7
					20 for 30mm bouncing		12									END OF BOREHOLE 4 AT 7.0m	7
							13									- rods jammed.	8
							14										9
							15										10

APPENDIX B


HISTORICAL CPT

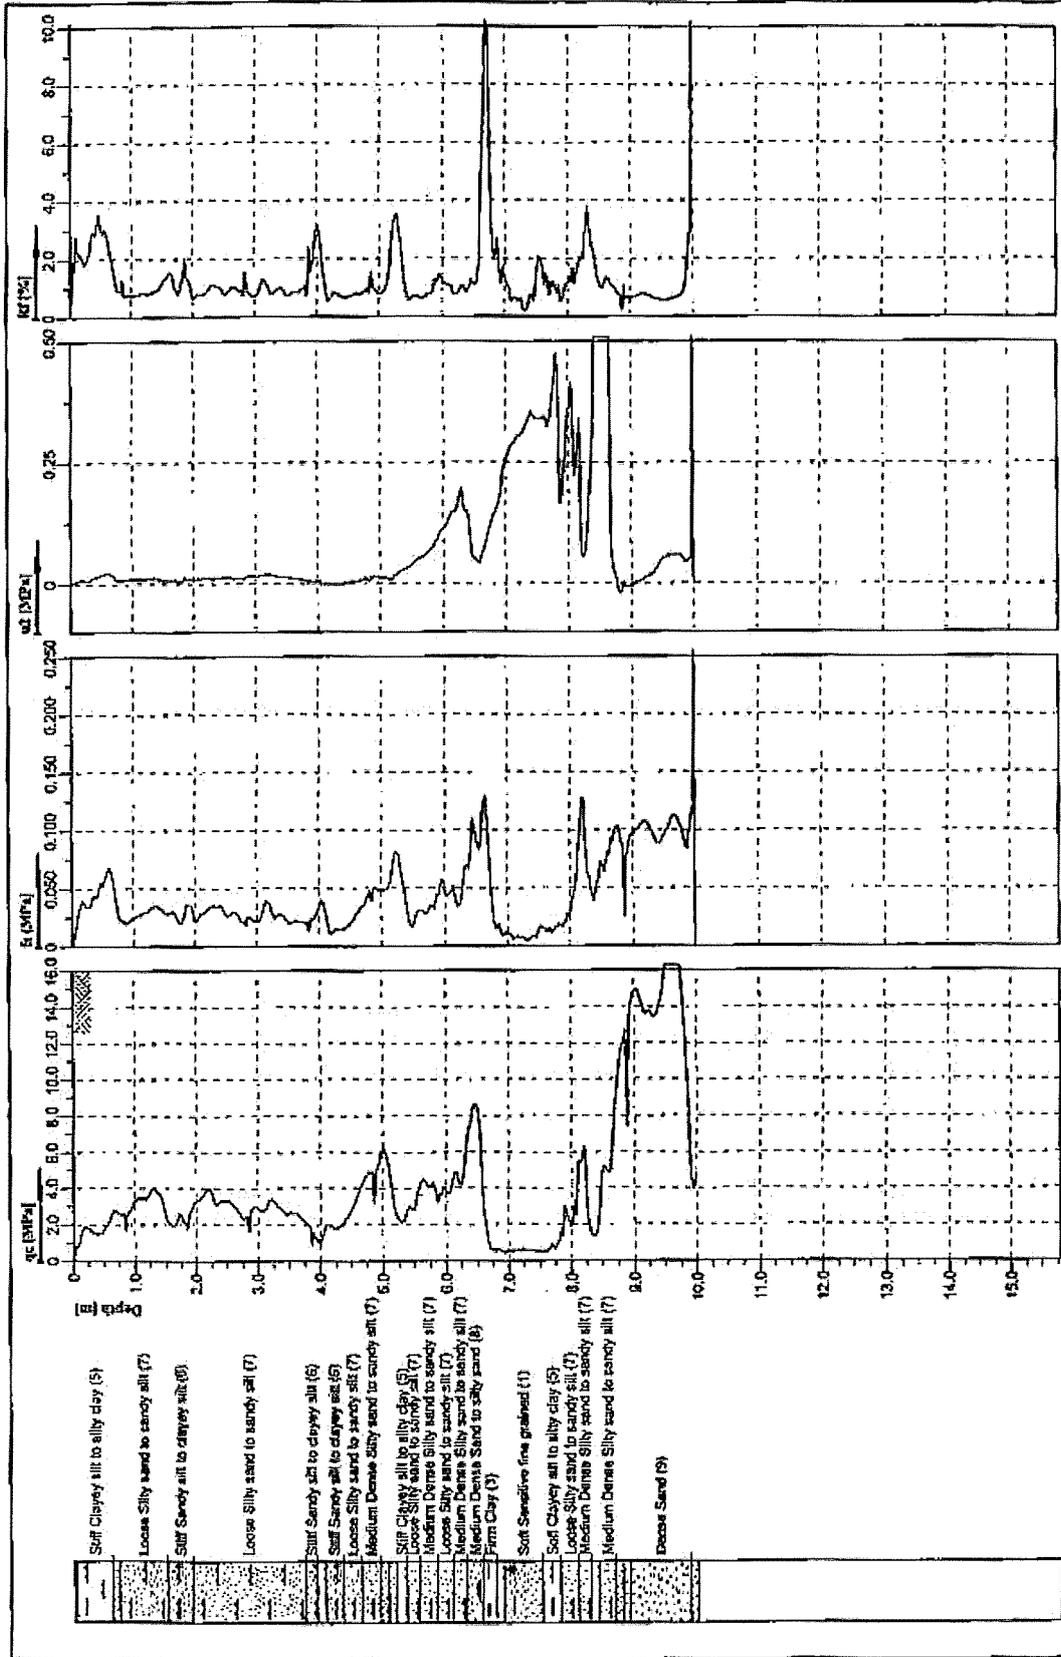

Location:	MANGAWHAI HEADS	Postbox:	
Project ID:	D1131	Client:	TONKIN B. TAYLOR LTD
Project:	MANGAWHAI HEADS SEWER PLANT - 23428.001	Ground level:	0.00
		Test no:	CPT1
		Scale:	1 : 1 : 100
		Page:	1/1
		File:	cp110.001





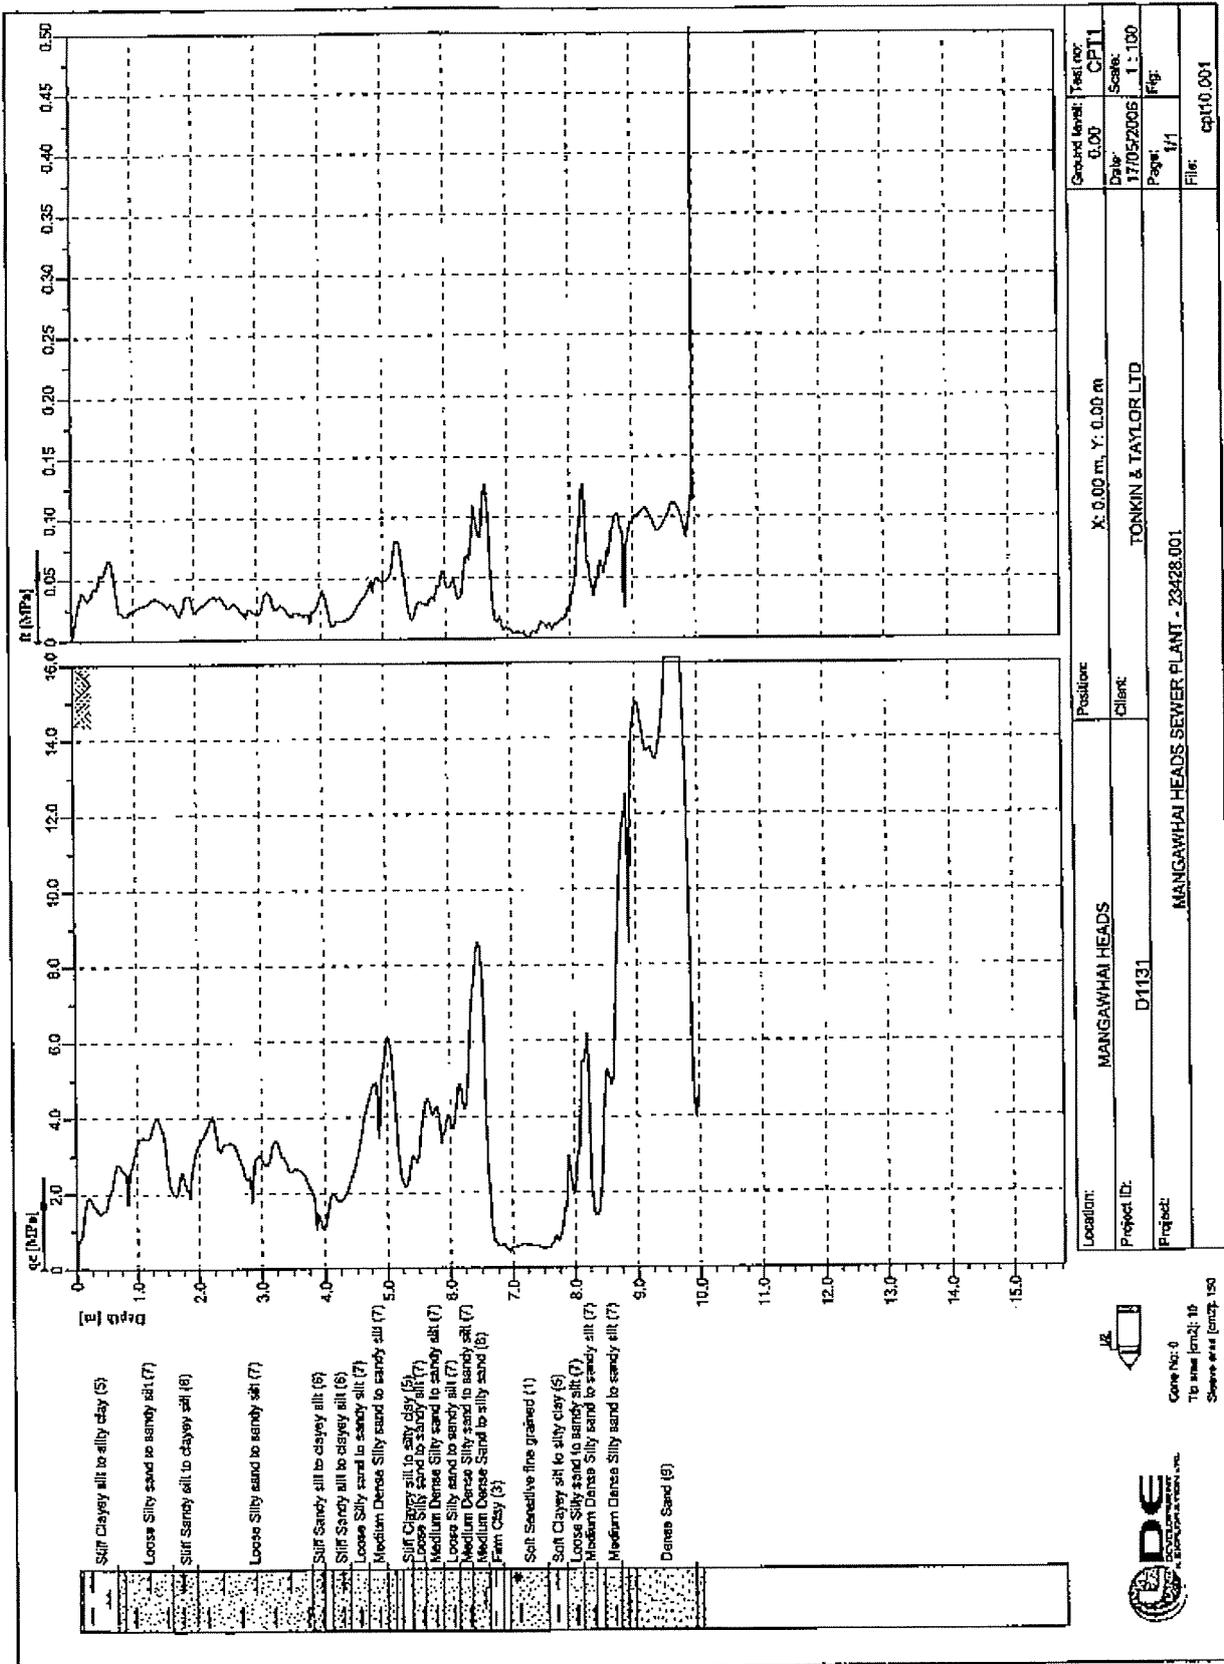

Location:	MANGAWHAI HEADS	Position:	X: 0.00 m, Y: 0.00 m
Project ID:	D1131	Client:	TONKIN & TAYLOR LTD
Project:	MANGAWHAI HEADS SEWER PLANT - 23428.001		
Date:	17/05/2006	Scale:	1 : 100
Page:	1/1	Fig:	
File:	cpt10_001		




Scale: 1:100
 Date: 17/05/2006
 Page: 1/1
 File: cpt10_001

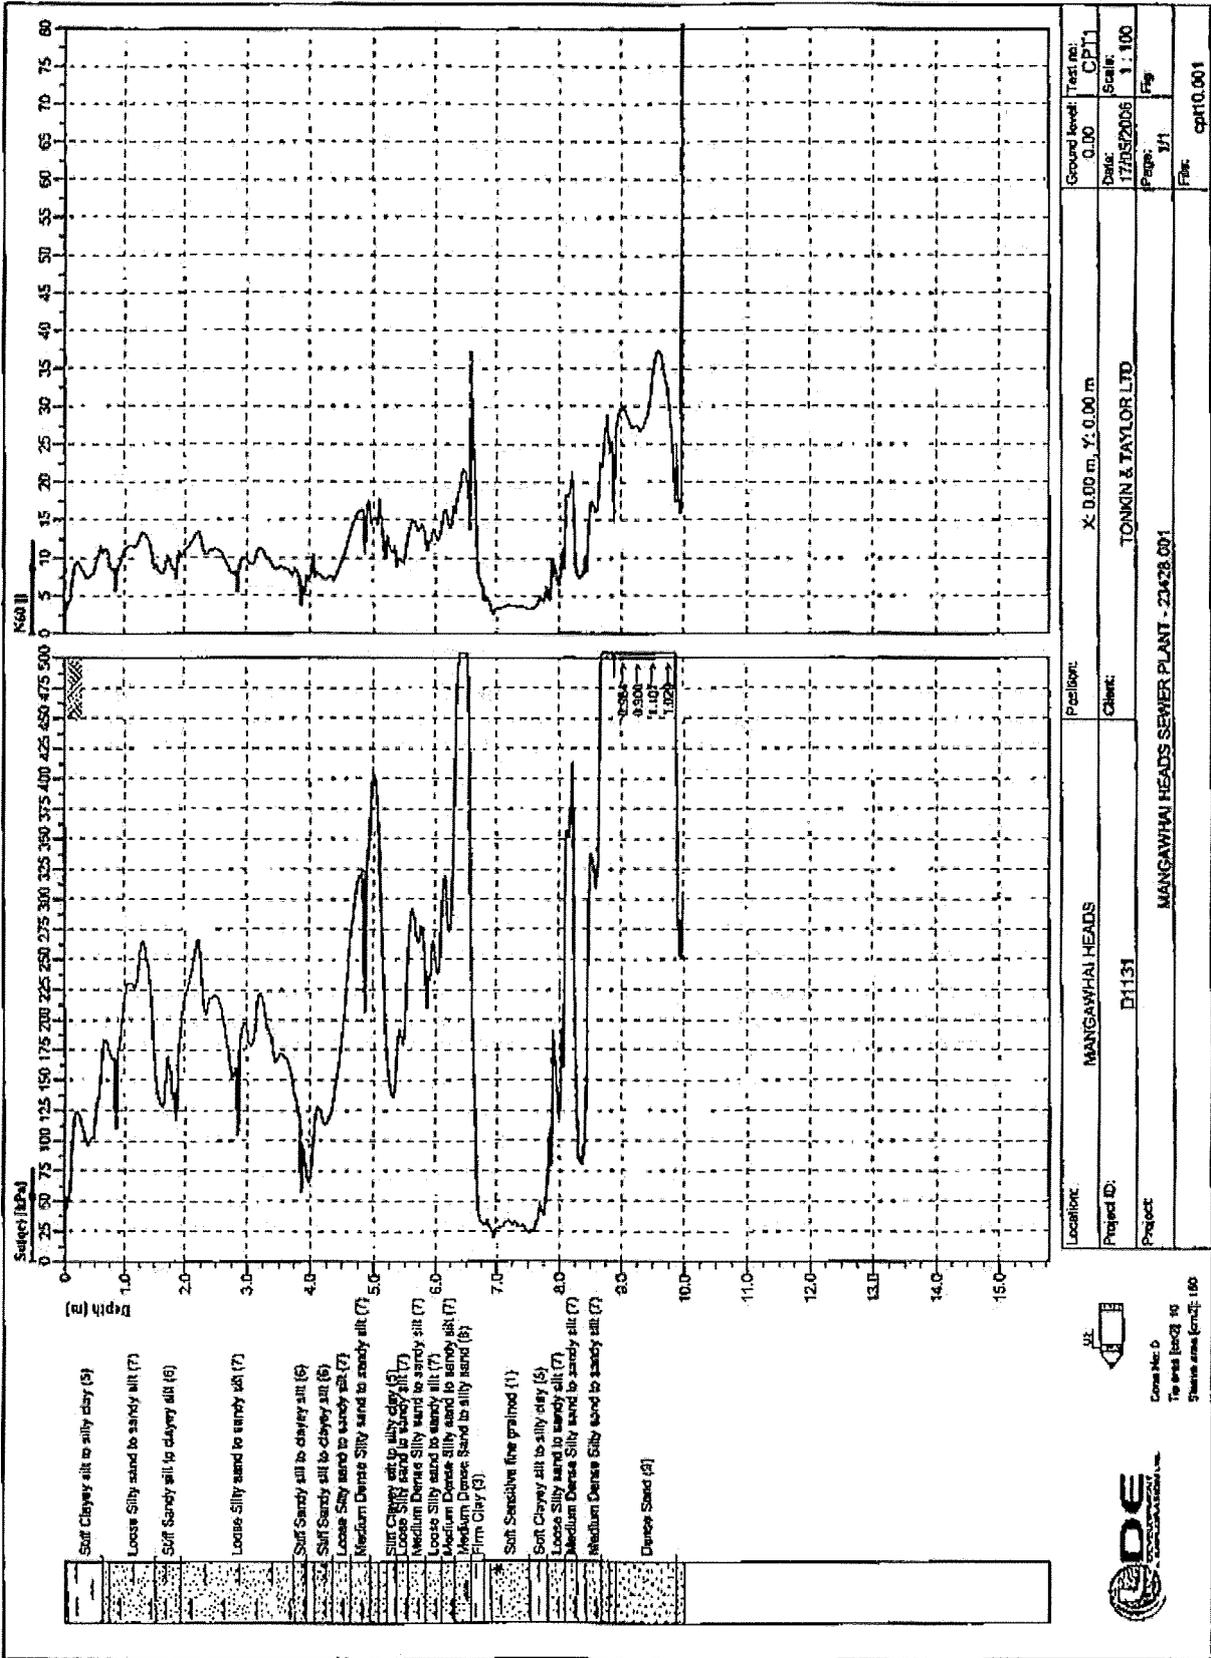


Scale: 1:100
 To area (m²): 15
 Square area (m²): 150



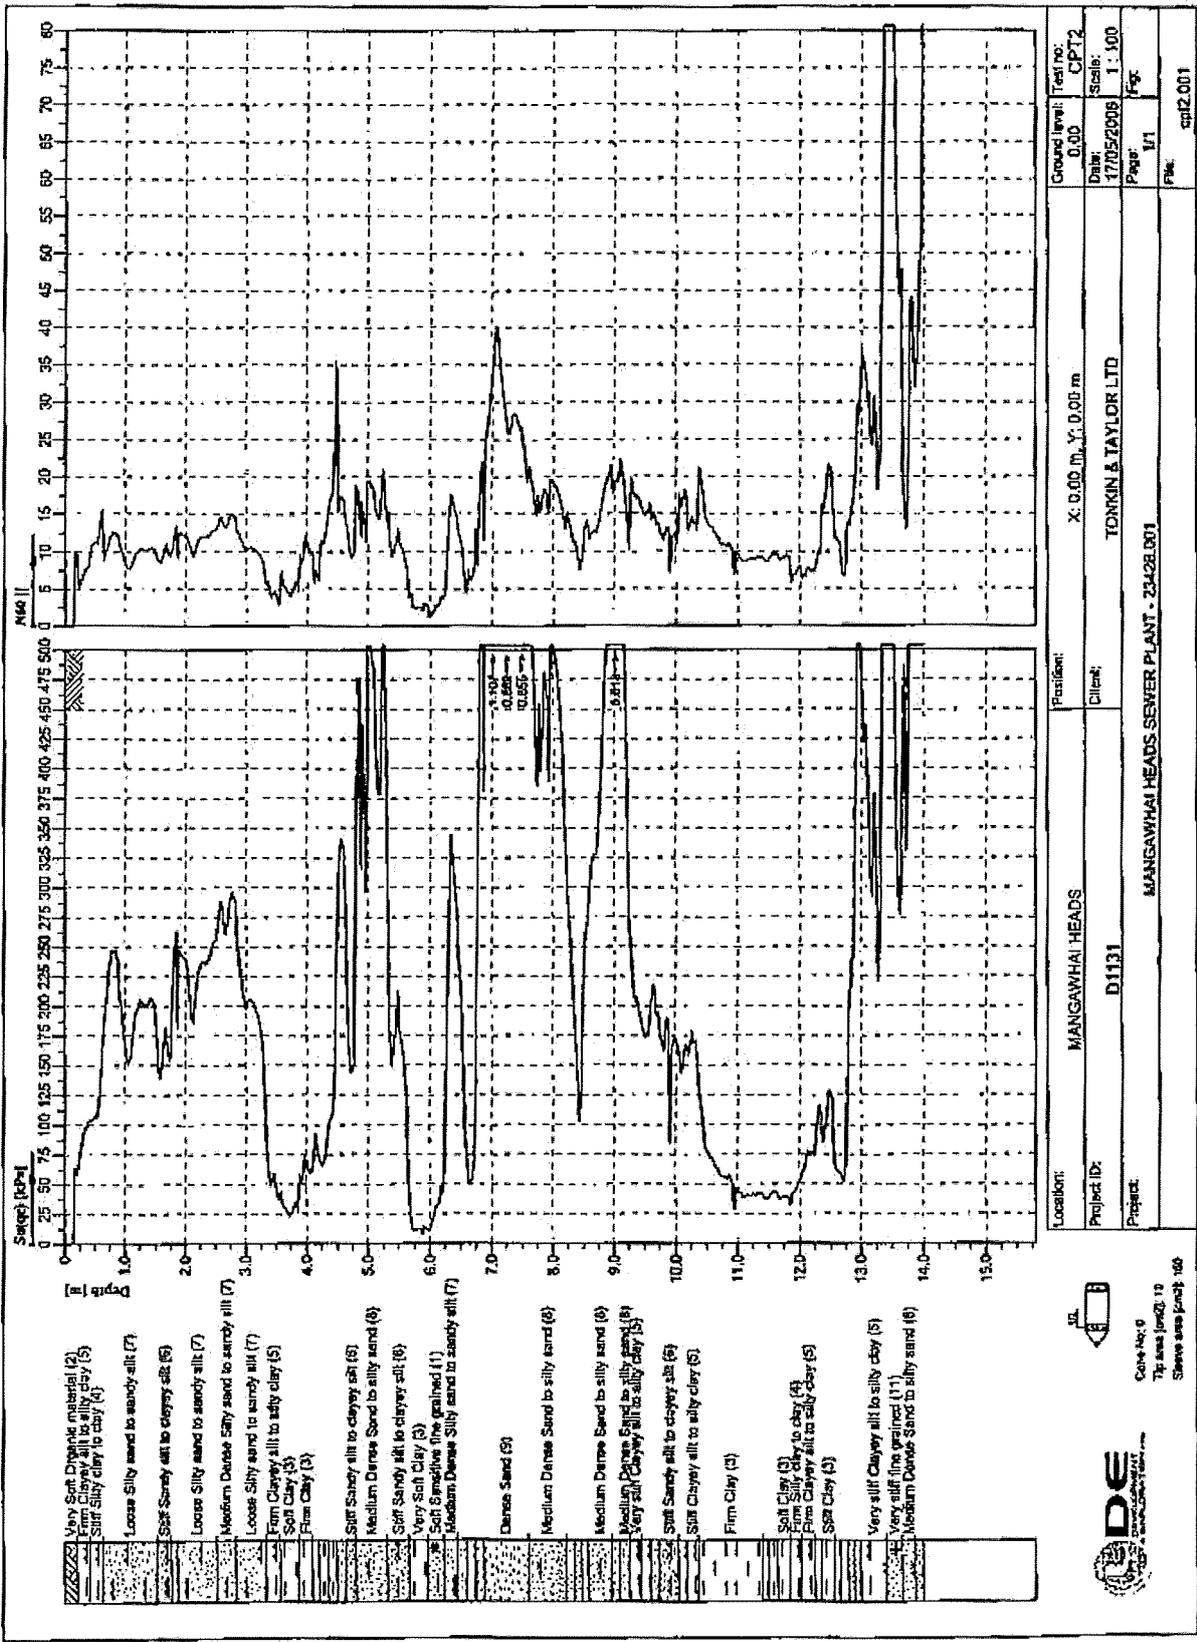


DE

Tip area [m²]: 12
Sleeve area [m²]: 100

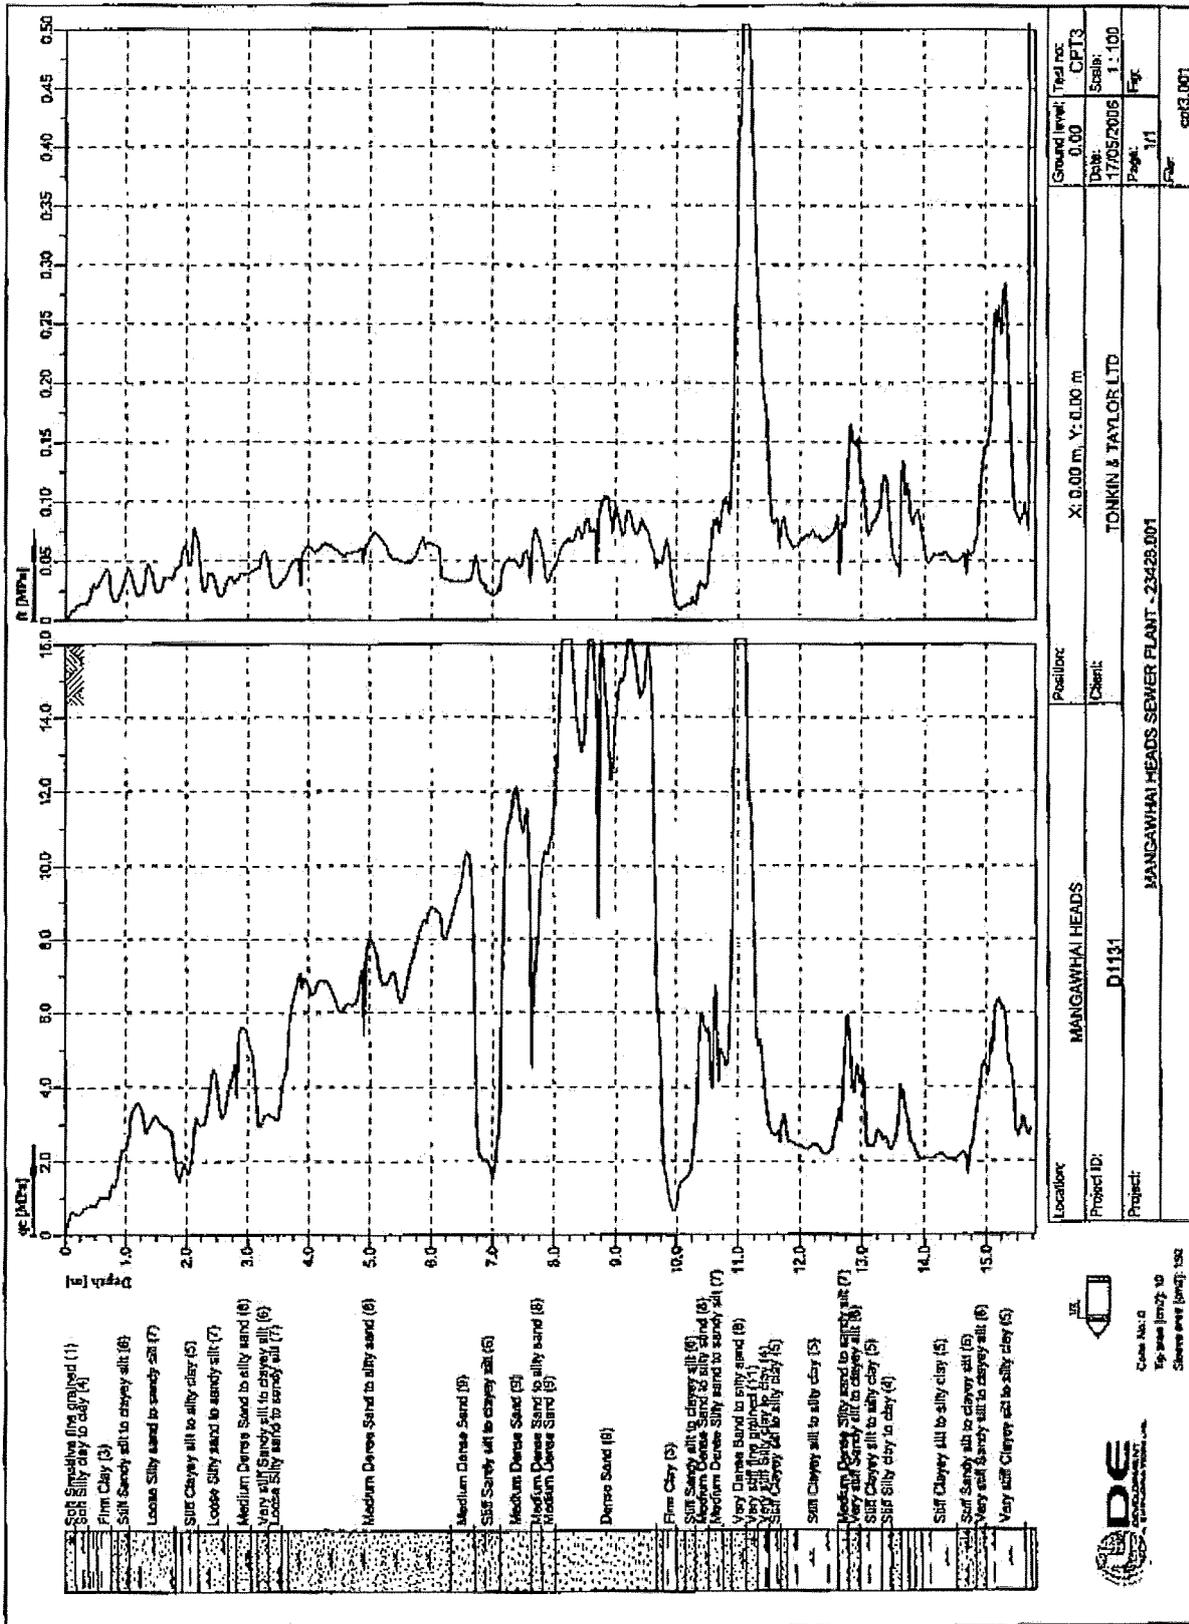

Scale: 1:100
 Tip area (mm²): 100
 Sleeve area (mm²): 150

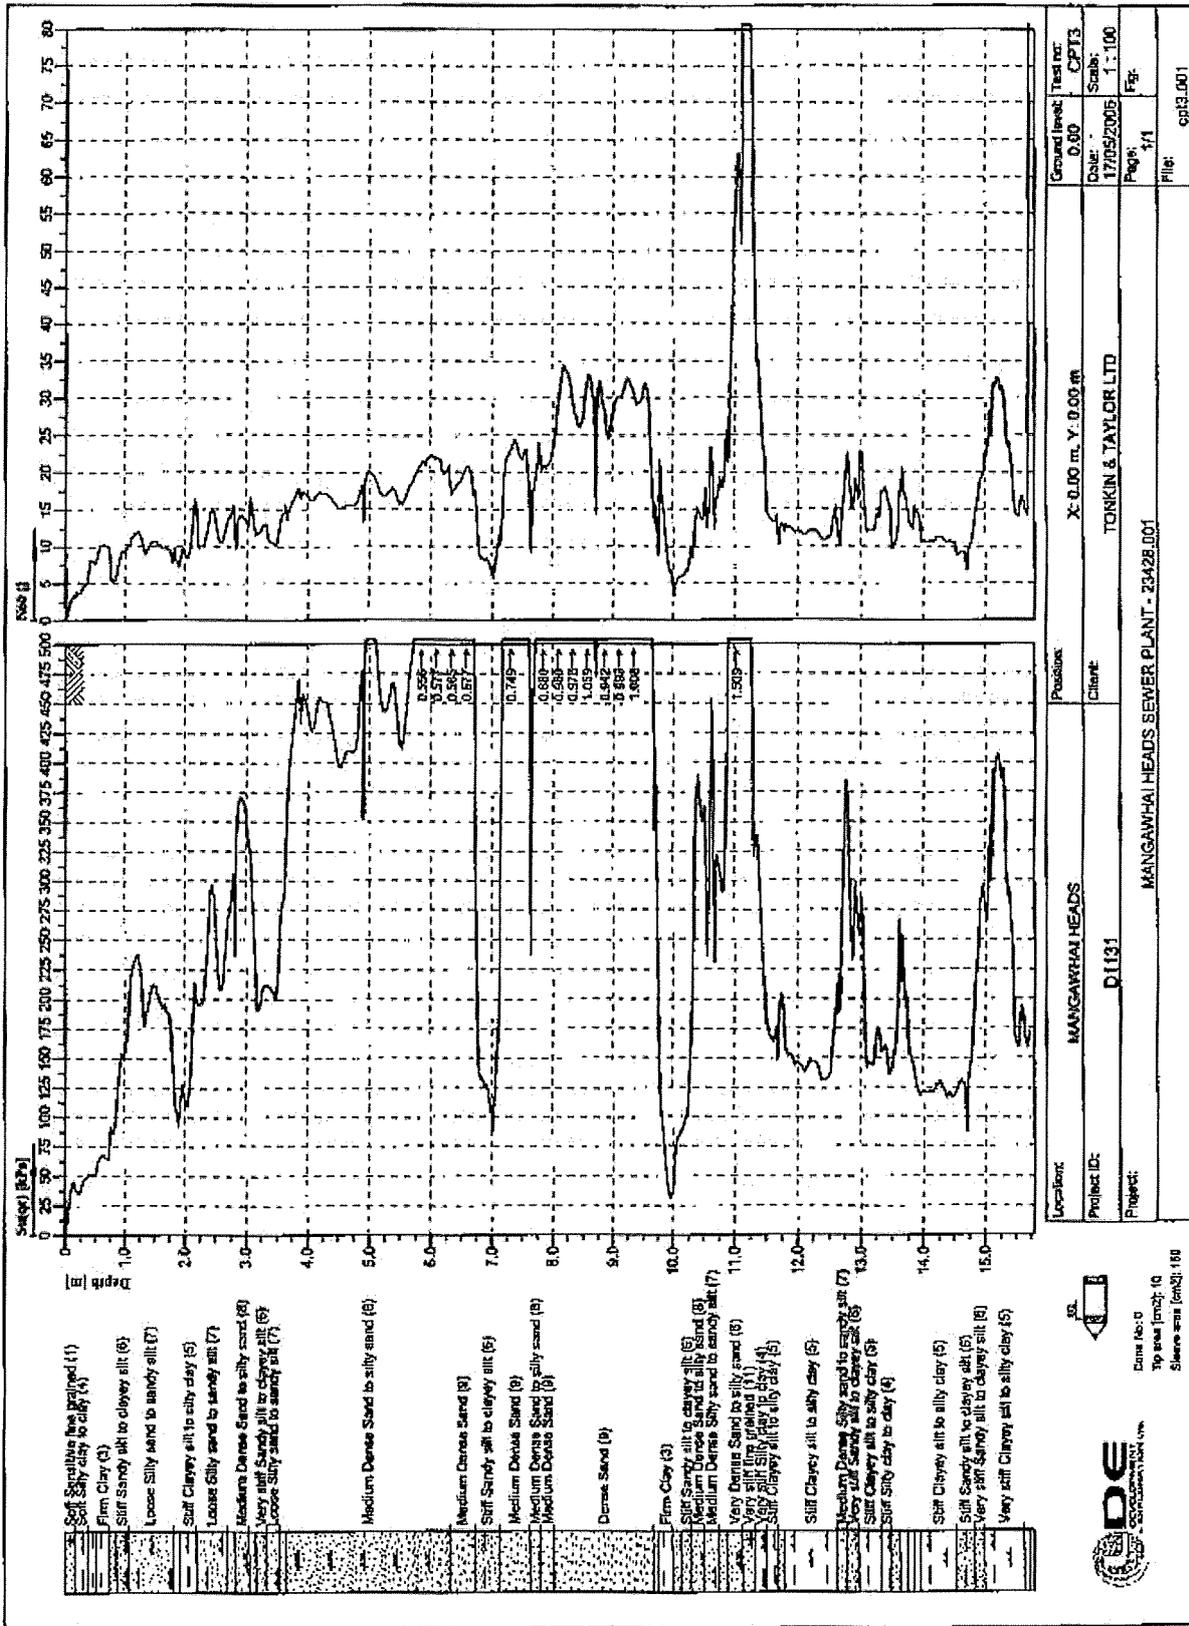


Ground level: 0.00
 Date: 17/05/2005
 Scale: 1:100
 Test ref: CPT3
 Page: 1/1
 File: ept3_001

Position: X: 0.00 m, Y: 0.00 m
 Client: TONKIN & TAYLOR LTD
 Project ID: D1131
 Project: MANGAWHAI HEADS SEWER PLANT - 2342B.D01

Location: MANGAWHAI HEADS
 Project ID: D1131
 Project: MANGAWHAI HEADS SEWER PLANT - 2342B.D01



 Date Rec'd: _____
 To: _____
 From: _____
 Scale: _____

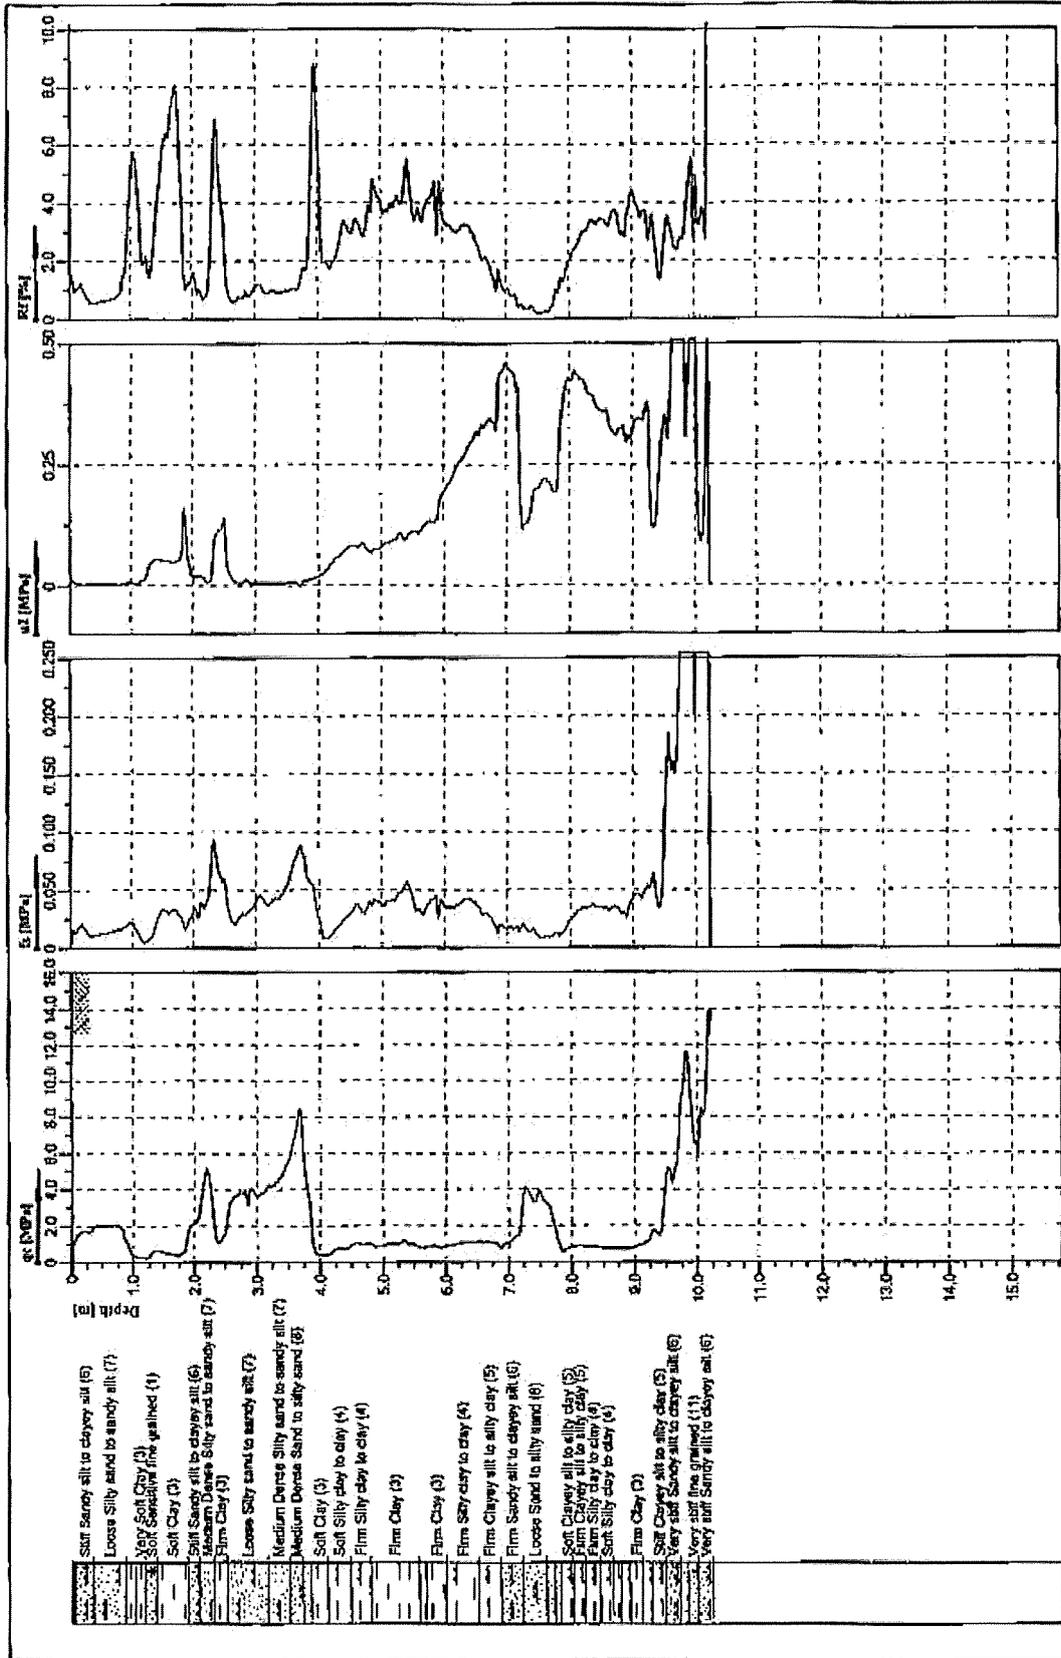



Location:	MANGAWHAI HEADS	Position:	X: 0.00 m, Y: 0.00 m	Test no.:	CPT 4
Project ID:	D1131	Client:	TONKIN & TAYLOR LTD	Date:	17/05/2005
Project:	MANGAWHAI HEADS SEWER PLANT - 23428.001	Scale:	1 : 100	Page:	1/1
		File:	cp115.001		

Cone No: 0
 Tip area (cm²): 10
 Sleeve area (cm²): 150



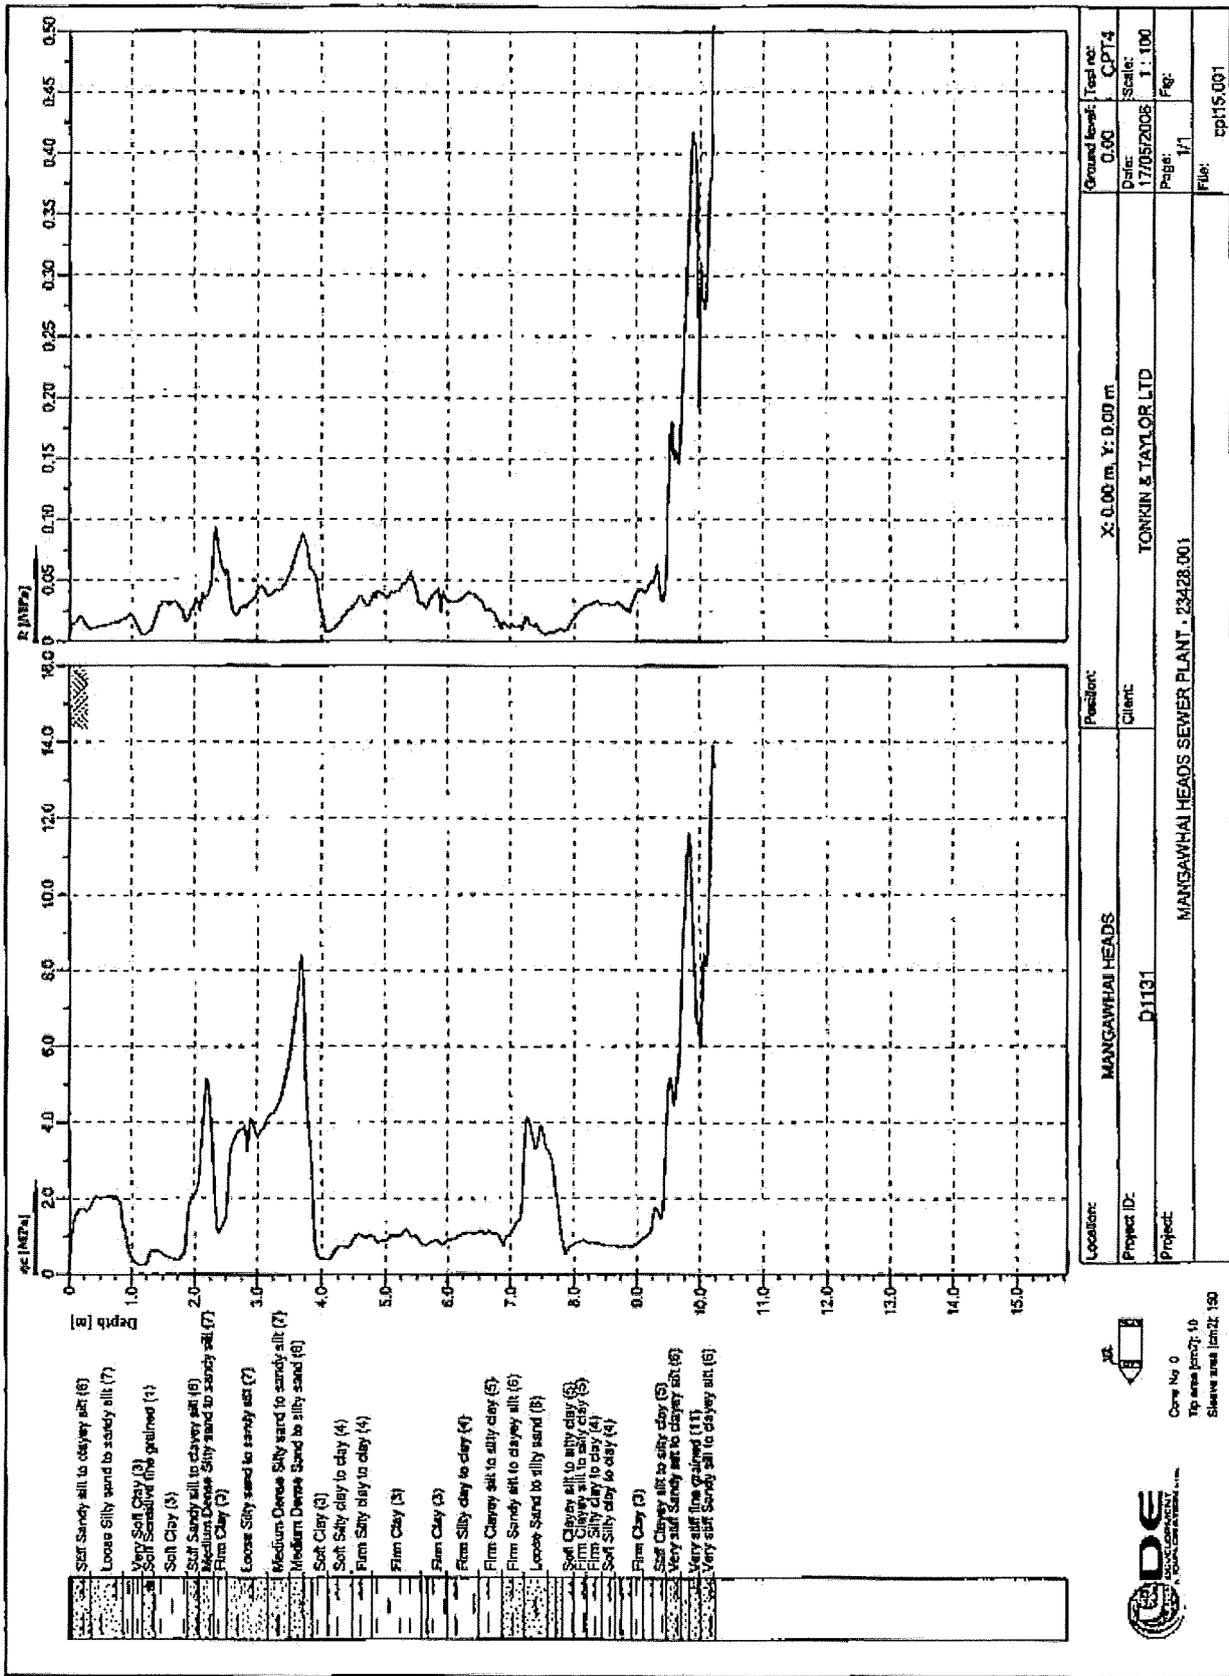

Location:	MANGAWHAI HEADS	Position:	X: 0.00 m, Y: 0.00 m	Ground level:	0.90	Test no.:	CPT-4
Project ID:	D1131	Client:	TONKIN & TAYLOR LTD	Date:	17/05/2008	Scale:	1:100
Project:	MANGAWHAI HEADS SEWER PLANT - 23428.001	Page:	1/1	Fig:		File:	cp115.001




 Core No 0


 Tip area (mm²): 10

 Sleeve area (mm²): 190



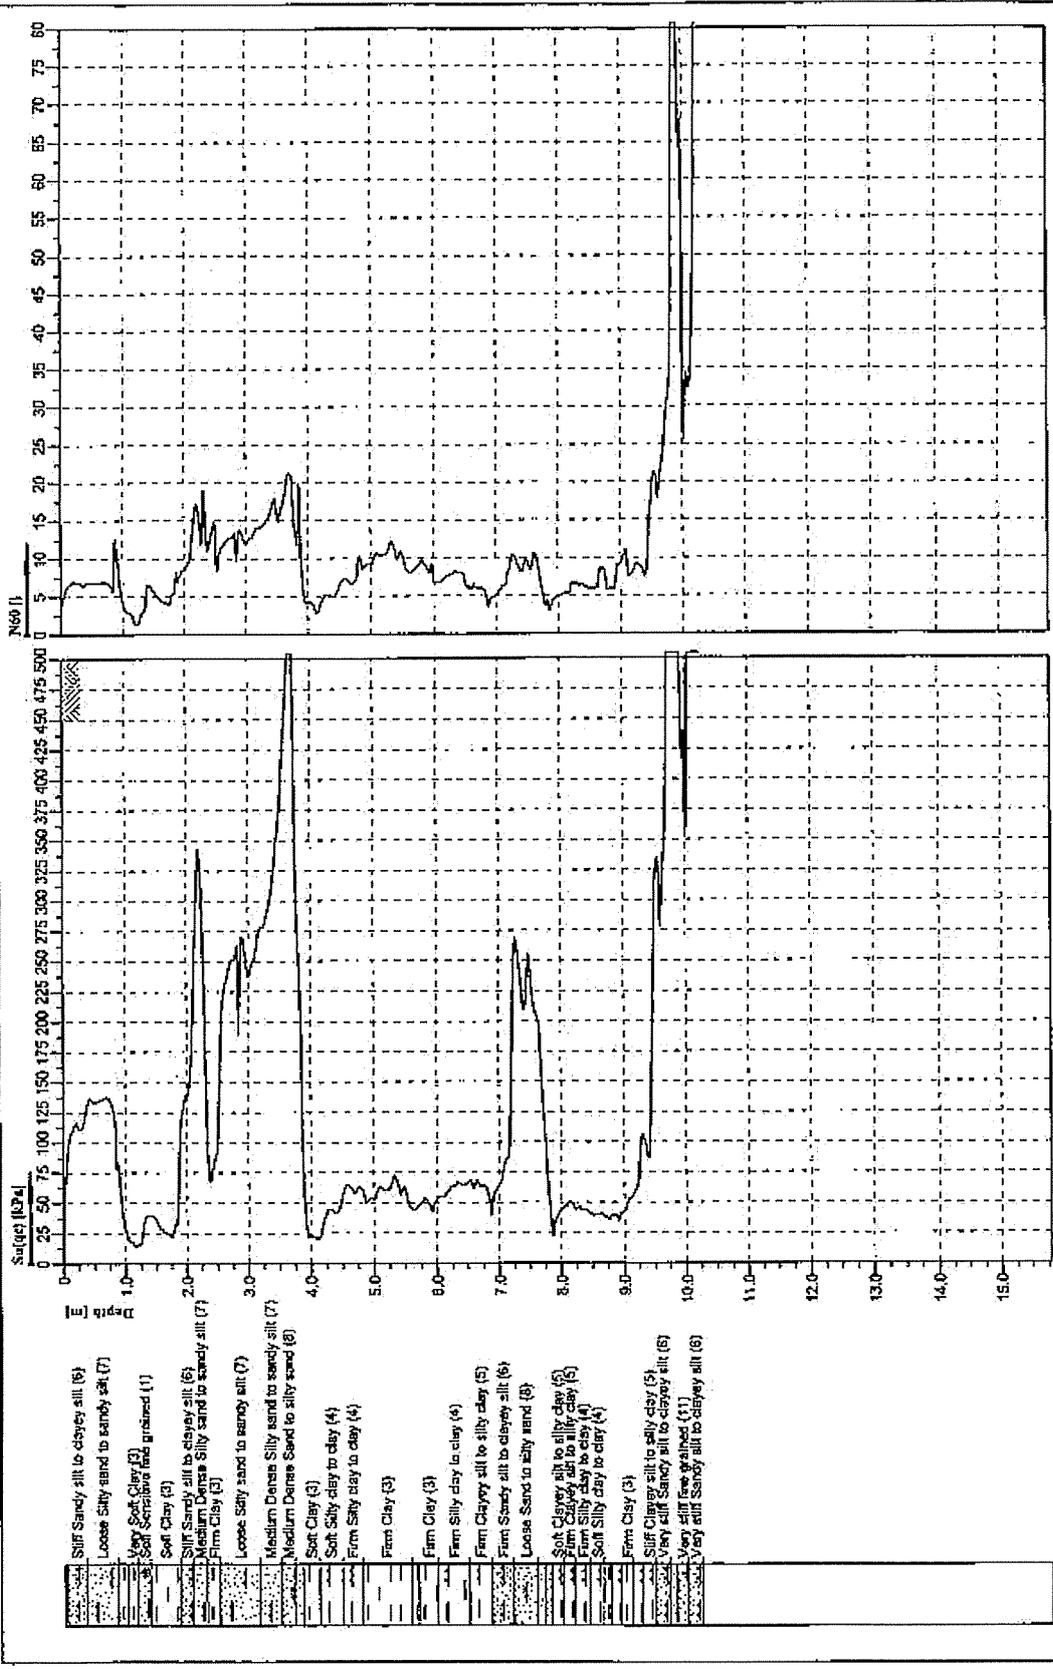


Location:	MANGAWHAI HEADS	Position:	X: 0.00 m, Y: 0.00 m
Project ID:	D1131	Client:	TONKIN & TAYLOR LTD
Project:	MANGAWHAI HEADS SEWER PLANT - 23428.001	Test no:	CPT 4
		Date:	17/05/2008
		Scale:	1:100
		Page:	1/1
		File:	cpt15.001

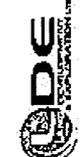


ODE



Scale: 1:100
 To area (mm²): 10
 Sheet area (mm²): 150

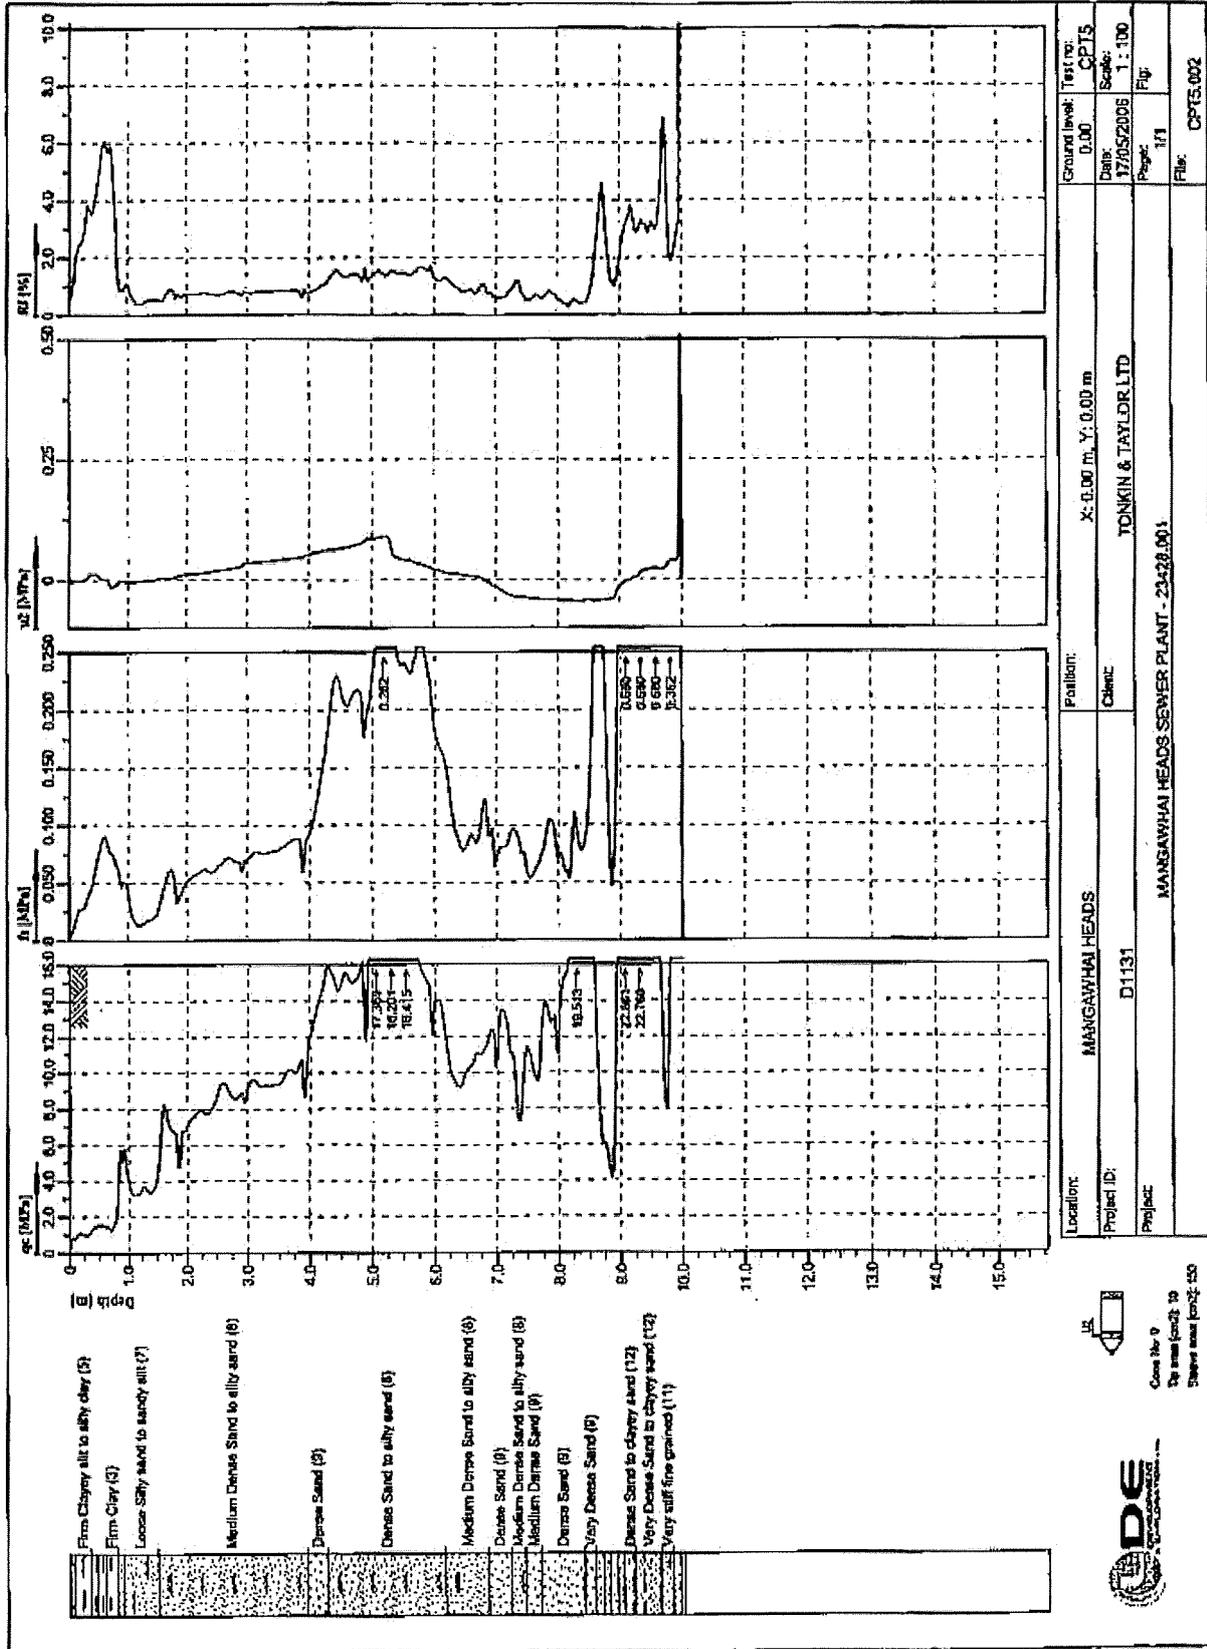

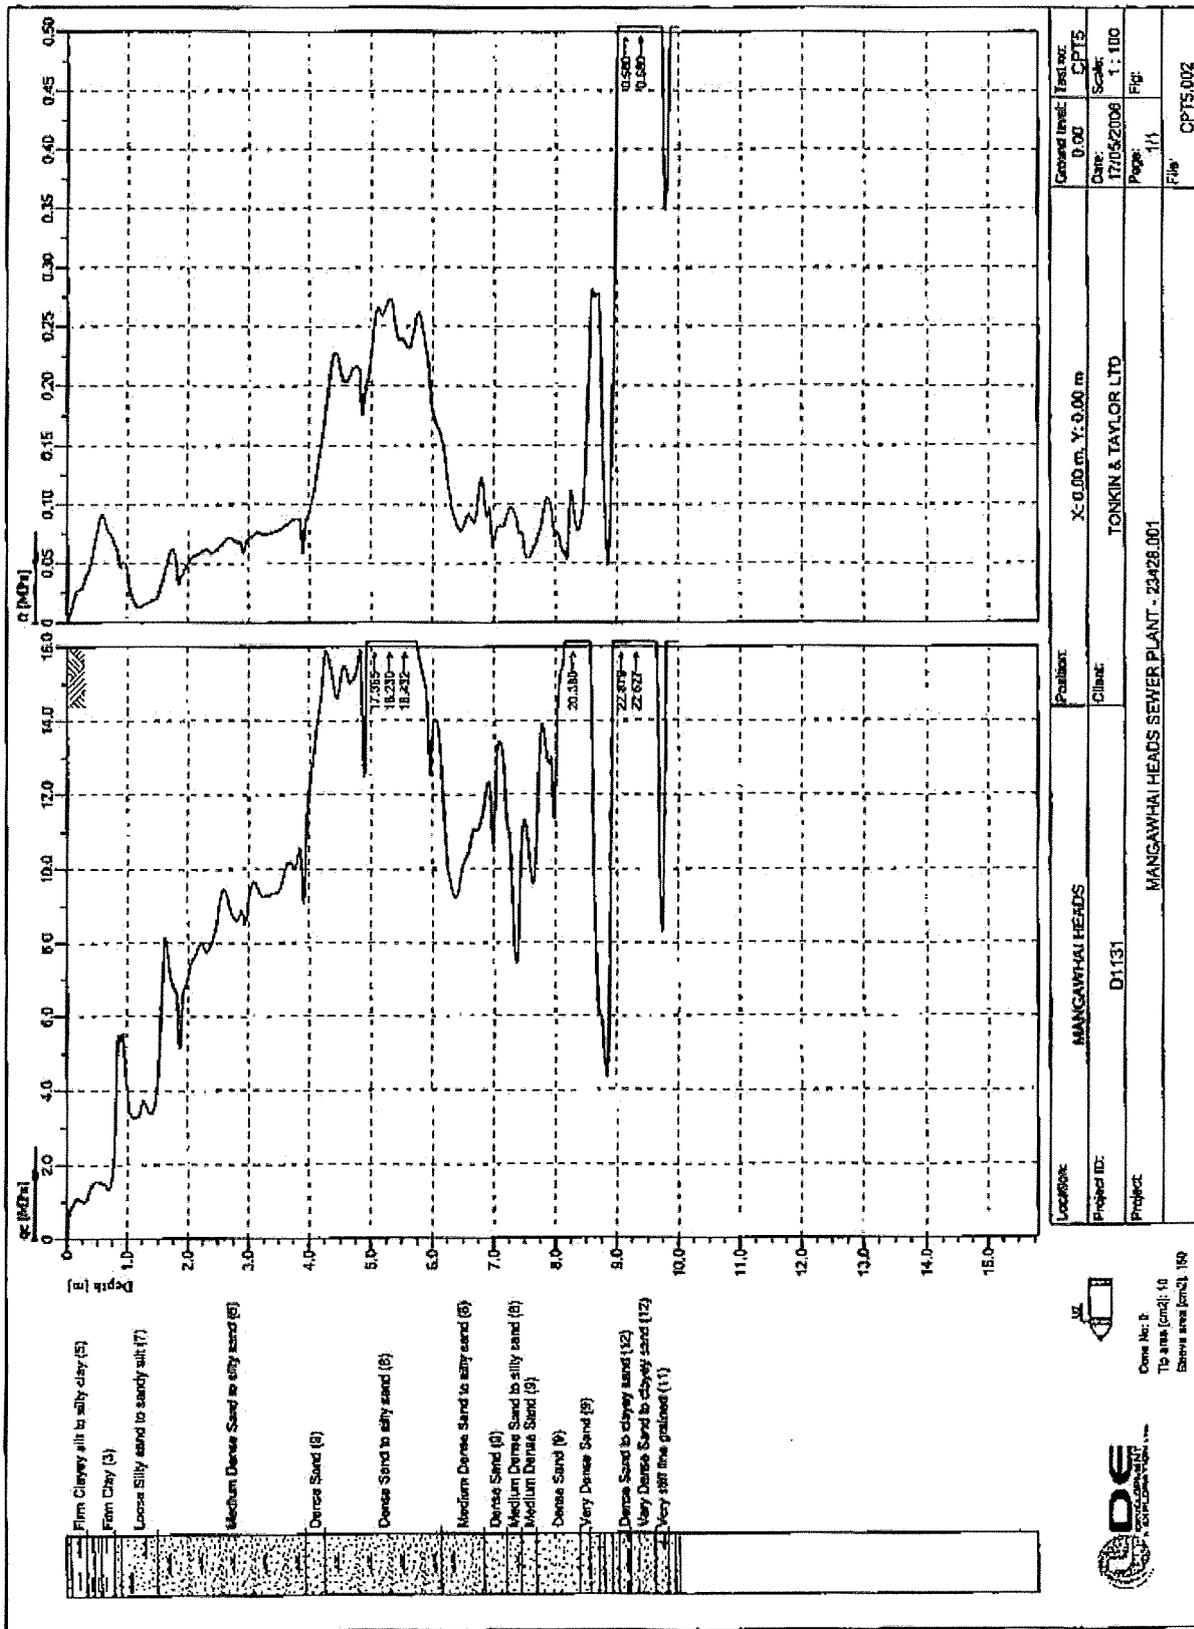

Scale: 1:100
 Date: 17/05/2008
 Page: 1/1
 File: CPT5.002

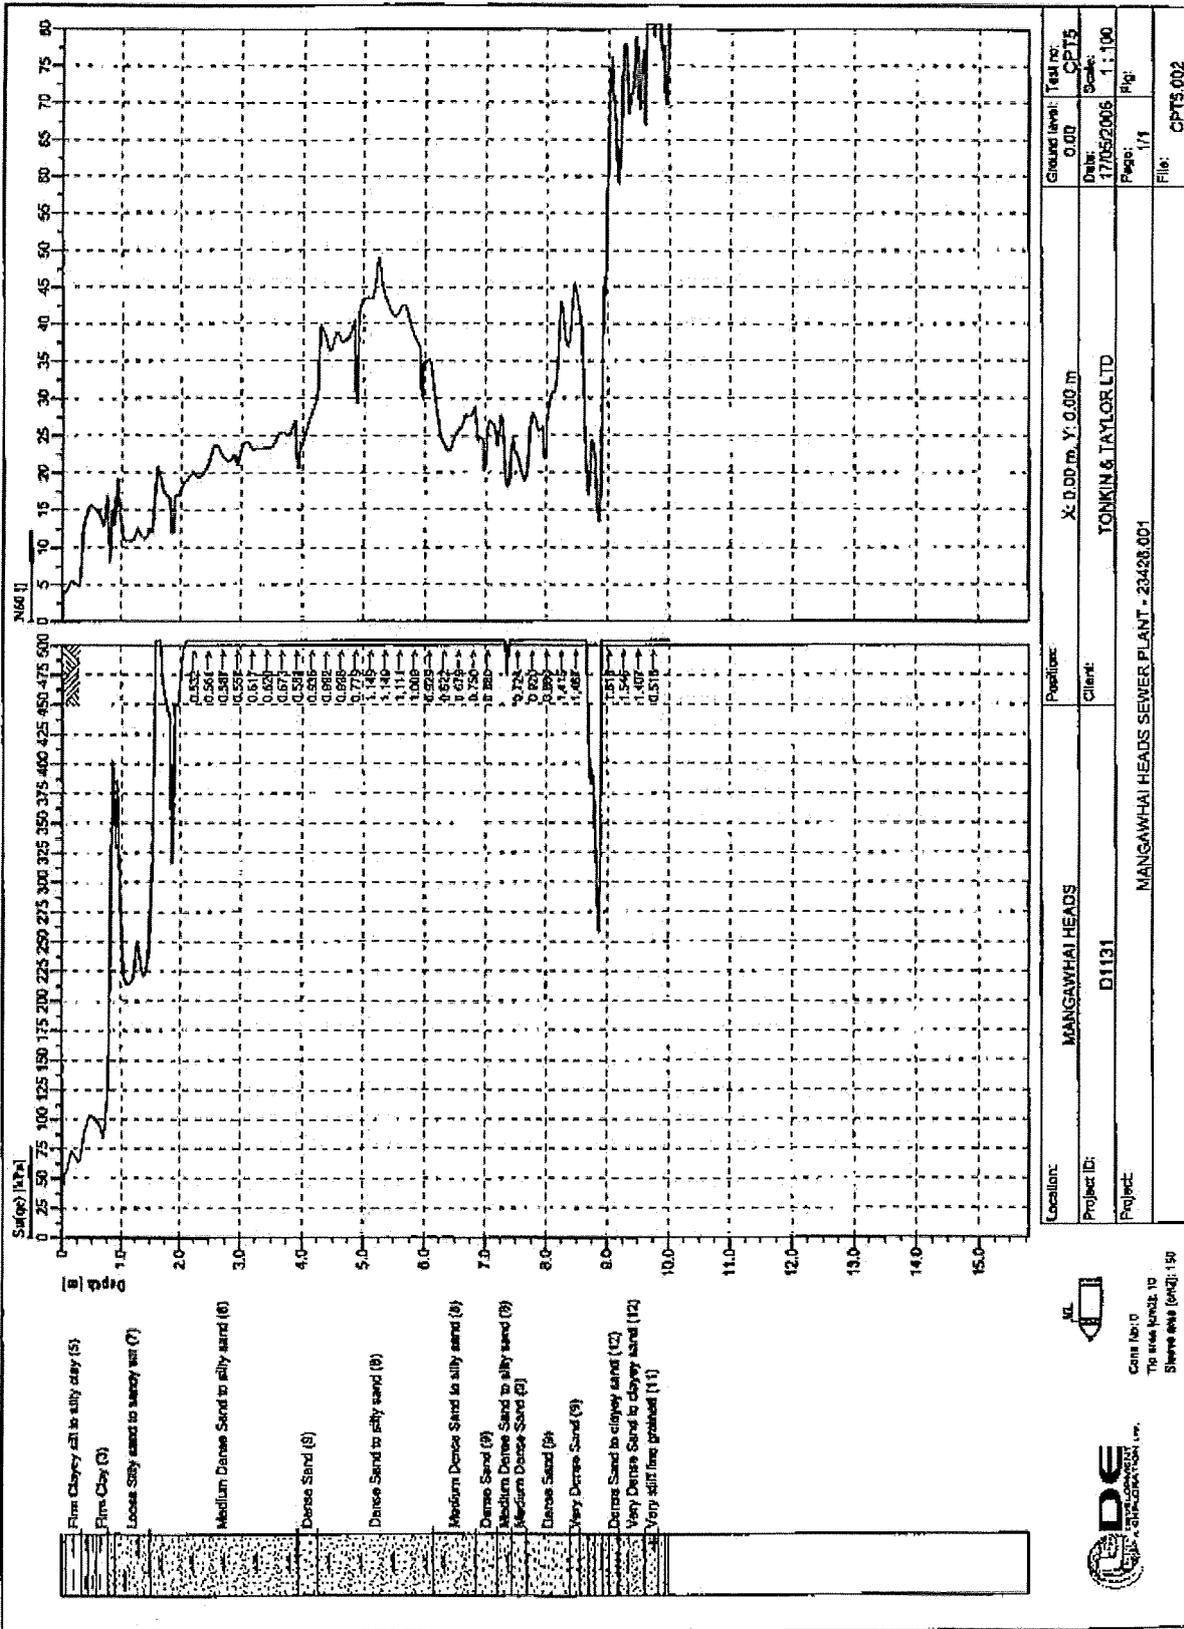

Ground level: Test no:	0.00	CPT5
Date:	17/05/2006	Scale: 1:100
Page:	1/1	File: CPT5.002
Location:	MANGAWHAI HEADS	
Position:	X: 0.00 m, Y: 0.00 m	
Client:	TOKIN & TAYLOR LTD	
Project ID:	D1131	
Project:	MANGAWHAI HEADS SEWER PLANT - 23428-001	

DE


APPENDIX C

NEW CPT LOCATION FOR THE PROPOSED DEVELOPMENTS



CPT 2020/2

CPT 2020/1

CPT 2020/4

CPT 2020/3

Proposed CPTs Location

Proposed New Balance Tanks Location

Thelma Rd

Thelma Rd

46

Appendix E

Structural Calculation



CALCULATIONS

PROJECT No / Ref

1-14129.07 / 00001

OFFICE

Christchurch

PROJECT TITLE

Mangawhai CWWTP Balance Tank Concept Design

SUBJECT

Structural Calculations and Sketches

SHEET No

1 OF 31

ISSUE	TOTAL SHEETS	AUTHOR	DATE	CHECKED BY	DATE	APPROVED BY	DATE	COMMENTS
1	31	J. Gale	29/07/20					
2								
3								
4								
5								

SUPERSEDES DOC No

DATE

DESIGN BASIS STATEMENT (Inc. sources of info/data, assumptions made, standards, etc.)

These are the concept design calculations for the Mangawhai CWWTP Balance Tank, Thelma Road, south-west of Mangawhai Heads. The design includes the dimensions of the tank, the initial rebar details, and the thicknesses of the walls.

The calculations were completed using the following: AS/NZS 1170.0-2002, NZS 1170.5-2004, NZS 3106-2009, and NZS 3101-2006.

Calculation assumed:

Soil Class C

Importance Level 3

Design life of 100 years

For concept design stage, effects of swelling and shrinkage negligible

As tank mostly above ground, earth pressure results negligible

Unit weight of reinforced concrete of 24 kN/m³Unit weight of water of 9.81 kN/m³

Shear wave velocity as 300 m/s (to be confirmed by geotech investigations)

Half tank area used to determine damping ratio

Strength of concrete as 50 MPa

Strength of steel as 500 MPa

Used crack widths using 3101 method

Walls 4-5 assumed to be two-way spanning

Project Manager's Signature

Name	Signature	Date
Project Director's Signature		
Name	Signature	Date

JLATION SHEET

Task/File No: 1-13586.00/

Sheet No 2 of

ect Description: Mangawhai Balance Tank-Concept Design

Office: CHCH

Computed: 20/07/20

Check: / /

Balance tank in Mangawhai Wastewater Treatment Plant
on Thelma Road south west of Mangawhai Heads

As in Whangarei region $z = 0.1$, Soil class C, IL 3,
Design life = 100 yrs (all to be confirmed w/ client)

$$\Rightarrow \text{APE: ULS earthquake} = \frac{1}{2500} \Rightarrow R_u = 1.8$$

$$\text{SLS} = \frac{1}{25} \Rightarrow R_s = 0.25$$

Load case to start with from NZS 3106-2009

SLS (walls): Case 6: -full tank = $G + F_{ep} + F_e + F_{gw} + F_p + (E_{s1} \text{ or } E_{s2})$

Case 2: $G + F_{ep} + F_p + 0.5 F_{sw}$

ULS (walls): Case 10: $1.2G + 1.2F_{ep}$

Case 13: $G + E_u + F_{eb}$

Working with Liquid tightness class 1

Note: As this is only a concept design the following effects will not be included in the assessment:


Swelling (F_{sw}), shrinkage (F_{sh}) $\Rightarrow 0$

Assuming earth pressure forces are negligible $\Rightarrow F_c = 0$
as tank on top of soil. $\Rightarrow F_{gw} = 0$

No prestressing $\Rightarrow F_p = 0$

Currently neglecting baffle walls, only considering outer walls and central dividing wall!

Considering a 1m section of each wall

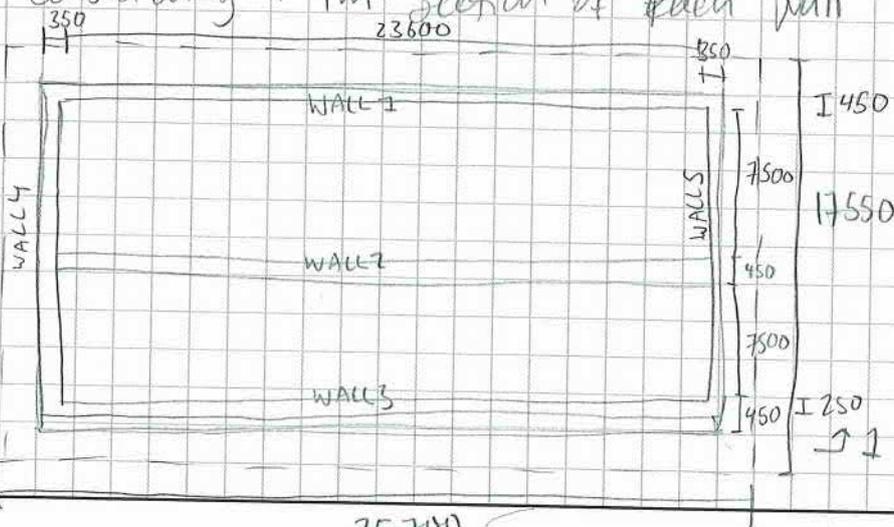

WSP

CALCULATION SHEET

Project/Task/File No: 1-13586.001

Sheet No 3 of


Project Description: Mangawhai Balance Tank - Concept
Design - Loading

Office: CHCH

Computed: 20/07/20

Check: / /

Elevation 1-1

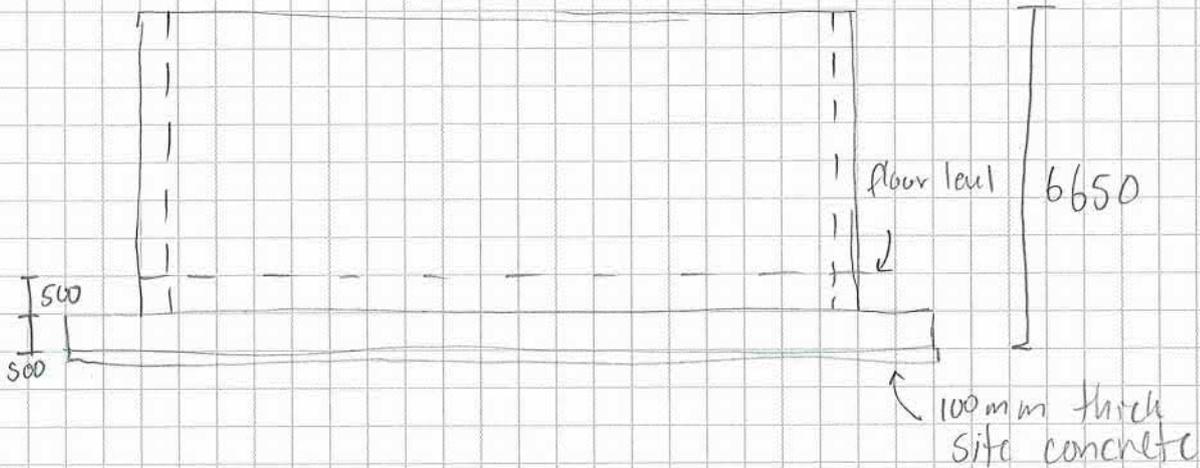

→ Three walls to check, Walls 1 & 2 (450 thick), Wall 3 (tapered) (450 - 250 thick), Wall 4 & 5 (350)

Walls 1 & 3 reinforcing = Horizontal: at centre = HD 20 - 175 w/ 800 lap (FF)
all the way through = HD 16 - 175 EF

Vertical HD 16 - 175 EF + two laps ① HD 25 w/ HD 20 - 150 FF
② HD 16 - 150 NF

Wall 2 = horizontal HD 16 - 175 EF, Vertical w/ lap HD 25 w/ HD 20 - 150 EF

Wall 5 = Horizontal Laps HD 20 & HD 16 - 175 20" top & 16" bottom FF
w/ 800 mm lap
MF = HD 16" - 175

Vertical = HD 16 - 150 EF

Wall 4 = Same as wall 5 but w/ HD 16 traces.

CALCULATION SHEET

Project/Task/File No: 1-1358 b.001

Sheet No 4 of

Project Description: Mangawhai Balance Tank - Concept Design - Loadings

Office: CATCH

Computed: 20/07/20

Check: / /

Dead Loads

Wall 1 & 2 $1m \times 0.45m \times 24kN/m^3 = 10.8kPa$

Wall 3 @ TOP: $0.25m \times 24kN/m^3 = 6kPa$



=> @ BOTTOM: $0.45m \times 24kN/m^3 = 10.8kPa$

Wall 4 & 5 $= 1m \times 0.15m \times 0.35 \times 24kN/m^3 = 8.4kPa$

Liquid pressure $Max = 9.81kN/m^3 \times 6.15m = 60.33kPa$

Earthquake, wall and water

Base shear $C(T_i) = C_h(T_i) Z R_N(T_i, D)$

Ground supported rectangular tank vertical & horizontal $\Rightarrow \Phi_c = 0.1$

$\Rightarrow C_h(T_i) = 2.36, Z = 0.1, R_s = 0.25, R_u = 1.3$

$N(T_i, D) = 1$

$\Rightarrow SLS = 2.36 \times 0.1 \times 0.25 \times 1 = 0.059$

$\Rightarrow ULS = 2.36 \times 0.1 \times 1.3 \times 1 = 0.425$

$C_d(T_i) = C(T_i) \mu_f(M, E_i) S_p$

Shear wave velocity to be confirmed by geotech info.

For horizontal impulsive ULS loads $\mu = 1.25$

For horizontal impulsive SLS loads $\mu = 1$

Vertical impulsive ULS = 1.25

Vertical impulsive SLS = 1

Correction, all = 1

Note to be confirmed by geotech investigation

Assuming shear wave velocity in soil = 300 m/s

= Need H/a where H = tank height, a = radius of circular tank

For rectangular tank find equivalent tank radius w/ same plan area.



CALCULATION SHEET

Project/Task/File No: 1-13586.001

Sheet No 5 of

Project Description: Mangawhai Balance Tank -

Office: CHCH

Concept Design ~ Loading

Computed: 21/07/20

Check: / /

Option ① considering whole tank area = $16.35 \text{ m} \times 24.3 \text{ m}$
= 397.31 m^2

$$A = \pi r^2 \Rightarrow r = \sqrt{\frac{A}{\pi}} \Rightarrow a = \sqrt{\frac{397.31}{\pi}} = 11.25 \text{ m}$$

$$= H/a = 6.65 / 11.25 = 0.59 \approx 0.5$$

\Rightarrow damping ratio % = 18% horizontal impulse
= 10% vertical impulse

Option ② half tank area = 198.66 m^2

$$\Rightarrow a = \sqrt{\frac{198.66}{\pi}} = 7.95 \text{ m}$$

$$\Rightarrow H/a = 6.65 / 7.95 = 0.84 \approx 0.8$$

\Rightarrow damping ratio % = 15% horizontal impulse
= 12% vertical impulse

Both options convection = 0.5%

More conservative to use smaller damping ratio

\Rightarrow use the smallest in each case

\Rightarrow horizontal impulse = 15%

\Rightarrow vertical impulse = 10%

$\Rightarrow k_f(\mu, \xi_i)$

• convection, horizontal & vertical = 1.67

Can I use smallest from each or choose one?

use option 2

CALCULATION SHEET

Project/Task/File No: 1-13586.01 /

Sheet No 6 of

Project Description: Mangawhai Balance Tank -

Office: CHCH

Concept Design - Loading

Computed: 21/07/20

Check: / /

• impulsive horizontal SLS = 0.64

• impulsive horizontal ULS = 0.58

• impulsive vertical SLS = 0.76

• impulsive vertical ULS = 0.67

$c_d(T_i)$

• convective SLS = $0.059 \times 1.67 = 0.099$

• convective ULS = $0.425 \times 1.67 = 0.710$

• impulsive horizontal SLS = $0.059 \times 0.64 = 0.038$

• impulsive horizontal ULS = $0.425 \times 0.58 = 0.247$

• impulsive vertical SLS = $0.059 \times 0.76 = 0.045$

• impulsive vertical ULS = $0.425 \times 0.67 = 0.285$

$V_H = c_d(T_i) W_i$ where W_i = equivalent weight of tank & contents responding in particular mode of vibration considered. (i.e. $T = 0.1$ impulsive)

T_c depends on $\frac{l}{H}$ $l = \frac{1}{2}$ length of rectangular tank in direction being considered

$\Rightarrow l_x = \frac{1}{2} \times 24.3 \text{ m} = 12.15 \text{ m} \quad \Rightarrow \frac{l_x}{H} = \frac{12.15}{6.65} = 1.83$

$\Rightarrow l_y = \frac{1}{2} \times 16.35 \text{ m} = 8.18 \text{ m} \quad \Rightarrow \frac{l_y}{H} = \frac{8.18}{6.65} = 1.23$

$\sqrt{\frac{g}{l_x}} = \sqrt{\frac{9.81}{12.15}} = 0.899 \quad \sqrt{\frac{g}{l_y}} = \sqrt{\frac{9.81}{8.18}} = 1.095$

$\Rightarrow T_{cx} = \frac{6}{0.899} = 6.67$

$\Rightarrow T_{cy} = \frac{5.5}{1.095} = 5.02$

does this T_c get used for determination of $c(T_i)$ at the beginning?
 \Rightarrow do I need to update?
 yes

CALCULATION SHEET

Project/Task/File No: 1-13586.01/

Sheet No 7 of

Project Description: Mangawhai Balance Tank - Concept Design - Loading.

Office: CHCH

Computed: 21/07/20

Check: / /

$$\frac{W}{H} = 1.83$$

$$\frac{W}{H} = 1.23$$

W_L = weight of liquid.
to be conservative assume whole tank? (kN)

$$\Rightarrow \frac{W_i}{W_L} = 0.33$$

$$W_L = 9.81 \text{ kN/m}^3 \times 397.3 \text{ m}^2 \times 6.65 \text{ m} = 25.92 \text{ kN}$$

$$\Rightarrow W_i = 8.55 \text{ kN}$$

$$\frac{h_i}{H} = 0.39 \Rightarrow h_i = 2.59 \text{ m}$$

$$\frac{h_c}{H} = 0.54 \Rightarrow h_c = 3.59 \text{ m}$$

$$\frac{W_c}{W_L} = 0.68 \Rightarrow W_c = 17.63 \text{ kN}$$

↑ x direction
↓ y direction

$$\frac{h_i}{H} = 0.39 \Rightarrow h_i = 2.59 \text{ m}$$

$$\frac{W_i}{W_L} = 0.45 \Rightarrow W_i = 11.66 \text{ kN}$$


$$\frac{W_c}{W_L} = 0.54 \Rightarrow W_c = 14.00 \text{ kN}$$

$$\frac{h_c}{H} = 0.57 \Rightarrow h_c = 3.79 \text{ m}$$

$\frac{V}{H}$

From this point on decided to move to a spreadsheet to enable me to keep track of the numbers easier.

$$y = \left[\frac{y_2 - y_1}{x_2 - x_1} \right] [x - x_1] + y_1$$

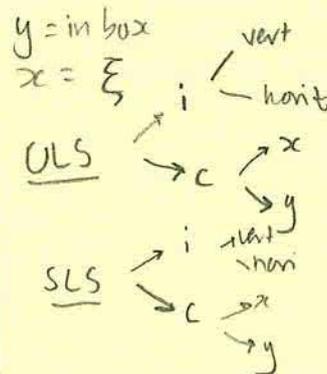

Project Title	Mangawhai CWWTP Balance Tank Concept Design
Project Number	1-14129.07 / 00001
Location	Neer Mangawhai Heads, Whangarei
Author	Jess Gale

Earthquake Elastic Site Spectra, C(T)			
Hazard Factor	Z	0.1	
Soil Class		C	
IL		3	
Design Life		100	years
APE (ULS)		1/2500	
APE (SLS)		1/25	
Return period factor (ULS)	R_u	1.8	
Return period factor (SLS)	R_s	0.25	
Near Fault Factor	$N(T,D)$	1	
Impulsive period	T_i	0.1	
$T_v \sqrt{g/l_x}$ (Figure A3)		6	
$T_c \sqrt{g/l_y}$ (Figure A3)		5.5	
Convective period, x-direction	$T_{c,x}$	6.68	$=T_c \sqrt{g_{div_lx}} / (\text{SQRT}(g/l_x))$
Convective period, y-direction	$T_{c,y}$	5.02	$=T_c \sqrt{g_{div_ly}} / (\text{SQRT}(g/l_y))$
Spectral Shape Factor, impulsive	$C_h(T_i)$	2.36	
convective, x-direction	$C_h(T_{c,x})$	0.09	$=3.96 / (\text{Convective_period}_x^2)$
convective, y-direction	$C_h(T_{c,y})$	0.16	$=3.96 / (\text{convective_period}_y^2)$
Earthquake Elastic Site Spectra (ULS)	$C(T_i)_{ULS}$	0.425	$=Ch_Ti * Z * Ru * N_T_D$
	$C(T_{c,x})_{ULS}$	0.016	$=Ch_Tc_x * Z * Ru * N_T_D$
	$C(T_{c,y})_{ULS}$	0.028	$=Ch_Tc_y * Z * Ru * N_T_D$
Earthquake Elastic Site Spectra (SLS)	$C(T_i)_{SLS}$	0.059	$=Ch_Ti * Z * Rs * N_T_D$
	$C(T_{c,x})_{SLS}$	0.002	$=Ch_Tc_x * Z * Rs * N_T_D$
	$C(T_{c,y})_{SLS}$	0.004	$=Ch_Tc_y * Z * Rs * N_T_D$

Horizontal Design Action Coefficient, $C_d(T)$	
Structural Performance Factor	S_p
Ductility Factor	$\mu_{SUS,i}$ $\mu_{SUS,i}$ μ_c
Soil shear wave velocity	300 m/s
Equivalent radius of circular tank	a
Height to radius ratio	H/a
Damping ratio %	$\xi_{i, horiz}$ $\xi_{i, vert}$ ξ_c
Correction Factor	$k_f(\mu_c, \xi_c)$ $k_f(\mu_i, ULS, \xi_{i, horiz})$ $k_f(\mu_i, ULS, \xi_{i, vert})$ $k_f(\mu_i, SLS, \xi_{i, horiz})$ $k_f(\mu_i, SLS, \xi_{i, vert})$
Horizontal Design Action Coefficient, ULS	$C_d(T_{i, horiz})$ $C_d(T_{i, vert})$ $C_d(T_{c,x})$ $C_d(T_{c,y})$ $C_d(T_{i, horiz})$ $C_d(T_{i, vert})$ $C_d(T_{c,x})$ $C_d(T_{c,y})$
$=C(T)*k_f(\mu, \xi)*S_p$	$=SQRT(area_int/Pi())$
Horizontal Design Action Coefficient, SLS	

$\xi, \mu=1.25$	10	15	20
k_f	0.67	0.58	0.52
	0.76	0.64	0.56

Equivalent Hydrodynamic Weights and centers of gravity			
Total weight of liquid (half tank) From Figure A4	W_L	4341 kN	
x direction	W_{cx}/W_L	0.73	W_{cx}
	h_{cx}/H	0.53	h_{cx}
	h_{ix}/H	0.38	h_{ix}
	W_{ix}/W_L	0.26	W_{ix}
	W_{cy}/W_L	0.62	W_{cy}
	h_{cy}/H	0.55	h_{cy}
	h_{iy}/H	0.37	h_{iy}
	W_{iy}/W_L	0.36	W_{iy}
y direction			

Base Shear, V_H			
UIS			
$V_{H,i, \text{horiz}, x}$	35.54 kN	W_{tcx}	49.86 kPa
$V_{H,i, \text{vert}, x}$	40.53 kN	W_{bcx}	34.65 kPa
$V_{H,i, \text{horiz}, y}$	15.64 kN	W_{tix}	4.21 kPa
$V_{H,i, \text{vert}, y}$	17.83 kN	W_{bix}	25.88 kPa
$V_{H,c, x}$	11.28 kN	W_{tcy}	14.83 kPa
$V_{H,c, y}$	5.39 kN	W_{bcy}	7.98 kPa
SLS		W_{tiy}	1.46 kPa
$V_{H,i, \text{horiz}, x}$	5.40 kN	W_{biy}	11.79 kPa
$V_{H,i, \text{vert}, x}$	6.32 kN		
$V_{H,i, \text{horiz}, y}$	2.38 kN		
$V_{H,i, \text{vert}, y}$	2.78 kN		
$V_{H,c, x}$	1.57 kN		
$V_{H,c, y}$	0.75 kN		

Tank Dimensions		
Height of liquid	H	5 m
Tank length	in x	24.3 m
	in y	16.35 m
Half tank length, l	in x	12.15 m
	in y	8.175 m
Internal Tank length for one section	in x	23.6 m
	in y	7.5 m
Tank Ratios	l_x/H	2.43
	l_y/H	1.635
Tank internal area	one section	177 m ²
Wall Thickness		
Wall 1 & 2		0.45 m
Wall 3 (max)		0.45 m
Wall 3 (min)		0.25 m
Wall 4 & 5		0.35 m
Height to c.o.g. of wall		2.5 m
Material Unit Weights		
Gravity force	g	9.81 kN/m ³
Weight of water		9.81 kN/m ³
Weight of RC		24 kN/m ³

$$\text{Horizontal seismic shear, } V_H = \text{SQRT}(((C_d \cdot T_i \cdot \text{horiz} * (W_{ix} + W_{w_1_2}))^2) + ((C_d \cdot T_c \cdot x * W_{cx})^2))$$

W_w	Walls 1, 2 & 3	Wall 4 & 5
Tank wall weight (per m section)	54	42 kN/m
ULS		
$V_{H, \text{horiz, x}}$	49.60	46.84 kN/m
$V_{H, \text{vert, x}}$	56.22	53.05 kN/m
$V_{H, \text{horiz, y}}$	28.90	26.12 kN/m
$V_{H, \text{vert, y}}$	32.82	29.64 kN/m
SLS		
$V_{H, \text{horiz, x}}$	7.50	7.08 kN/m
$V_{H, \text{vert, x}}$	8.73	8.24 kN/m
$V_{H, \text{horiz, y}}$	4.38	3.95 kN/m
$V_{H, \text{vert, y}}$	5.11	4.61 kN/m

$$\text{Overturning Moment above floor slab, } M_w = \text{SQRT}(((C_d \cdot T_i \cdot \text{horiz} * ((W_{ix} * h_{ix}) + (L47 * M18)))^2) + ((C_d \cdot T_c \cdot x * W_{cx} * h_{cx})^2))$$

W_w	Walls 1, 2 & 3	Wall 4 & 5
Tank wall weight (per m section)	54	42 kN
ULS		
$M_{w, \text{horiz, x}}$	103.81	97.05 kNm/m
$M_{w, \text{vert, x}}$	117.24	109.45 kNm/m
$M_{w, \text{horiz, y}}$	62.60	55.74 kNm/m
$M_{w, \text{vert, y}}$	70.91	63.04 kNm/m
SLS		
$M_{w, \text{horiz, x}}$	15.66	14.62 kNm/m
$M_{w, \text{vert, x}}$	18.16	16.94 kNm/m
$M_{w, \text{horiz, y}}$	9.46	8.42 kNm/m
$M_{w, \text{vert, y}}$	18.34	17.63 kNm/m

ULS

Sheet 13

Date 27/07/20

Load Case 10	1.2G + 1.2 F _{lp}
Note: no horizontal gravity force so no need to consider	
Max pressure at bottom	49.05 kPa
Shear	122.63 kN/m
Moment	204.38 kNm/m
With loading factor	
Shear	147.15 kN/m
Moment	245.25 kNm/m

Load Case 6 - Full Tank		G + F _{lp} + E _{s1}	
Liquid Pressure			
Shear	122.63 kN/m		
Moment	204.38 kNm/m		
Earthquake			
Part 1 - Horizontal only			
X-direction			
	Walls 1, 2 & 3	Wall 4 & 5	
Shear	7.50	7.08 kN/m	
Moment	15.66	14.62 kNm/m	
y-direction			
Shear	4.38	3.95 kN/m	
Moment	9.46	8.42 kNm/m	
Part 2			
alpha	0.9	Cv(Tex)	0.00
Cv(Ti)	0.05	Cv(Tey)	0.00
Impulsive		Convective x direction	
Shear	6.51	Shear	0.05 kN/m
Moment	10.85	Moment	0.09 kNm/m
Convective y direction			
Shear	0.17 kN/m		
Moment	0.29 kNm/m		
Combo			
X-direction		y direction	
Shear	6.51	Shear	6.51 kN/m
Moment	10.85	Moment	10.86 kNm/m
Eu			
x direction			
	Walls 1, 2 & 3	Wall 4 & 5	
shear	10	10 kN/m	
moment	19	18 kNm/m	
y direction			
	Walls 1, 2 & 3	Wall 4 & 5	
shear	8	8 kN/m	
moment	14	14 kNm/m	
Total			
x direction			
	Walls 1, 2 & 3	Wall 4 & 5	
shear	133	132 kN/m	
moment	223	223 kNm/m	
y direction			
	Walls 1, 2 & 3	Wall 4 & 5	
shear	130	130 kN/m	
moment	219	218 kNm/m	

SLS

Sheet 16

Date 27/07/20

Load Case 2		G + F _{lp}
Liquid Pressure		
Shear	122.63 kN/m	
Moment	204.38 kNm/m	

CALCULATION SHEET

Project/Task/File No: I-13586.001

Sheet No 17 of

Project Description: Mangaohai Balance tank -
Concept Design - Final loading demands.

Office: CHCA

Computed: 27/07/20

Check: / /

Final loading from s/s

Note: Assume wall 3 not tapered.

ULS

Governing load case = 13 G + E_u + F_{ep}

Walls 7, 2 & 3: x-direction Shear = 191 kN Moment = 334 kNm

y-direction Shear = 176 kN Moment = 304 kNm

Walls 4 & 5: x-direction Shear = 189 kN Moment = 329 kNm

y-direction Shear = 176 kN Moment = 300 kNm

SLS


Governing load case = 6 G + F_{ep} + E_{s2}

Walls 1, 2 & 3: x-direction Shear = 133 kN M = 223 kNm

y-direction V = 132 kN M = 223 kNm

Walls 4 & 5: x Shear = 130 kN M = 219 kNm
y V = 130 kN M = 218 kNm

Serviceability check - crack widths

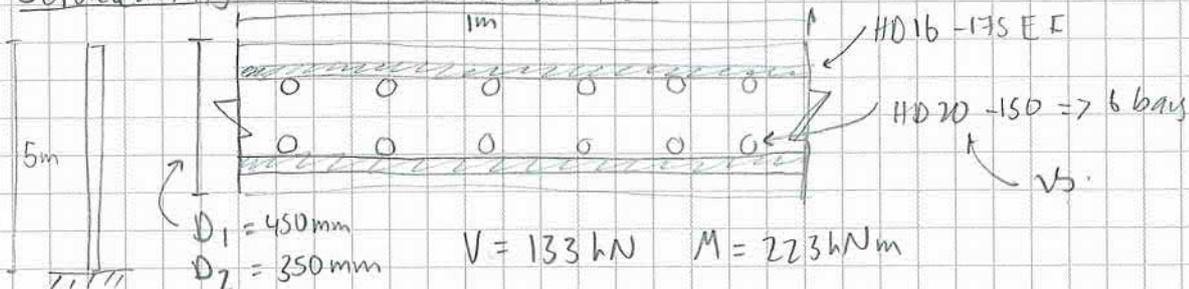

$$j_p = \frac{A_s}{A_{c,eff}} \quad A_s = 6 \times \pi \frac{d^2}{4} = 6 \times \pi \times \frac{(20\text{mm})^2}{4} = 1,885 \text{ mm}^2$$

$$A_{c,eff} = \alpha_2 \times l \quad \text{when } \alpha_2 = 0.50 \text{ but not greater than } 250 \text{ mm}$$

$$\Rightarrow \alpha_{2,w1} = 225 \text{ mm} \quad \alpha_{2,w2} = 175 \text{ mm}$$

$$\Rightarrow A_{c,eff,w1} = 225 \text{ mm} \times 1000 \text{ mm} = 225,000 \text{ mm}^2$$

$$A_{c,eff,w2} = 175 \times 1000 = 175,000 \text{ mm}^2$$



CALCULATION SHEET

Project/Task/File No: 1-13586.00/
Project Description: Mangawhai Balance Tank
- Concept design - Serviceability

Sheet No 18 of
Office: CHCH
Computed: 27/07/20
Check: / /

$$P_{pw1} = \frac{21885}{225,000} = 0.0084$$

$$P_{pmin} = \frac{f_{ct.3}}{f_y}$$

$$\rightarrow f'_{ct} = 50 \text{ MPa}$$

$$P_{pw2} = \frac{1885}{175,000} = 0.011$$

$$\Rightarrow \text{Table CS.2.3 } f_{ct.3} = 2.44 \text{ MPa}$$

$$f_y = 500 \text{ MPa}$$

$$\Rightarrow P_{pmin} = \frac{2.44}{500} = 0.0049 \quad \checkmark$$

$$b = 1000 \text{ mm}$$

depth of steel =

$$\textcircled{1} 450 - 50 - 16 - 10 = 374 \text{ mm}$$

$$\textcircled{2} 350 - " - " = 274 \text{ mm}$$

$$\begin{aligned} \sigma_{ct} &= 3320 \sqrt{f'_{ct}} + 6900 \\ &= 3320 \sqrt{50} + 6900 \\ &= 30,376 \text{ MPa} \end{aligned}$$

cl 5.2.3 NZS 3101

$$E_s = 200,000 \text{ MPa}$$

$$n = \frac{200,000}{30,376} = 6.58$$

$$p_1 = 0.0084 \quad p_2 = 0.011$$

$$p_1 n = 0.0084 \times 6.58 = 0.055$$

$$p_2 n = 0.011 \times 6.58 = 0.072$$

$$k_1 = \sqrt{p_1 n^2 + 2 p_1 n} - p_1 n$$

$$= \sqrt{(0.055)^2 + 2(0.055)} - 0.055 = 0.058$$

$$k_2 = \sqrt{(0.072)^2 + 2(0.072)} - 0.072 = 0.314$$

$$k_1 d_1 = 374 \text{ mm} \times 0.058 = 21.7 \text{ mm}$$

$$k_2 d_2 = 274 \times 0.314 = 86.0 \text{ mm}$$

WSP

CALCULATION SHEET

Project/Task/File No: 1-13586.00/

Sheet No 10 of

Project Description: Mangawhai Balance Tank
- Concept Design - Serviceability.

Office: CHCH

Computed: 27/07/20

Check: / /

$$j_1 = 1 - \frac{k}{3} = 1 - \frac{0.058}{3} = 0.981$$

$$j_2 = 1 - \frac{0.314}{3} = 0.895$$

$$f_{s1} = \frac{M}{A_s j_1 d} = \frac{223 \text{ kNm}}{1885 \text{ mm}^2 \times 0.981 \times 374} \times 10^6$$

$$= 322 \text{ MPa}$$

$$f_{s2} = \frac{223 \text{ kNm}}{1885 \times 0.895 \times 274} = 482.41 \text{ MPa}$$

Try with 25mm bars, using s/s, Note E_c is calculated using an updated equation
for f_{s1} $E_c = 4700 + \sqrt{f'_c} \times \left(\frac{P}{2300}\right)^{1.5}$

$$f_{s1} = 205 \text{ MPa} \quad \checkmark \checkmark$$

$\Rightarrow E_c$ slightly different to using other eq.

\Rightarrow need to model walls 4x5 for two way spanning.

\Rightarrow Need to make plot graph for model / reading off tables.

check crack widths using 3101 method

Walls 1-3 25mm bars, 450 thick, cover = 50 + 16mm = 66mm
spacing = 150mm 50MPa concrete, $b = 1000\text{mm}$, $M^*_{SLS} = 223 \text{ kNm}$

Limit: using 3106

$$h_d / E = 5\text{m} / 0.45\text{m} = 11.11 \Rightarrow w_k \leq 0.2 \text{ mm}$$

Limit: Using 3101, Load category: III

Exposure classification = B1 or B2

$\Rightarrow 0.3 \text{ mm}$ limit?

AT? A2 B1 B2, CU

Working with 0.2 mm limit.

Using 3101 s/s $w = 0.284 \text{ mm} > 0.2 \Rightarrow$ Not OK

Try @ 100 spacing $w = 0.168 \text{ mm} < 0.2 \Rightarrow$ OK

\Rightarrow starts at the bottom = 4025@100 c/c spacing



	CALCULATIONS	PROJECT No / Ref 1-14129.07 / 00001
	OFFICE Christchurch	PROJECT TITLE Mangawhai CWWTP Balance Tank Concept Design Walls 1-3
SUBJECT SLS Crack Control - Walls 1-3		SHEET No 1 OF 1

Calculations to NZS3101 Cl. 2.4.4.6 Assessment of surface crack widths

Limit	=	0.2	mm	Specified crack width limit	AS/NZS 3101	Table C2.1
Thickness	=	450	mm	Overall thickness of concrete		
Cover	=	66	mm	Cover to main steel		
Bar	=	25	mm diam	Main steel diameter		
Spacing	=	100	mm	Main steel spacing		
F'c	=	50	Mpa	Concrete strength		
ρ	=	2450	kg/m ³	Concrete density	AS/NZS 3101	Cl. 5.2.2
Ec	=	37	Gpa	Concrete Modulus of Elasticity	AS/NZS 3101	Eq. 5-1
Es	=	200	Gpa	Steel Modulus of Elasticity	AS/NZS 3101	Cl. 5.3.4
b	=	1000	mm	Width of section		
M* _{SLS}	=	225	kNm	SLS moment demand		

Follows the example provided by SCNZ for "Durability of Composite Decks Exposed to Surface Water" dated 7 Nov. 2008
Available Here: https://www.scnz.org/site/scnz/images/advisor_doc/CMP1003.pdf

d	=		371.5	mm	Distance to centroid main steel	
n	=	$\frac{E_s}{E_c}$	5.47		Standard flexural theory	
A _s	=		4909		Area of steel	
ρ	=	$\frac{A_s}{bd}$	0.0132		Reinforcement ratio	
pn	=	ρ × n	0.0723			
k	=	$\sqrt{\rho n^2 + 2\rho n} - \rho n$	0.315			
kd	=	k × d	117.0	mm	Depth of Neutral Axis	
j	=	$1 - \frac{k}{3}$	0.895			
f _s	=	$\frac{M^*}{A_s j d}$	138	Mpa		
β'	=	$\frac{y - kd}{d - kd}$	1.31			AS/NZS 3101 Eq. 2-8
g _s	=	$\sqrt{\left(\frac{s}{2}\right)^2 + C_m^2}$	93	mm		AS/NZS 3101 Eq. 2-9
w	=	$2\beta' \frac{f_s}{g_s} E_s$	0.168	mm		AS/NZS 3101 Eq. 2-7

Overall OK

CALCULATION SHEET

Project/Task/File No: 1-13586-001

Sheet No 21 of

Project Description: Manga whai Balanu Tauh
- concept Design - Serviceability

Office: CHCH






Computed: 27/07/20

Check: / /

Walls 4x5 - Two-way spanning

Using data from 'Moment & Reaction for Rectangular Plates'
→ sheets used attached.

→ Estimate pressures of load case 6 = $G + F_{ep} + E_s$, $G=0$

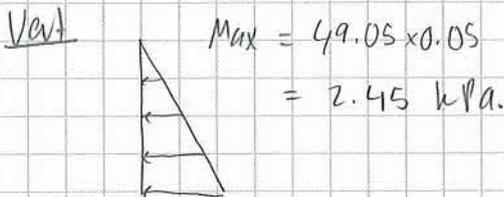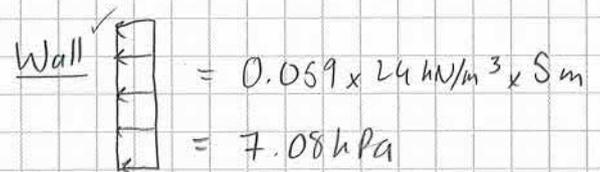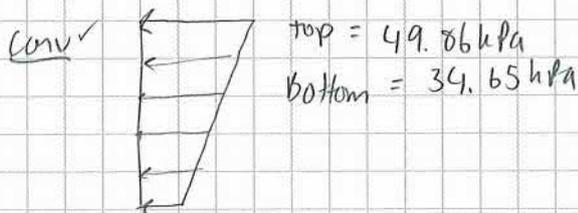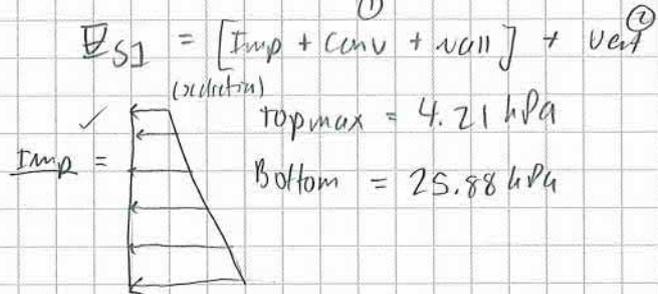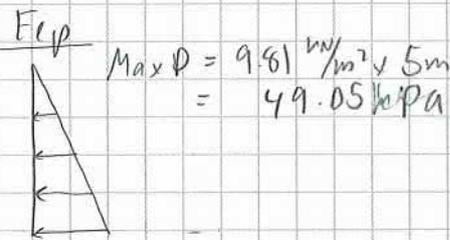

⇒ Part 1

$$TOP = \sqrt{[0.24 \times (4.21 \text{ kPa} + 7.08 \text{ kPa})]^2 + [0.03 \times 49.96 \text{ kPa}]^2}$$

$$= 3.095 \text{ kPa}$$

Bottom = 7.978 kPa

⇒ Part 1 x 2



Top = 3.095 kPa

Bottom = $\sqrt{7.978 \text{ kPa}^2 + 2.45 \text{ kPa}^2} = 8.346 \text{ kPa}$

Total

Top = 3.095 kPa
= 3.10 kPa

Bottom = 8.346 kPa + 49.05 kPa = 57.40 kPa

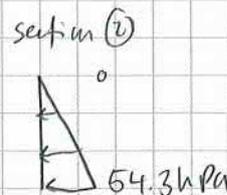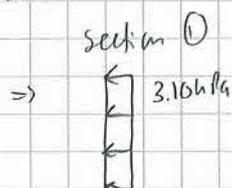

WSP

CALCULATION SHEET

Project/Task/File No: 1-13586-001

Sheet No 22 of

Project Description: Manga whai Balance Tank
- concept design - two way spanning walls

Office: CHCH

Computed: 27/07/20

Check: / /

Section 1

$$a/b = 7.5/5 = 0.75 \quad y/b = 0 \quad z/a = 1$$

$$M_{\text{ox}} = 3.10 \text{ kPa} \times 0.0242 \times 5 \text{ m}^2 = 17.88 \text{ kNm}$$

$$M_{\text{oy}} = 3.10 \times 0.1212 \times 5 \text{ m}^2 = 9.39 \text{ kNm}$$

Section 2

$$M_{\text{ox}} = 54.3 \times 0.0117 \times 5^2 = 15.88 \text{ kNm}$$

$$M_{\text{oy}} = 54.3 \times 0.0584 \times 5^2 = 79.28 \text{ kNm}$$

$$\Rightarrow \text{Total } M_{\text{ox}} = 17.76 \text{ kNm}$$

$$M_{\text{oy}} = 88.67 \text{ kNm}$$

\Rightarrow Now try in 3101 crack width s/s to check steel stress (vertical steel)

$$f_s = 169 \text{ MPa} < 240 \text{ MPa} \quad \checkmark \checkmark$$

\Rightarrow try HD20 @ 150 spacing for crack widths w/ 0.2mm limit

$$w = 0.247 \text{ mm} > 0.2 \text{ mm} \quad \text{Not OK}$$

try HD20 @ 100 spacing

$$w = 0.145 \text{ mm} \quad \checkmark \checkmark \text{ OK}$$

\Rightarrow HD20 @ 100 spacing


\rightarrow Now as two way spanning - check horizontal steel - HD16 @ 175 c/c

$$\text{Cover} = 50 \text{ mm}, \quad M = 17.76 \text{ kNm} \quad w = 0.074 \text{ mm} \quad \checkmark \checkmark \text{ OK}$$

$\frac{wl^2}{8}$

MOMENTS AND REACTIONS FOR RECTANGULAR PLATES

	y/b	x/a	M_x horiz steel							M_y vert steel						
			0	0.2	0.4	0.6	0.8	1.0	0	0.2	0.4	0.6	0.8	1.0		
$a/b = 1/8$	1.0	+ .0082	+ .0004	+ .0002	+ .0000	- .0001	- .0002	- .0002	0	0	0	0	0	0	0	
	0.8	+ .0251	+ .0011	+ .0005	+ .0000	- .0003	- .0005	- .0005	+ .0002	+ .0001	+ .0000	- .0000	- .0001	- .0001	- .0001	
	0.6	+ .0496	+ .0021	+ .0009	+ .0001	- .0006	- .0009	- .0011	+ .0004	+ .0002	+ .0000	- .0001	- .0002	- .0002	- .0002	
	0.4	+ .0751	+ .0031	+ .0014	+ .0001	- .0008	- .0014	- .0016	+ .0006	+ .0003	+ .0000	- .0002	- .0003	- .0003	- .0003	
	0.2	+ .0942	+ .0038	+ .0016	+ .0000	- .0010	- .0017	- .0019	+ .0008	+ .0003	- .0000	- .0003	- .0005	- .0005	- .0005	
	0	+ .0460	0	+ .0001	+ .0003	+ .0005	+ .0006	+ .0006	0	+ .0005	+ .0014	+ .0023	+ .0028	+ .0030	+ .0030	
	R_x	R_y	+ .0460	+ .0136	+ .0543	+ .0839	+ .1004	+ .1056								
$a/b = 1/4$	1.0	+ .0147	+ .0022	+ .0012	+ .0002	- .0006	- .0012	- .0014	0	0	0	0	0	0	0	
	0.8	+ .0523	+ .0046	+ .0022	+ .0002	- .0012	- .0021	- .0024	+ .0009	+ .0005	+ .0002	- .0000	- .0002	- .0002	- .0002	
	0.6	+ .1015	+ .0083	+ .0037	+ .0002	- .0023	- .0038	- .0042	+ .0017	+ .0007	- .0000	- .0005	- .0009	- .0010	- .0010	
	0.4	+ .1514	+ .0114	+ .0049	+ .0001	- .0032	- .0051	- .0057	+ .0023	+ .0008	- .0004	- .0013	- .0019	- .0021	- .0021	
	0.2	+ .1494	+ .0102	+ .0037	- .0004	- .0030	- .0043	- .0047	+ .0020	+ .0004	- .0011	- .0022	- .0029	- .0031	- .0031	
	0	+ .0304	0	+ .0004	+ .0010	+ .0016	+ .0020	+ .0021	0	+ .0020	+ .0052	+ .0081	+ .0100	+ .0107	+ .0107	
	R_x	R_y	+ .0304	+ .0309	+ .1052	+ .1563	+ .1856	+ .1950								
$a/b = 3/8$	1.0	+ .0189	+ .0066	+ .0040	+ .0008	- .0020	- .0039	- .0045	0	0	0	0	0	0	0	
	0.8	+ .0885	+ .0117	+ .0056	+ .0006	- .0031	- .0054	- .0062	+ .0023	+ .0012	+ .0004	- .0002	- .0005	- .0007	- .0007	
	0.6	+ .1541	+ .0176	+ .0075	+ .0001	- .0049	- .0079	- .0088	+ .0035	+ .0013	- .0006	- .0020	- .0029	- .0032	- .0032	
	0.4	+ .2107	+ .0208	+ .0079	- .0007	- .0061	- .0090	- .0099	+ .0042	+ .0009	- .0019	- .0042	- .0056	- .0061	- .0061	
	0.2	+ .1691	+ .0145	+ .0045	- .0012	- .0042	- .0057	- .0061	+ .0029	+ .0001	- .0022	- .0039	- .0048	- .0051	- .0051	
	0	+ .0102	0	+ .0008	+ .0020	+ .0030	+ .0038	+ .0040	0	+ .0039	+ .0099	+ .0152	+ .0188	+ .0200	+ .0200	
	R_x	R_y	+ .0102	+ .0474	+ .1488	+ .2154	+ .2526	+ .2645								
$a/b = 1/2$	1.0	+ .0326	+ .0151	+ .0088	+ .0015	- .0046	- .0084	- .0097	0	0	0	0	0	0	0	
	0.8	+ .1315	+ .0216	+ .0099	+ .0007	- .0059	- .0099	- .0112	+ .0043	+ .0020	+ .0002	- .0011	- .0019	- .0022	- .0022	
	0.6	+ .1972	+ .0273	+ .0108	- .0005	- .0079	- .0119	- .0132	+ .0055	+ .0015	- .0020	- .0047	- .0064	- .0070	- .0070	
	0.4	+ .2421	+ .0277	+ .0092	- .0019	- .0082	- .0115	- .0125	+ .0055	+ .0004	- .0042	- .0076	- .0097	- .0104	- .0104	
	0.2	+ .1607	+ .0160	+ .0041	- .0017	- .0044	- .0055	- .0058	+ .0032	- .0002	- .0026	- .0039	- .0044	- .0046	- .0046	
	0	- .0045	0	+ .0014	+ .0033	+ .0050	+ .0061	+ .0065	0	+ .0068	+ .0167	+ .0252	+ .0307	+ .0325	+ .0325	
	R_x	R_y	- .0045	+ .0744	+ .1942	+ .2699	+ .3108	+ .3236								
$a/b = 3/4$	1.0	+ .1061	+ .0406	+ .0196	+ .0013	- .0115	- .0190	- .0214	0	0	0	0	0	0	0	
	0.8	+ .2077	+ .0433	+ .0177	- .0003	- .0119	- .0184	- .0205	+ .0087	+ .0031	- .0012	- .0042	- .0061	- .0067	- .0067	
	0.6	+ .2408	+ .0426	+ .0145	- .0026	- .0124	- .0174	- .0189	+ .0085	+ .0010	- .0055	- .0102	- .0130	- .0139	- .0139	
	0.4	+ .2542	+ .0349	+ .0091	- .0039	- .0102	- .0130	- .0138	+ .0070	- .0011	- .0075	- .0115	- .0137	- .0143	- .0143	
	0.2	+ .1337	+ .0163	+ .0031	- .0017	- .0031	- .0033	- .0033	+ .0033	+ .0001	- .0000	+ .0014	+ .0029	+ .0035	+ .0035	
	0	- .0196	0	+ .0028	+ .0064	+ .0093	+ .0111	+ .0117	0	+ .0139	+ .0320	+ .0465	+ .0554	+ .0584	+ .0584	
	R_x	R_y	- .0196	+ .1256	+ .2666	+ .3496	+ .3923	+ .4055								
$a/b = 1$	1.0	+ .1985	+ .0644	+ .0253	- .0013	- .0172	- .0252	- .0276	0	0	0	0	0	0	0	
	0.8	+ .2564	+ .0601	+ .0210	- .0028	- .0161	- .0226	- .0245	+ .0120	+ .0034	- .0026	- .0065	- .0088	- .0095	- .0095	
	0.6	+ .2485	+ .0515	+ .0149	- .0047	- .0145	- .0189	- .0201	+ .0103	+ .0003	- .0075	- .0125	- .0151	- .0159	- .0159	
	0.4	+ .2411	+ .0372	+ .0078	- .0049	- .0100	- .0118	- .0122	+ .0074	- .0021	- .0076	- .0099	- .0106	- .0107	- .0107	
	0.2	+ .1108	+ .0154	+ .0025	- .0006	- .0006	- .0000	+ .0003	+ .0031	+ .0018	+ .0060	+ .0116	+ .0160	+ .0175	+ .0175	
	0	- .0241	0	+ .0044	+ .0096	+ .0137	+ .0161	+ .0169	0	+ .0220	+ .0482	+ .0683	+ .0804	+ .0845	+ .0845	
	R_x	R_y	- .0241	+ .1691	+ .3199	+ .4038	+ .4457	+ .4584								
$a/b = 3/2$	1.0	+ .3127	+ .0857	+ .0207	- .0087	- .0199	- .0232	- .0238	0	0	0	0	0	0	0	
	0.8	+ .2929	+ .0730	+ .0158	- .0086	- .0172	- .0194	- .0198	+ .0146	+ .0023	- .0042	- .0072	- .0082	- .0085	- .0085	
	0.6	+ .2352	+ .0560	+ .0094	- .0083	- .0134	- .0142	- .0141	+ .0112	- .0013	- .0077	- .0096	- .0096	- .0094	- .0094	
	0.4	+ .2148	+ .0359	+ .0038	- .0053	- .0065	- .0057	- .0053	+ .0072	- .0021	- .0023	+ .0012	+ .0046	+ .0059	+ .0059	
	0.2	+ .0897	+ .0132	+ .0021	+ .0025	+ .0050	+ .0069	+ .0076	+ .0026	+ .0077	+ .0220	+ .0356	+ .0444	+ .0474	+ .0474	
	0	- .0204	0	+ .0079	+ .0158	+ .0212	+ .0243	+ .0252	0	+ .0396	+ .0791	+ .1062	+ .1214	+ .1262	+ .1262	
	R_x	R_y	- .0204	+ .2452	+ .3964	+ .4668	+ .4966	+ .5047								

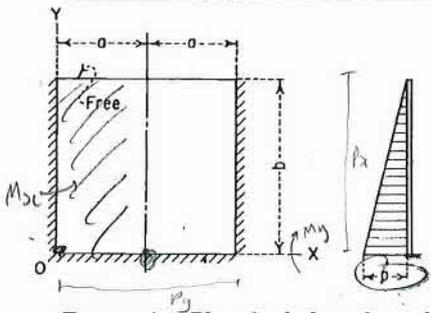

Moment = (Coefficient)(pb²)
Reaction = (Coefficient)(pb)


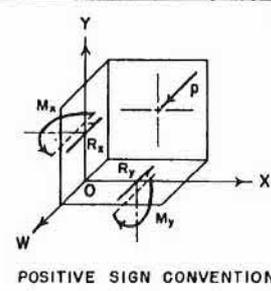



FIGURE 4.—Plate fixed along three edges, moment and reaction coefficients, Load IV, uniformly varying load.

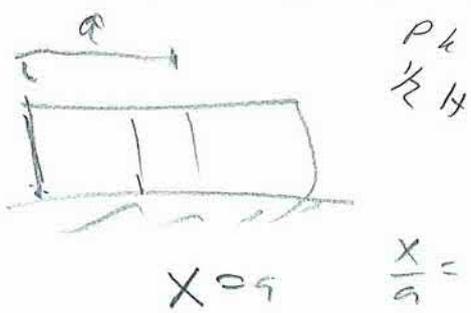


Horizontal steel RESULTS

Vertical steel

	y/b	x/a	M _x						M _y					
			0	0.2	0.4	0.6	0.8	1.0	0	0.2	0.4	0.6	0.8	1.0
a/b = 1/8	1.0	+ .1249	+ .0052	+ .0024	+ .0002	- .0014	- .0024	- .0027	0	0	0	0	0	0
	0.8	+ .1248	+ .0051	+ .0023	+ .0002	- .0014	- .0023	- .0026	+ .0010	+ .0005	+ .0000	- .0003	- .0005	- .0005
	0.6	+ .1247	+ .0052	+ .0023	+ .0002	- .0014	- .0023	- .0027	+ .0010	+ .0005	+ .0000	- .0003	- .0005	- .0005
	0.4	+ .1250	+ .0051	+ .0023	+ .0001	- .0014	- .0023	- .0027	+ .0010	+ .0005	+ .0000	- .0003	- .0005	- .0006
	0.2	+ .1185	+ .0048	+ .0021	+ .0001	- .0013	- .0021	- .0024	+ .0010	+ .0004	- .0001	- .0004	- .0006	- .0007
	0	+ .0504	0	+ .0001	+ .0003	+ .0005	+ .0006	+ .0007	0	+ .0006	+ .0016	+ .0025	+ .0031	+ .0033
	R _x	R _y	+ .0504	+ .0116	+ .0568	+ .0893	+ .1084	+ .1141						
a/b = 1/4	1.0	+ .2483	+ .0209	+ .0096	+ .0007	- .0057	- .0096	- .0109	0	0	0	0	0	0
	0.8	+ .2523	+ .0206	+ .0093	+ .0006	- .0056	- .0093	- .0105	+ .0041	+ .0019	+ .0002	- .0009	- .0016	- .0019
	0.6	+ .2513	+ .0205	+ .0093	+ .0006	- .0056	- .0093	- .0105	+ .0041	+ .0018	+ .0000	- .0013	- .0021	- .0023
	0.4	+ .2512	+ .0196	+ .0085	+ .0003	- .0054	- .0088	- .0099	+ .0039	+ .0016	- .0004	- .0018	- .0027	- .0030
	0.2	+ .1905	+ .0137	+ .0053	- .0003	- .0039	- .0059	- .0065	+ .0027	+ .0007	- .0011	- .0024	- .0032	- .0034
	0	+ .0295	0	+ .0005	+ .0013	+ .0020	+ .0025	+ .0027	0	+ .0023	+ .0063	+ .0101	+ .0126	+ .0135
	R _x	R _y	+ .0295	+ .0236	+ .1131	+ .1786	+ .2174	+ .2301						
a/b = 3/8	1.0	+ .3711	+ .0476	+ .0219	+ .0016	- .0130	- .0218	- .0247	0	0	0	0	0	0
	0.8	+ .3896	+ .0466	+ .0208	+ .0012	- .0126	- .0208	- .0235	+ .0093	+ .0042	+ .0004	- .0022	- .0038	- .0043
	0.6	+ .3757	+ .0442	+ .0193	+ .0007	- .0122	- .0198	- .0223	+ .0088	+ .0036	- .0007	- .0039	- .0059	- .0065
	0.4	+ .3541	+ .0379	+ .0155	- .0003	- .0107	- .0167	- .0186	+ .0076	+ .0024	- .0021	- .0054	- .0075	- .0082
	0.2	+ .2133	+ .0210	+ .0075	- .0009	- .0059	- .0085	- .0093	+ .0042	+ .0009	- .0017	- .0034	- .0044	- .0047
	0	- .0015	0	+ .0010	+ .0027	+ .0043	+ .0054	+ .0058	0	+ .0050	+ .0135	+ .0215	+ .0269	+ .0288
	R _x	R _y	- .0015	+ .0303	+ .1666	+ .2644	+ .3220	+ .3410						
a/b = 1/2	1.0	+ .5101	+ .0852	+ .0384	+ .0022	- .0233	- .0383	- .0432	0	0	0	0	0	0
	0.8	+ .5331	+ .0807	+ .0349	+ .0013	- .0218	- .0353	- .0397	+ .0161	+ .0068	- .0001	- .0049	- .0077	- .0086
	0.6	+ .4805	+ .0712	+ .0298	- .0000	- .0199	- .0313	- .0350	+ .0142	+ .0051	- .0026	- .0084	- .0120	- .0132
	0.4	+ .4148	+ .0545	+ .0209	- .0014	- .0156	- .0233	- .0258	+ .0109	+ .0026	- .0043	- .0094	- .0125	- .0135
	0.2	+ .1928	+ .0250	+ .0087	- .0009	- .0063	- .0089	- .0096	+ .0050	+ .0015	- .0003	- .0008	- .0008	- .0007
	0	- .0294	0	+ .0019	+ .0050	+ .0080	+ .0100	+ .0107	0	+ .0094	+ .0252	+ .0399	+ .0499	+ .0534
	R _x	R _y	- .0294	+ .0482	+ .2263	+ .3559	+ .4322	+ .4572						
a/b = 3/4	1.0	+ .8592	+ .1788	+ .0716	- .0010	- .0471	- .0726	- .0807	0	0	0	0	0	0
	0.8	+ .7864	+ .1552	+ .0607	- .0020	- .0414	- .0630	- .0698	+ .0310	+ .0112	- .0027	- .0119	- .0172	- .0190
	0.6	+ .5989	+ .1207	+ .0460	- .0033	- .0336	- .0498	- .0549	+ .0241	+ .0071	- .0067	- .0166	- .0225	- .0245
	0.4	+ .4378	+ .0786	+ .0280	- .0033	- .0214	- .0306	- .0333	+ .0157	+ .0036	- .0049	- .0100	- .0127	- .0135
	0.2	+ .1185	+ .0289	+ .0109	+ .0009	- .0034	- .0049	- .0053	+ .0058	+ .0060	+ .0115	+ .0186	+ .0241	+ .0262
	0	- .0694	0	+ .0042	+ .0115	+ .0182	+ .0227	+ .0242	0	+ .0212	+ .0576	+ .0911	+ .1135	+ .1212
	R _x	R _y	- .0694	+ .0806	+ .3383	+ .5271	+ .6368	+ .6725						
a/b = 1	1.0	+ 1.2115	+ .2613	+ .0883	- .0105	- .0654	- .0927	- .1008	0	0	0	0	0	0
	0.8	+ .9558	+ .2146	+ .0727	- .0097	- .0551	- .0774	- .0840	+ .0429	+ .0134	- .0051	- .0164	- .0224	- .0243
	0.6	+ .6250	+ .1547	+ .0525	- .0083	- .0411	- .0566	- .0611	+ .0309	+ .0090	- .0069	- .0169	- .0222	- .0238
	0.4	+ .3984	+ .0916	+ .0305	- .0043	- .0216	- .0290	- .0310	+ .0183	+ .0069	+ .0029	+ .0030	+ .0045	+ .0053
	0.2	+ .0434	+ .0303	+ .0127	+ .0047	+ .0033	+ .0042	+ .0048	+ .0061	+ .0149	+ .0339	+ .0542	+ .0689	+ .0742
	0	- .0939	0	+ .0074	+ .0199	+ .0311	+ .0384	+ .0409	0	+ .0369	+ .0996	+ .1556	+ .1919	+ .2043
	R _x	R _y	- .0939	+ .1167	+ .4453	+ .6760	+ .8043	+ .8450						
a/b = 3/2	1.0	+ 1.6267	+ .3304	+ .0700	- .0345	- .0730	- .0844	- .0865	0	0	0	0	0	0
	0.8	+ 1.0875	+ .2609	+ .0565	- .0286	- .0589	- .0670	- .0683	+ .0522	+ .0116	- .0069	- .0143	- .0165	- .0169
	0.6	+ .5876	+ .1778	+ .0399	- .0195	- .0385	- .0422	- .0422	+ .0356	+ .0115	+ .0017	+ .0011	+ .0035	+ .0049
	0.4	+ .3166	+ .0981	+ .0239	- .0056	- .0116	- .0101	- .0090	+ .0196	+ .0177	+ .0315	+ .0495	+ .0634	+ .0685
	0.2	- .0540	+ .0302	+ .0140	+ .0140	+ .0211	+ .0273	+ .0296	+ .0060	+ .0389	+ .0912	+ .1388	+ .1699	+ .1805
	0	- .1168	0	+ .0159	+ .0388	+ .0565	+ .0668	+ .0702	0	+ .0796	+ .1939	+ .2823	+ .3340	+ .3508
	R _x	R _y	- .1168	+ .2429	+ .6510	+ .8793	+ .9832	+ 1.0123						

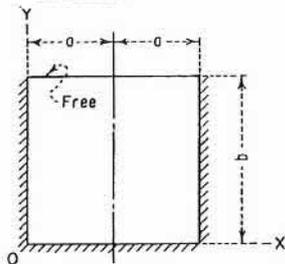

Moment = (Coefficient) (pb²)
Reaction = (Coefficient) (pb)

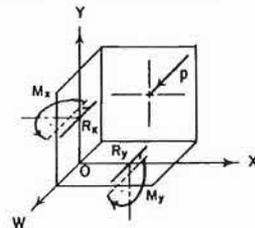

POSITIVE SIGN CONVENTION

FIGURE 1.—Plate fixed along three edges, moment and reaction coefficients, Load I, uniform load.

Sheet 25
Date: 27/07/20

	CALCULATIONS	PROJECT No / Ref 1-14129.07 / 00001
	OFFICE Christchurch	PROJECT TITLE Mangawhai CWWTP Balance Tank Concept Design Walls 1-3 4-5
SUBJECT SLS Crack Control - Walls 4-5		SHEET No 1 OF 1

Calculations to NZS3101 Cl. 2.4.4.6 Assessment of surface crack widths

Limit =	0.2 mm	Specified crack width limit	AS/NZS 3101	Table C2.1
Thickness =	350 mm	Overall thickness of concrete		
Cover =	66 mm	Cover to main steel		
Bar =	20 mm diam	Main steel diameter		
Spacing =	100 mm	Main steel spacing		
F'c =	50 Mpa	Concrete strength		
ρ =	2450 kg/m ³	Concrete density	AS/NZS 3101	Cl. 5.2.2
Ec =	37 Gpa	Concrete Modulus of Elasticity	AS/NZS 3101	Eq. 5-1
Es =	200 Gpa	Steel Modulus of Elasticity	AS/NZS 3101	Cl. 5.3.4
b =	1000 mm	Width of section		
M* _{SLS} =	88.67 kNm	SLS moment demand		

Follows the example provided by SCNZ for "Durability of Composite Decks Exposed to Surface Water" dated 7 Nov. 2008
Available Here: https://www.scnz.org/site/scnz/images/advisor_doc/CMP1003.pdf

d =		274 mm	Distance to centroid main steel
n =	$\frac{E_s}{E_c}$	5.47	Standard flexural theory
A _s =		3142	Area of steel
ρ =	$\frac{A_s}{bd}$	0.0115	Reinforcement ratio
ρn =	ρ × n	0.0628	
k =	$\sqrt{\rho n^2 + 2\rho n} - \rho n$	0.297	
kd =	k × d	81.4 mm	Depth of Neutral Axis
j =	$1 - \frac{k}{3}$	0.901	
f _s =	$\frac{M^*}{A_s j d}$	114 Mpa	
β' =	$\frac{y - kd}{d - kd}$	1.39	AS/NZS 3101 Eq. 2-8
g _s =	$\sqrt{\left(\frac{s}{2}\right)^2 + C_m^2}$	91 mm	AS/NZS 3101 Eq. 2-9
w =	$2\beta' \frac{f_s}{g_s} E_s$	0.145 mm	AS/NZS 3101 Eq. 2-7

Overall OK

		CALCULATIONS	PROJECT No / Ref 1-14129.07 / 00001
OFFICE Christchurch		PROJECT TITLE Mangawhai CWWTP Balance Tank Concept Design Walls 4-5	
SUBJECT SLS Crack Control - Walls 4-5 - Horizontal Steel			SHEET No 1 OF 1

Calculations to NZS3101 Cl. 2.4.4.6 Assessment of surface crack widths

Limit =	0.2	mm	Specified crack width limit	AS/NZS 3101	Table C2.1
Thickness =	350	mm	Overall thickness of concrete		
Cover =	50	mm	Cover to main steel		
Bar =	16	mm diam	Main steel diameter		
Spacing =	175	mm	Main steel spacing		
F'c =	50	Mpa	Concrete strength		
ρ =	2450	kg/m ³	Concrete density	AS/NZS 3101	Cl. 5.2.2
E _c =	37	Gpa	Concrete Modulus of Elasticity	AS/NZS 3101	Eq. 5-1
E _s =	200	Gpa	Steel Modulus of Elasticity	AS/NZS 3101	Cl. 5.3.4
b =	1000	mm	Width of section		
M* _{SLS} =	17.76	kNm	SLS moment demand		

Follows the example provided by SCNZ for "Durability of Composite Decks Exposed to Surface Water" dated 7 Nov. 2008

Available Here: https://www.scnz.org/site/scnz/images/advisor_doc/CMP1003.pdf

d =		292	mm	Distance to centroid main steel
n =	$\frac{E_s}{E_c}$	5.47		Standard flexural theory
A _s =		1149		Area of steel
ρ =	$\frac{A_s}{bd}$	0.0039		Reinforcement ratio
ρn =	ρ × n	0.0215		
k =	$\sqrt{\rho n^2 + 2\rho n} - \rho n$	0.187		
kd =	k × d	54.6	mm	Depth of Neutral Axis
j =	$1 - \frac{k}{3}$	0.938		
f _s =	$\frac{M^*}{A_s j d}$	56	Mpa	
β' =	$\frac{y - kd}{d - kd}$	1.24		AS/NZS 3101 Eq. 2-8
g _s =	$\sqrt{\left(\frac{\beta'}{2}\right)^2 + C_m^2}$	105	mm	AS/NZS 3101 Eq. 2-9
w =	$2\beta' \frac{f_s}{g_s} E_s$	0.074	mm	AS/NZS 3101 Eq. 2-7

Overall OK

CALCULATION SHEET

Project/Task/File No: 1-13586.001

Sheet No 25 of

Project Description: Mungahai Balance Tank
- Concept Design - starter length check.

Office: CHCN

Computed: 27/07/20

Check: / /

→ Need to check how far up walls 1-3 the 25mm starter bars are needed to keep crack widths $< 0.2 \text{ mm}$


→ Using 3101 s/s and goal seek function, estimating the maximum M we can have for $w < 0.2$

When $w = 0.2$, $M^*_{SLS} = 185 \text{ kNm}$

$e f_s = 172 \text{ MPa}$

⇒ Need to work out at what height up the walls the demand = 185 kNm

→ Conservatively assume the BMD is triangular rather than quadratic

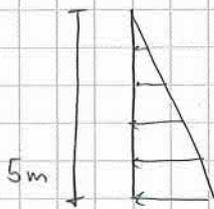

$y = mx + c$ $m = \frac{223}{5} = 44.6$

$y = 44.6x$

$\Rightarrow 185 = 44.6x$

$\Rightarrow x = 4.15 \text{ m}$

⇒ up the wall 0.85 m

⇒ length of starters = $0.85 \text{ m} + \text{development length} + \text{thickness of wall}$

$L_{db} = \frac{0.5 \times \alpha_f f_y}{\sqrt{f'_c}} d_b$

$\alpha_f = 1$ $f_y = 500 \text{ MPa}$ $f'_c = 50 \text{ MPa}$

$d_b = 25 \text{ mm}$

$= \frac{0.5 \times 1 \times 500 \text{ MPa}}{\sqrt{50}} \times 25$

$= 883.88 \text{ mm} = 885 \text{ mm}$

Base slab check. HD16 EWEF

⇒ w/ 0.2 mm crack width

limit $p_{pmm} \% = 0.47$

$p_{pmin} = 0.0049$

$= 0.49\% \checkmark$

⇒ total length of starters = $0.85 \text{ m} + 0.885 \text{ m} + 0.45 \text{ m}$

$= 2.185$

$\hat{=} 2.2 \text{ m}$

$L_{dc} \text{ for } 20 \text{ mm} = \frac{0.5 \times 1 \times 500}{\sqrt{50}} \times 20 = 707.1 \text{ mm} \Rightarrow 710 \text{ mm}$



		CALCULATIONS	PROJECT No / Ref 1-14129.07 / 00001
OFFICE Christchurch		PROJECT TITLE Mangawhai CWWTP Balance Tank Concept Design Walls 1-3	
SUBJECT SLS Crack Control - Walls 1-3			SHEET No 1 OF 1

Calculations to NZS3101 Cl. 2.4.4.6 Assessment of surface crack widths

Limit =	0.2 mm	Specified crack width limit	AS/NZS 3101	Table C2.1
Thickness =	450 mm	Overall thickness of concrete		
Cover =	66 mm	Cover to main steel		
Bar =	20 mm diam	Main steel diameter		
Spacing =	100 mm	Main steel spacing		
F'c =	50 Mpa	Concrete strength		
ρ =	2450 kg/m ³	Concrete density	AS/NZS 3101	Cl. 5.2.2
E _c =	37 Gpa	Concrete Modulus of Elasticity	AS/NZS 3101	Eq. 5-1
E _s =	200 Gpa	Steel Modulus of Elasticity	AS/NZS 3101	Cl. 5.3.4
b =	1000 mm	Width of section		
M* _{SLS} =	185.0056666 kNm	SLS moment demand		

Follows the example provided by SCNZ for "Durability of Composite Decks Exposed to Surface Water" dated 7 Nov. 2008

Available Here: https://www.scnz.org/site/scnz/images/advisor_doc/CMP1003.pdf

d =		374 mm	Distance to centroid main steel
n =	$\frac{E_s}{E_c}$	5.47	Standard flexural theory
A _s =		3142	Area of steel
ρ =	$\frac{A_s}{bd}$	0.0084	Reinforcement ratio
pn =	$\rho \times n$	0.0460	
k =	$\sqrt{\rho n^2 + 2\rho n} - \rho n$	0.261	
kd =	$k \times d$	97.5 mm	Depth of Neutral Axis
j =	$1 - \frac{k}{3}$	0.913	
f _s =	$\frac{M^*}{A_s j d}$	172 Mpa	
β' =	$\frac{y - kd}{d - kd}$	1.27	AS/NZS 3101 Eq. 2-8
g _s =	$\sqrt{\left(\frac{s}{2}\right)^2 + C_m^2}$	91 mm	AS/NZS 3101 Eq. 2-9
w =	$2\beta' \frac{f_s}{g_s} E_s$	0.200 mm	AS/NZS 3101 Eq. 2-7

Overall Not OK

CALCULATION SHEET

Project/Task/File No: 1-13586.001


Sheet No 2 of

Project Description: Mangawhai Balana Tank
- Concept Design - Sketch.


Office: CHC

Computed: 27/07/20


Check: / /

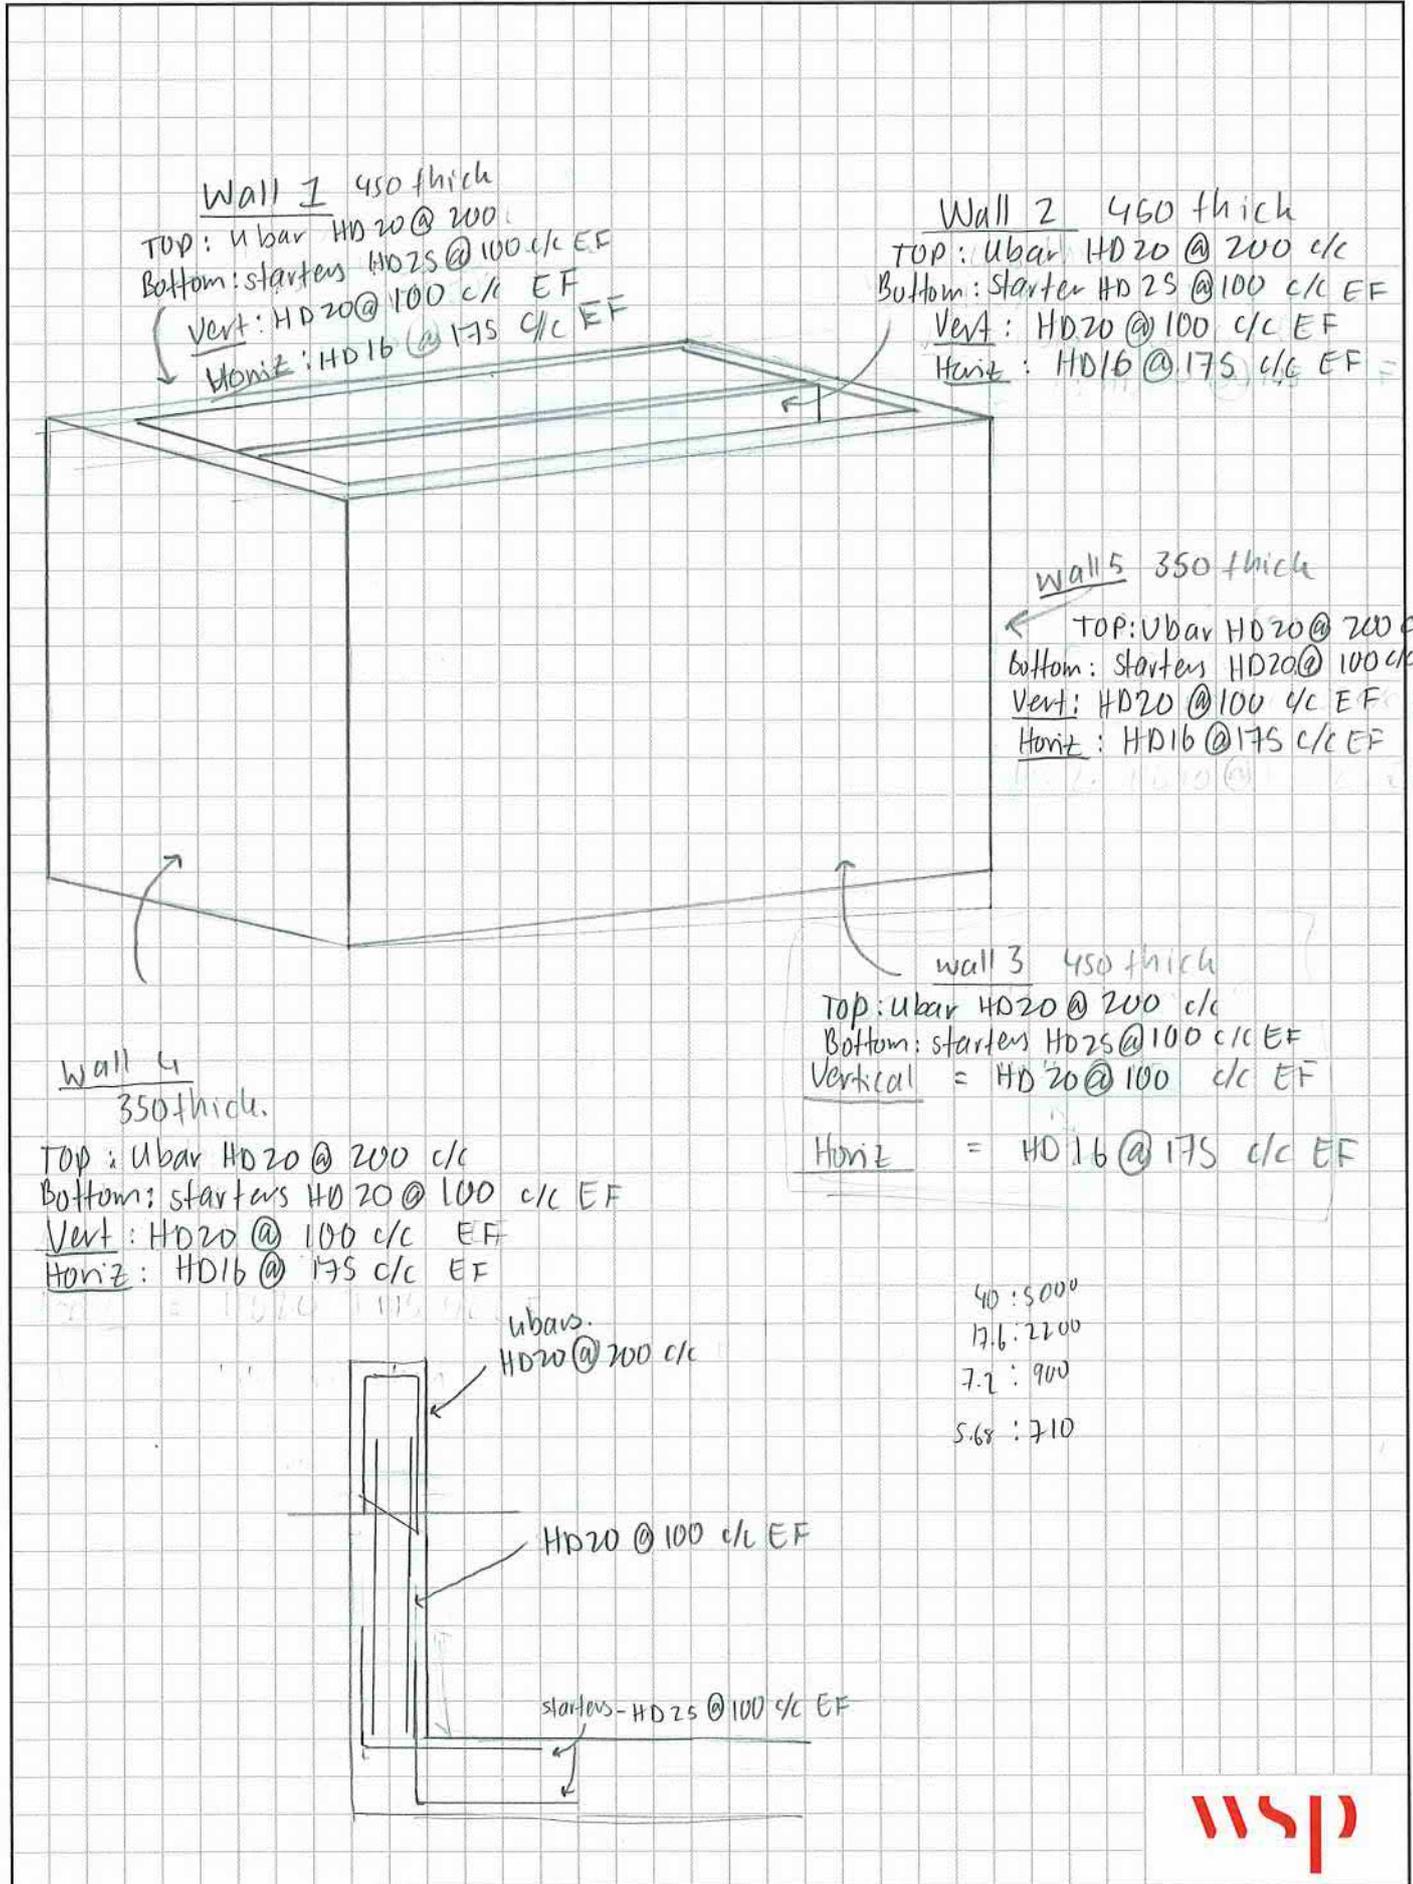

Note - 17/09/2020 -
Tank reduced to single tank post-calculation

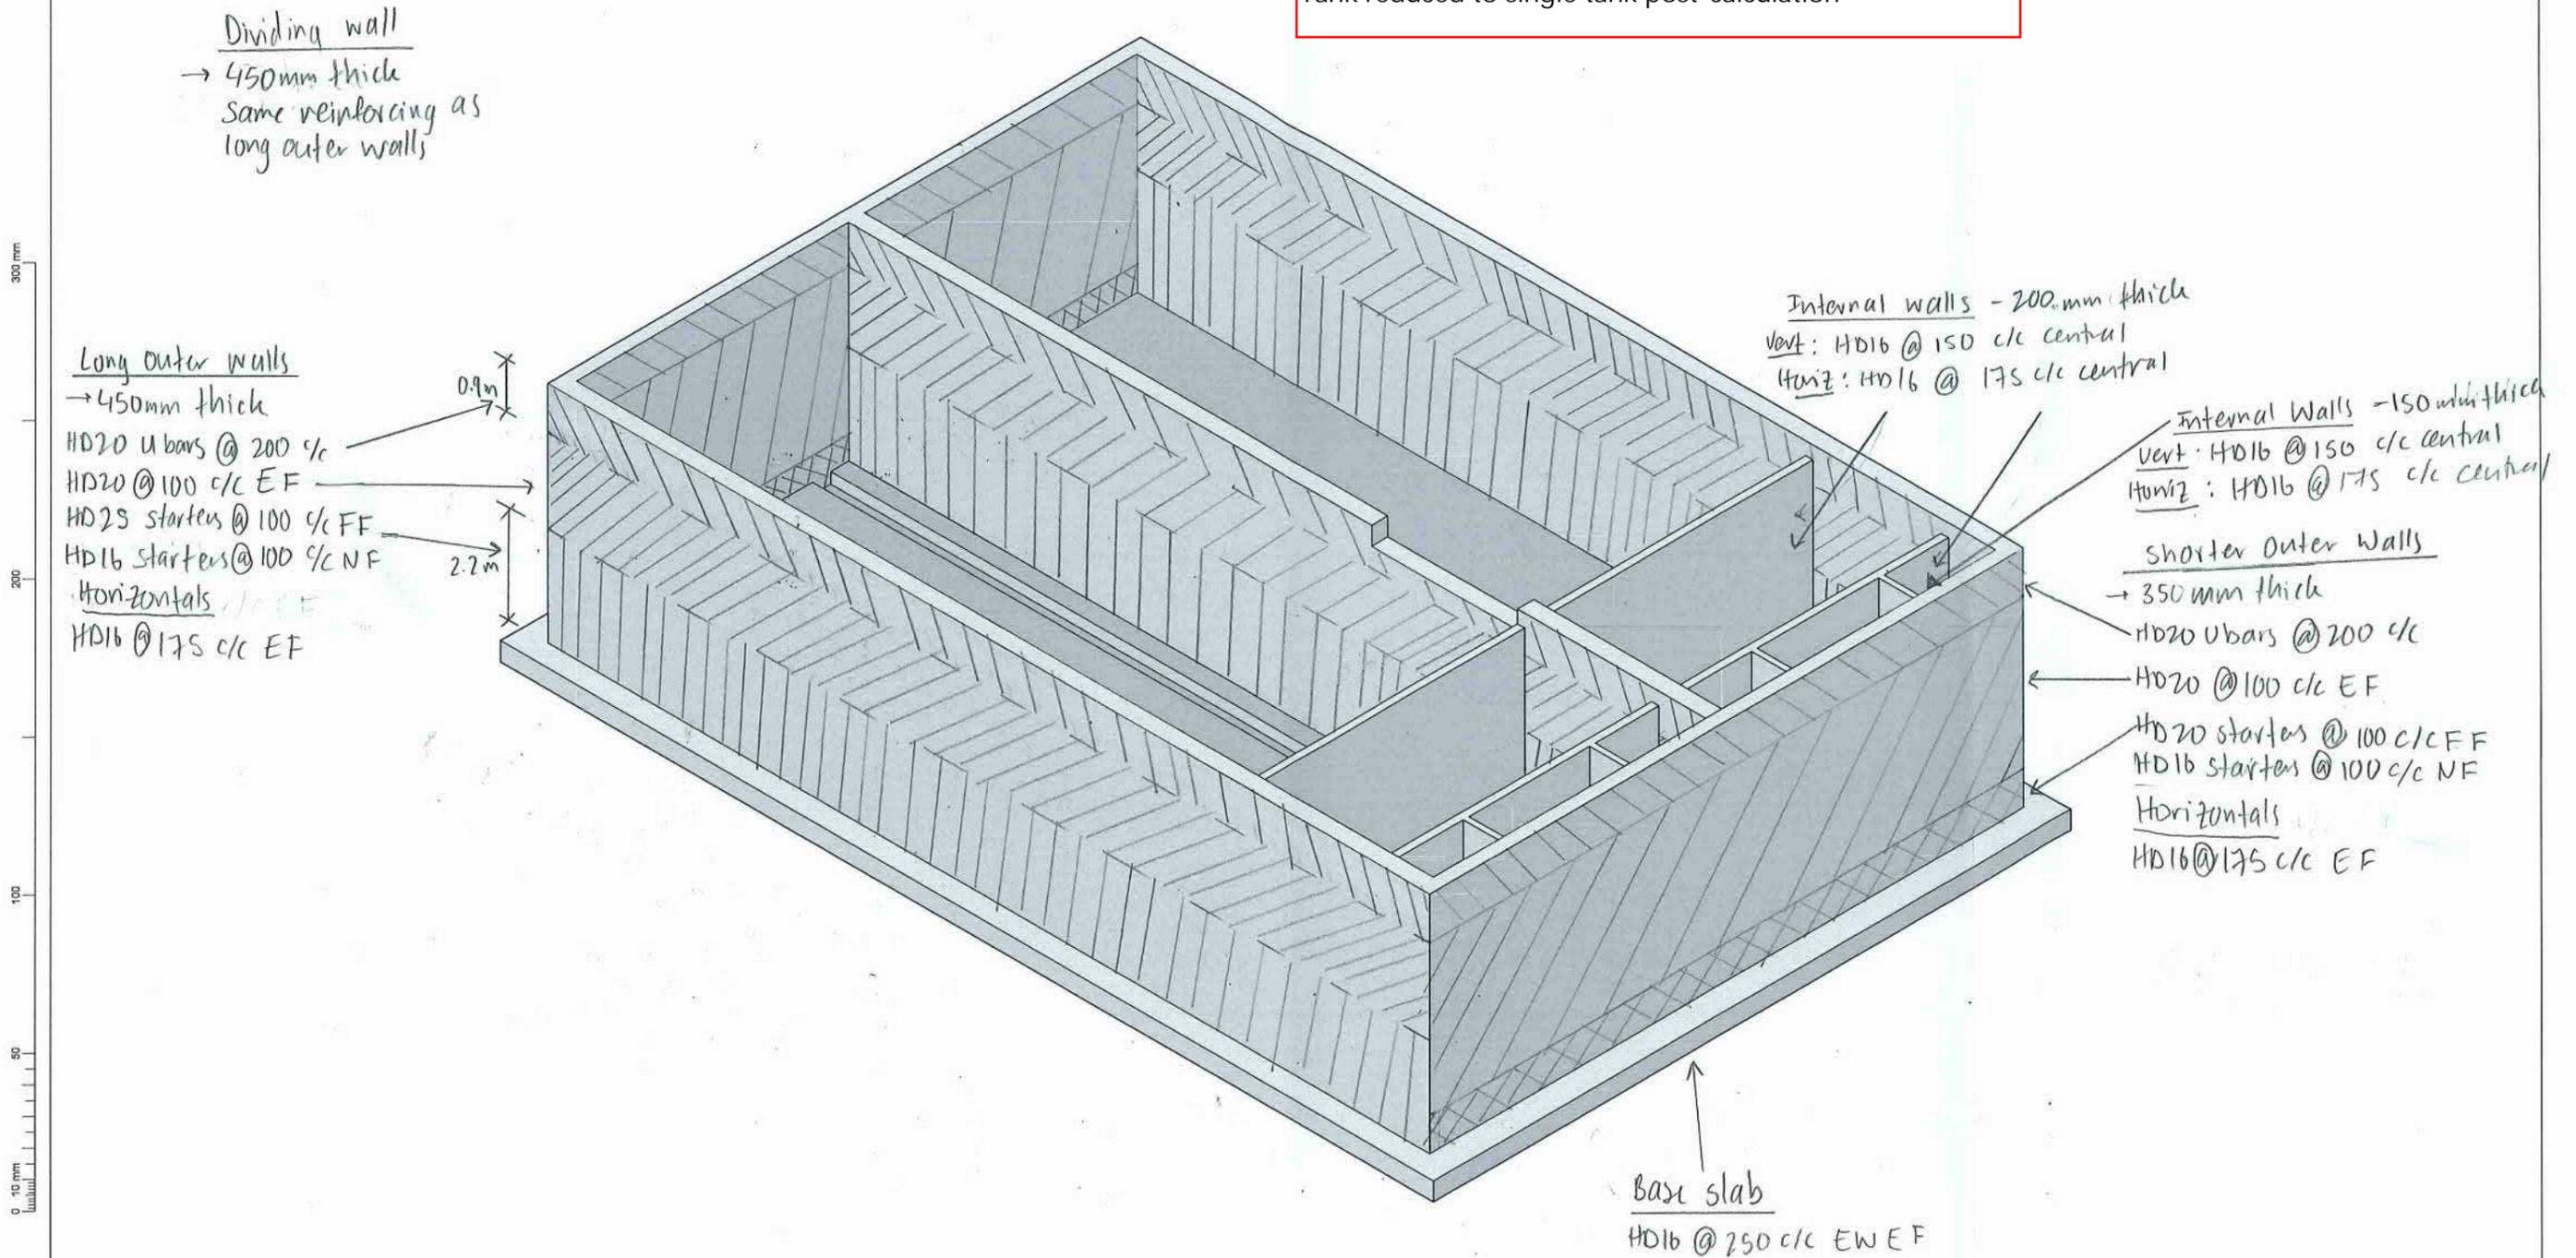

BALANCE TANK - ISOMETRIC VIEW
SCALE: 1:75

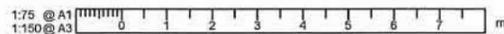

REVISION	AMENDMENT	APPROVED	DATE
A	DRAFT FOR DISCUSSION	L.T.	2020-07-27



Christchurch Office
+64 3 353 5400


PO Box 1482
Christchurch 8140
New Zealand

STRUCTURAL

SCALES	ORIGINAL SIZE
1:75	A1
DRAWN K. HEWSON	DESIGNED J. GALE
DESIGN VERIFIED S. ADAMS	APPROVED L. THOMAS
VERIFIER	APPROVED DATE 2020-07-27


DRAFT FOR DISCUSSION

PROJECT	TITLE	WSP PROJECT NO. (SUB-PROJECT)	SHEET NO.	REVISION
MANGAWHAI ECOCARE MANGAWHAI INFRASTRUCTURE PROJECT TREATMENT PLANT	BALANCE TANK ISOMETRIC VIEW	1-13586.00	SK001	A

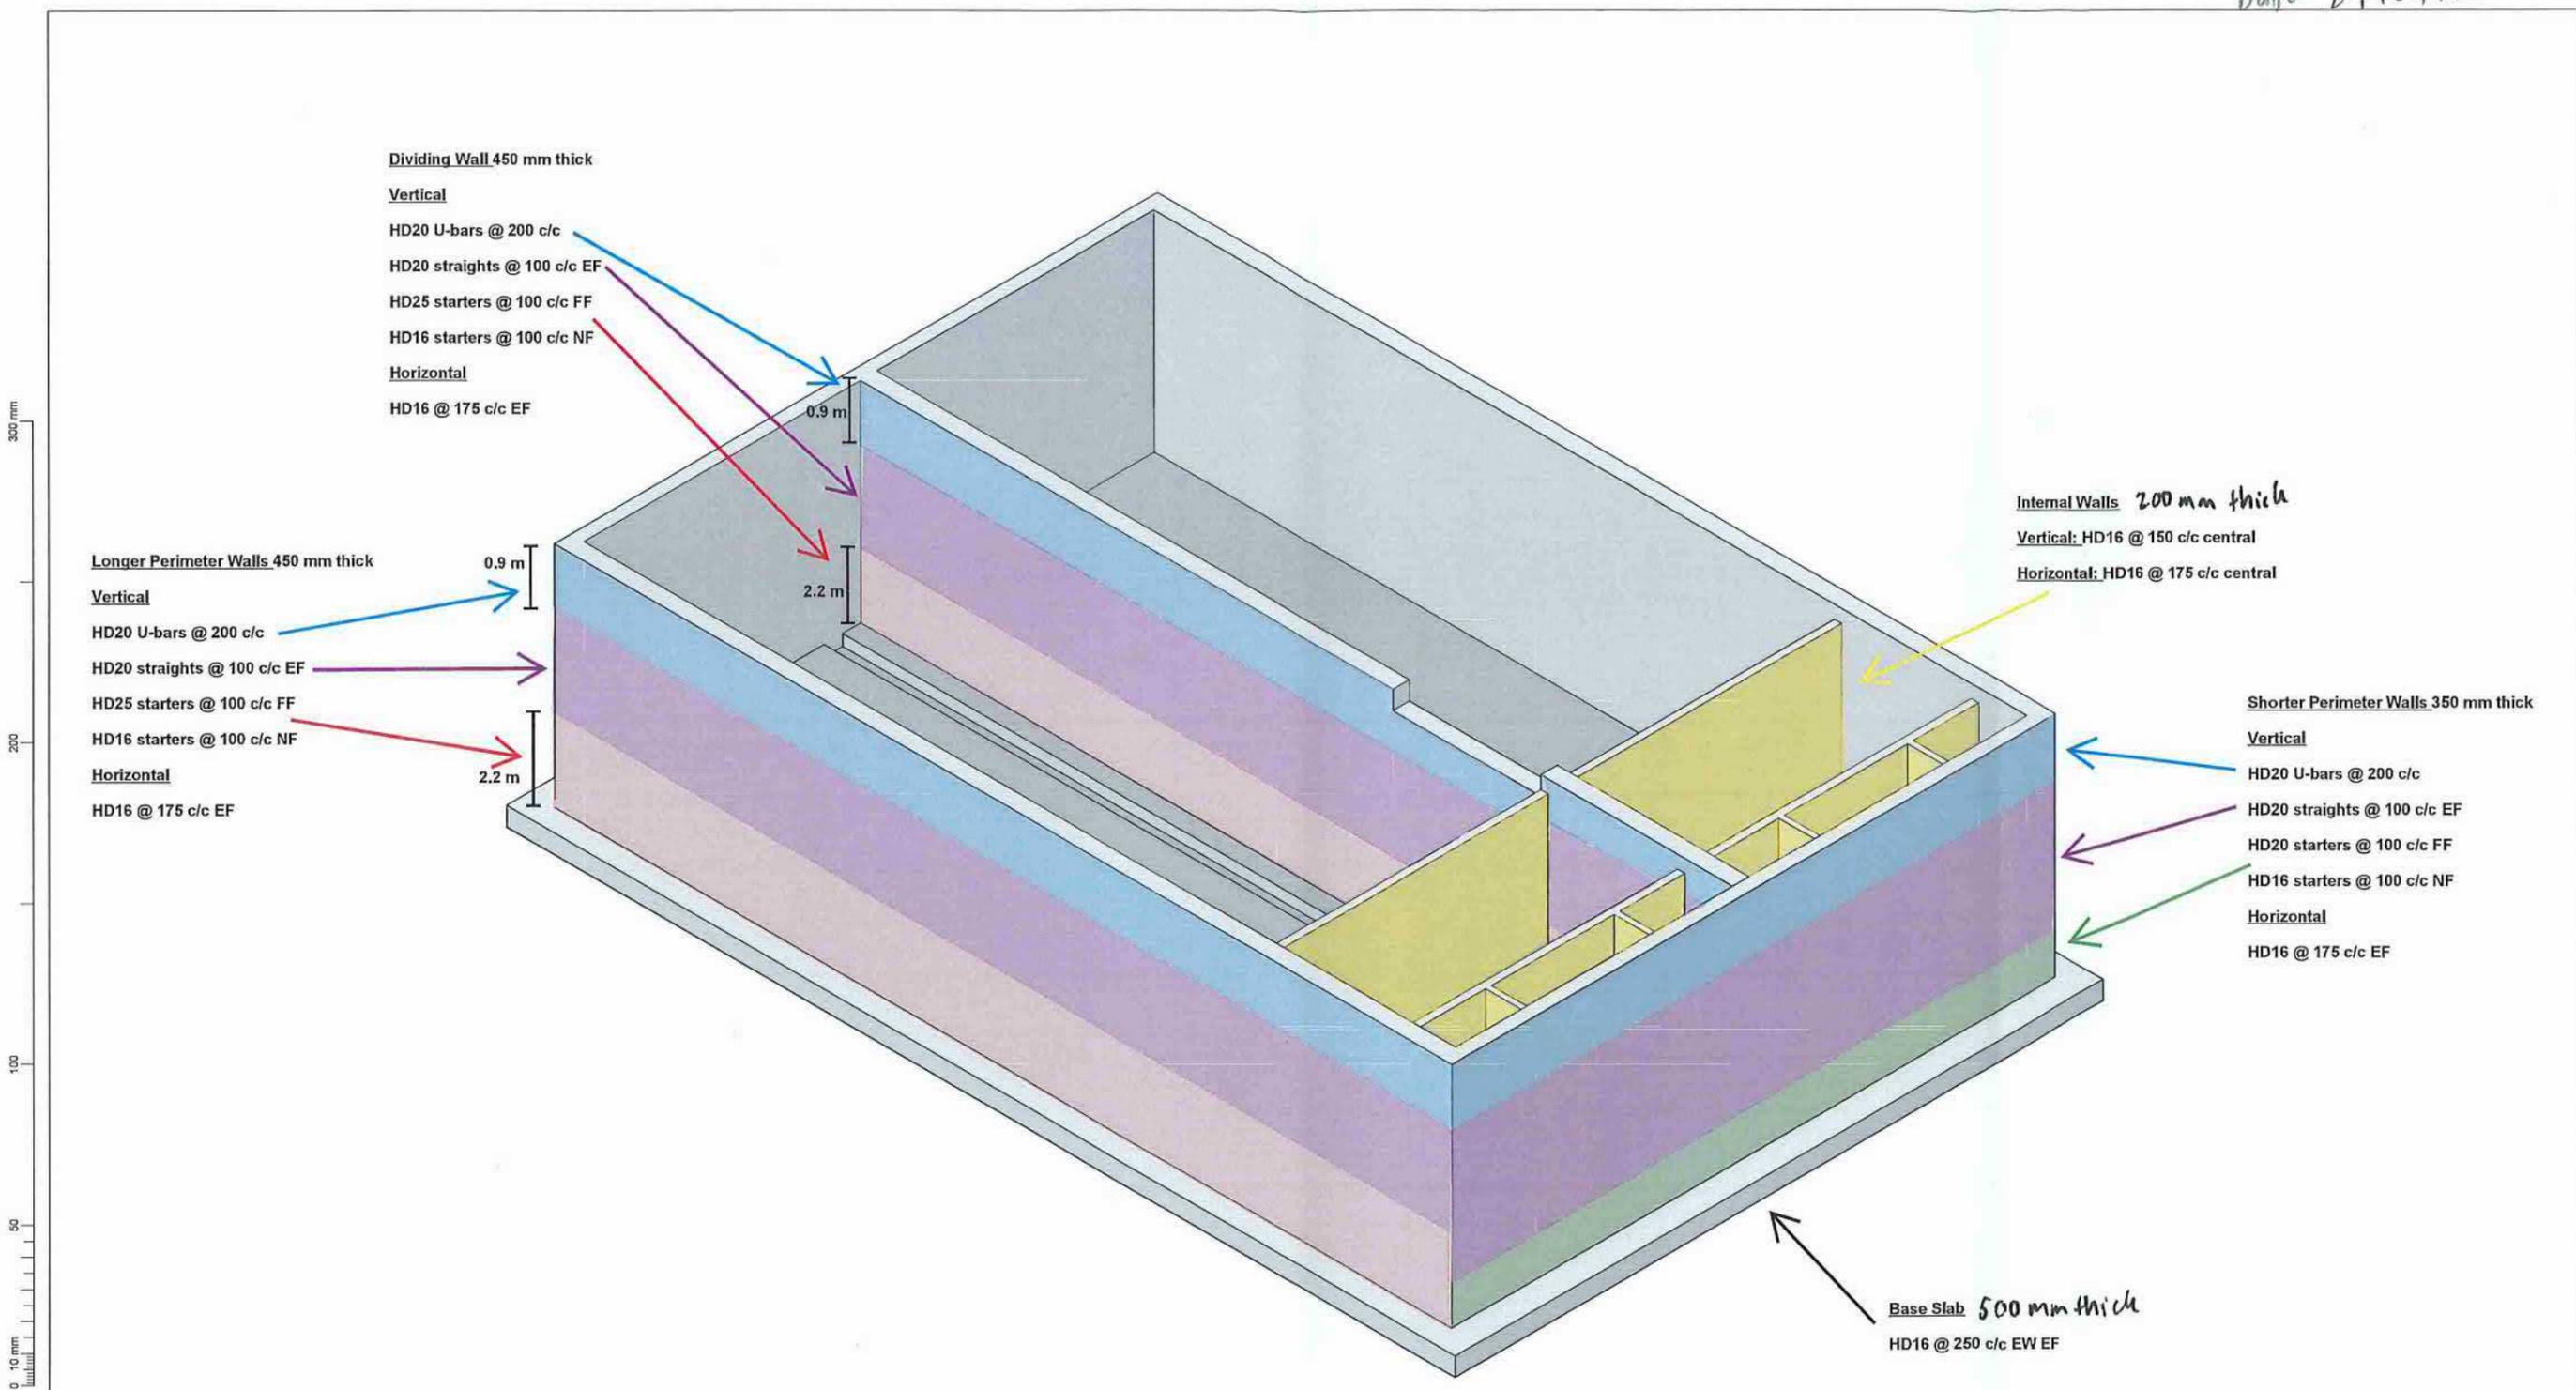

BALANCE TANK - ISOMETRIC VIEW
SCALE: 1:75

ORIGINAL DRAWING IN COLOUR

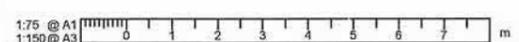

REVISION	AMENDMENT	APPROVED	DATE
A	DRAFT FOR DISCUSSION	L.T.	2020-07-27



STRUCTURAL

SCALES	DESIGNED	APPROVED
1:75	J. GALE	L. THOMAS
DRAWN	DESIGN VERIFIED	APPROVED DATE
K. HEWSON	S. ADAMS	2020-07-27
VERIFIER		

DRAFT FOR DISCUSSION

PROJECT	TITLE	WSP PROJECT NO. (SUB-PROJECT)	SHEET NO.	REVISION
MANGAWHAI ECOCARE MANGAWHAI INFRASTRUCTURE PROJECT TREATMENT PLANT	BALANCE TANK ISOMETRIC VIEW	1-13586.00	SK001	A

Appendix F

Rough Order of Cost

Mangawhai Wastewater Plant

17/09/2020

Andrew Springer

Rev 1

Item	Description	Unit	Quantity	Rate	Total
1	Preliminary and General				\$ 275,156.83
1.1	P&G	Ls	20%	\$ 1,350,784.13	\$ 270,156.83
1.2	Quality plan	Ls	1	\$ 5,000.00	\$ 5,000.00
2	Earthworks and Clearing				\$ 82,470.00
2.1	Cut to waste for balance tank including both access platform and return pump	m3	260	\$ 45.00	\$ 11,700.00
2.2	Cut to waste for elevated screen and flow split base slab	m3	64	\$ 45.00	\$ 2,880.00
2.3	Cut to waste for odour control base slab	m3	10	\$ 45.00	\$ 450.00
2.4	Import and fill with river sand For all concrete slab bedding (0.5m)	m3	167	\$ 250.00	\$ 41,750.00
2.5	supply and lay 500mm thick crusher rock	m2	167	\$ 70.00	\$ 11,690.00
2.6	Cut to waste - slope cut back	m2	200	\$ 70.00	\$ 14,000.00
3	Drainage				\$ 16,550.00
3.1	Supply and install closed top concrete drain (400mm)	m	48	\$ 20.00	\$ 960.00
3.2	Cut to waste for concrete drain (0.5m deep)	m3	12	\$ 45.00	\$ 540.00
3.3	Supply and lay 50mm clear river sand for concrete pipe bedding	m3	2	\$ 250.00	\$ 500.00
3.4	Supply and install (675x 450) catchpit	No.	1	\$ 3,300.00	\$ 3,300.00
3.5	Supply and install 1050 MH	No.	1	\$ 11,250.00	\$ 11,250.00
4	Structures				\$ 912,076.00
4.1	Concrete Slabs				\$ 69,150.00
4.1.1	Concrete base slab for new balance tank (200mm thick) 25MPa	m3	51	\$ 875.00	\$ 44,625.00
4.1.2	Concrete base slab for return pump (200mm thick) 20MPa	m3	2	\$ 850.00	\$ 1,700.00
4.1.3	Concrete base slab for access platform (200mm thick) 20MPa	m3	3	\$ 850.00	\$ 2,550.00
4.1.4	Concrete base slab for elevated screen and flow split (200mm thick) 25MPa	m3	3	\$ 875.00	\$ 2,625.00
4.1.5	Concrete base slab for odour control (200mm thick) 20MPa	m3	1	\$ 850.00	\$ 850.00
4.1.6	Total rebar in concrete slabs 10% of concrete	kg	6000	\$ 2.80	\$ 16,800.00
4.2	Balance Tank				\$ 185,280.00
4.2.1	Supply and install cast insitu concrete walls 350mm thick at 5.65m high (25MPa)	m2	155	\$ 900.00	\$ 139,500.00
4.2.2	Supply and install cast insitu concrete walls 150mm thick at 5.65m high	m2	35	\$ 900.00	\$ 31,500.00
4.2.3	Total rebar in balance tank 10% of concrete - already in precast panels	kg	5100	\$ 2.80	\$ 14,280.00
4.3	Access platform				\$ 30,000.00
4.3.1	stair case with two (2 x 2m) platforms (total rise of 5.65m)	LS	1	\$ 23,000.00	\$ 23,000.00
4.3.2	Supply and install handrail on both sides running full length of stairs	m	14	\$ 500.00	\$ 7,000.00
4.4	Return pump				\$ 1,020.00
4.4.1	supply and install concrete plinth for pumps with access hatch (2 x 3 x 1.5 @ 150mm thick) 20 Mpa inc rebar and formwork	m3	1	\$ 1,020.00	\$ 1,020.00
4.5	Elevated screen and flow split				\$ 611,606.00
4.5.1	Supply and install 6 x concrete footings @ 1m3 each	m3	6	\$ 850.00	\$ 5,100.00
4.5.2	Supply and install base I columns (4m high) bolted to footings (fittings inc) 380 PFC (380 x 150)	m	24	\$ 4,704.00	\$ 112,896.00
4.5.3	Supply and install cross members (5m long) (fittings inc) (75 x 75 x 8mm)	m	30	\$ 945.00	\$ 28,350.00
4.5.4	Supply and install I beams (fitting inc) 380 PFC (380 x 150)	m	30	\$ 6,076.00	\$ 182,280.00
4.5.5	Supply and install I column extension (1.5m high) (fittings inc) 380 PFC (380 x 150)	m	12	\$ 3,528.00	\$ 42,336.00
4.5.6	Supply and install cross members (2m long) (fittings inc)	m	24	\$ 756.00	\$ 18,144.00
4.5.7	Supply and install I beams for top platform 380 PFC (380 x 150)	m	20	\$ 9,800.00	\$ 196,000.00
4.5.8	Supply and install mesh plating at to of platform (expanded mesh)	m2	25	\$ 540.00	\$ 13,500.00
4.5.9	Supply and install handrail (fittings inc)	m	26	\$ 500.00	\$ 13,000.00
4.6	Odour control - carbon filter				\$ 15,020.00
4.6.1	supply and install concrete surround for filters (2 x 3 x 1.5 @ 150mm thick) 20 Mpa inc rebar and formwork	m3	1	\$ 1,020.00	\$ 1,020.00
4.6.2	Odour Filter	ls	1	\$14,000	\$ 14,000.00
5	Landscaping & Entrances				\$ 15,750.00
5.1	supply and install safety fence	m	50	\$ 265.00	\$ 13,250.00
5.2	supply and install safety fence human gateway	m	1	\$ 2,500.00	\$ 2,500.00
6	Piping, Pumps and Filtration				\$ 144,338.13
6.1	Supply and install 316 SS 300mm pipework inc fittings, brackets, flanges, 90 deg angles and tees	kg	3700	\$ 9.75	\$ 36,075.00
6.2	Supply and install 316 SS 600mm pipework inc fittings, brackets and flanges and 90deg angle	kg	0	\$ 9.75	\$ -
6.3	Supply and install 316 SS 600mm to 500mm reducers	No.	2	\$ 1,300.00	\$ 2,600.00
6.4	Supply and install 316 SS 500mm pipework inc fittings, brackets and flanges	kg	297.5	\$ 9.75	\$ 2,900.63
6.5	Supply and install 5kw pumps	No.	2	\$ 25,000.00	\$ 50,000.00
6.6	Supply and install Fittings	No.	1	\$ 20,325.00	\$ 20,325.00
6.7	Valves, fittings bends 100mm	LS	1	\$ 30,000.00	\$ 30,000.00
6.8	Pipework 100mm	kg	250	\$ 9.75	\$ 2,437.50

Appendix G

Risk Register



Risk Register

Project Name: Mangawhai Balance Tank

Project Number:1-1492.07

Client: Kaipara DC

Prepared by: A Springer (revised by Eros Foschieri)

Version 2

Updated: 17 September 2020

	Risk	Description	Party with Risk	Avoid/Mitigate/Manage	Action	Risk Potential \$	Owner
1	Commercial	Project cost exceeds annual budget	KDC	Manage	WSP have undertaken a review of the option, concept level design and cost estimate. Cost estimate of \$1.9 m plus 15% contingency is identified. - In Budget.	\$272k (contingency)	KDC
2	Commercial	Project cost increases	KDC	Manage	Periodic review of project. Identify and agree changes. Request additional funding if needed.		KDC
3	Technical	Geotechnical requirement changes compare to 2007 survey	KDC	Mitigate	Undertaken targeted Geotech investigation. Confirm locations of construction.		WSP to do survey
4	Technical	Bank Stability- The stability of the bank is assumed as outside of previous survey. Risk of increased measures to maintain stable bank.	KDC	Mitigate	Include bank in geotech surveys. Identify risks.		WSP to include in survey
5	Constructability	Screen relocation. It is assumed that the existing screen can be relocated in a 4-6 hour window of no flow to works. If this is not possible, an additional screen	KDC	Mitigate	Plan screen move with contractor. Prepare contingency to enable come back later	\$60k	KDC - Assess in design

wsp

wsp.com/nz